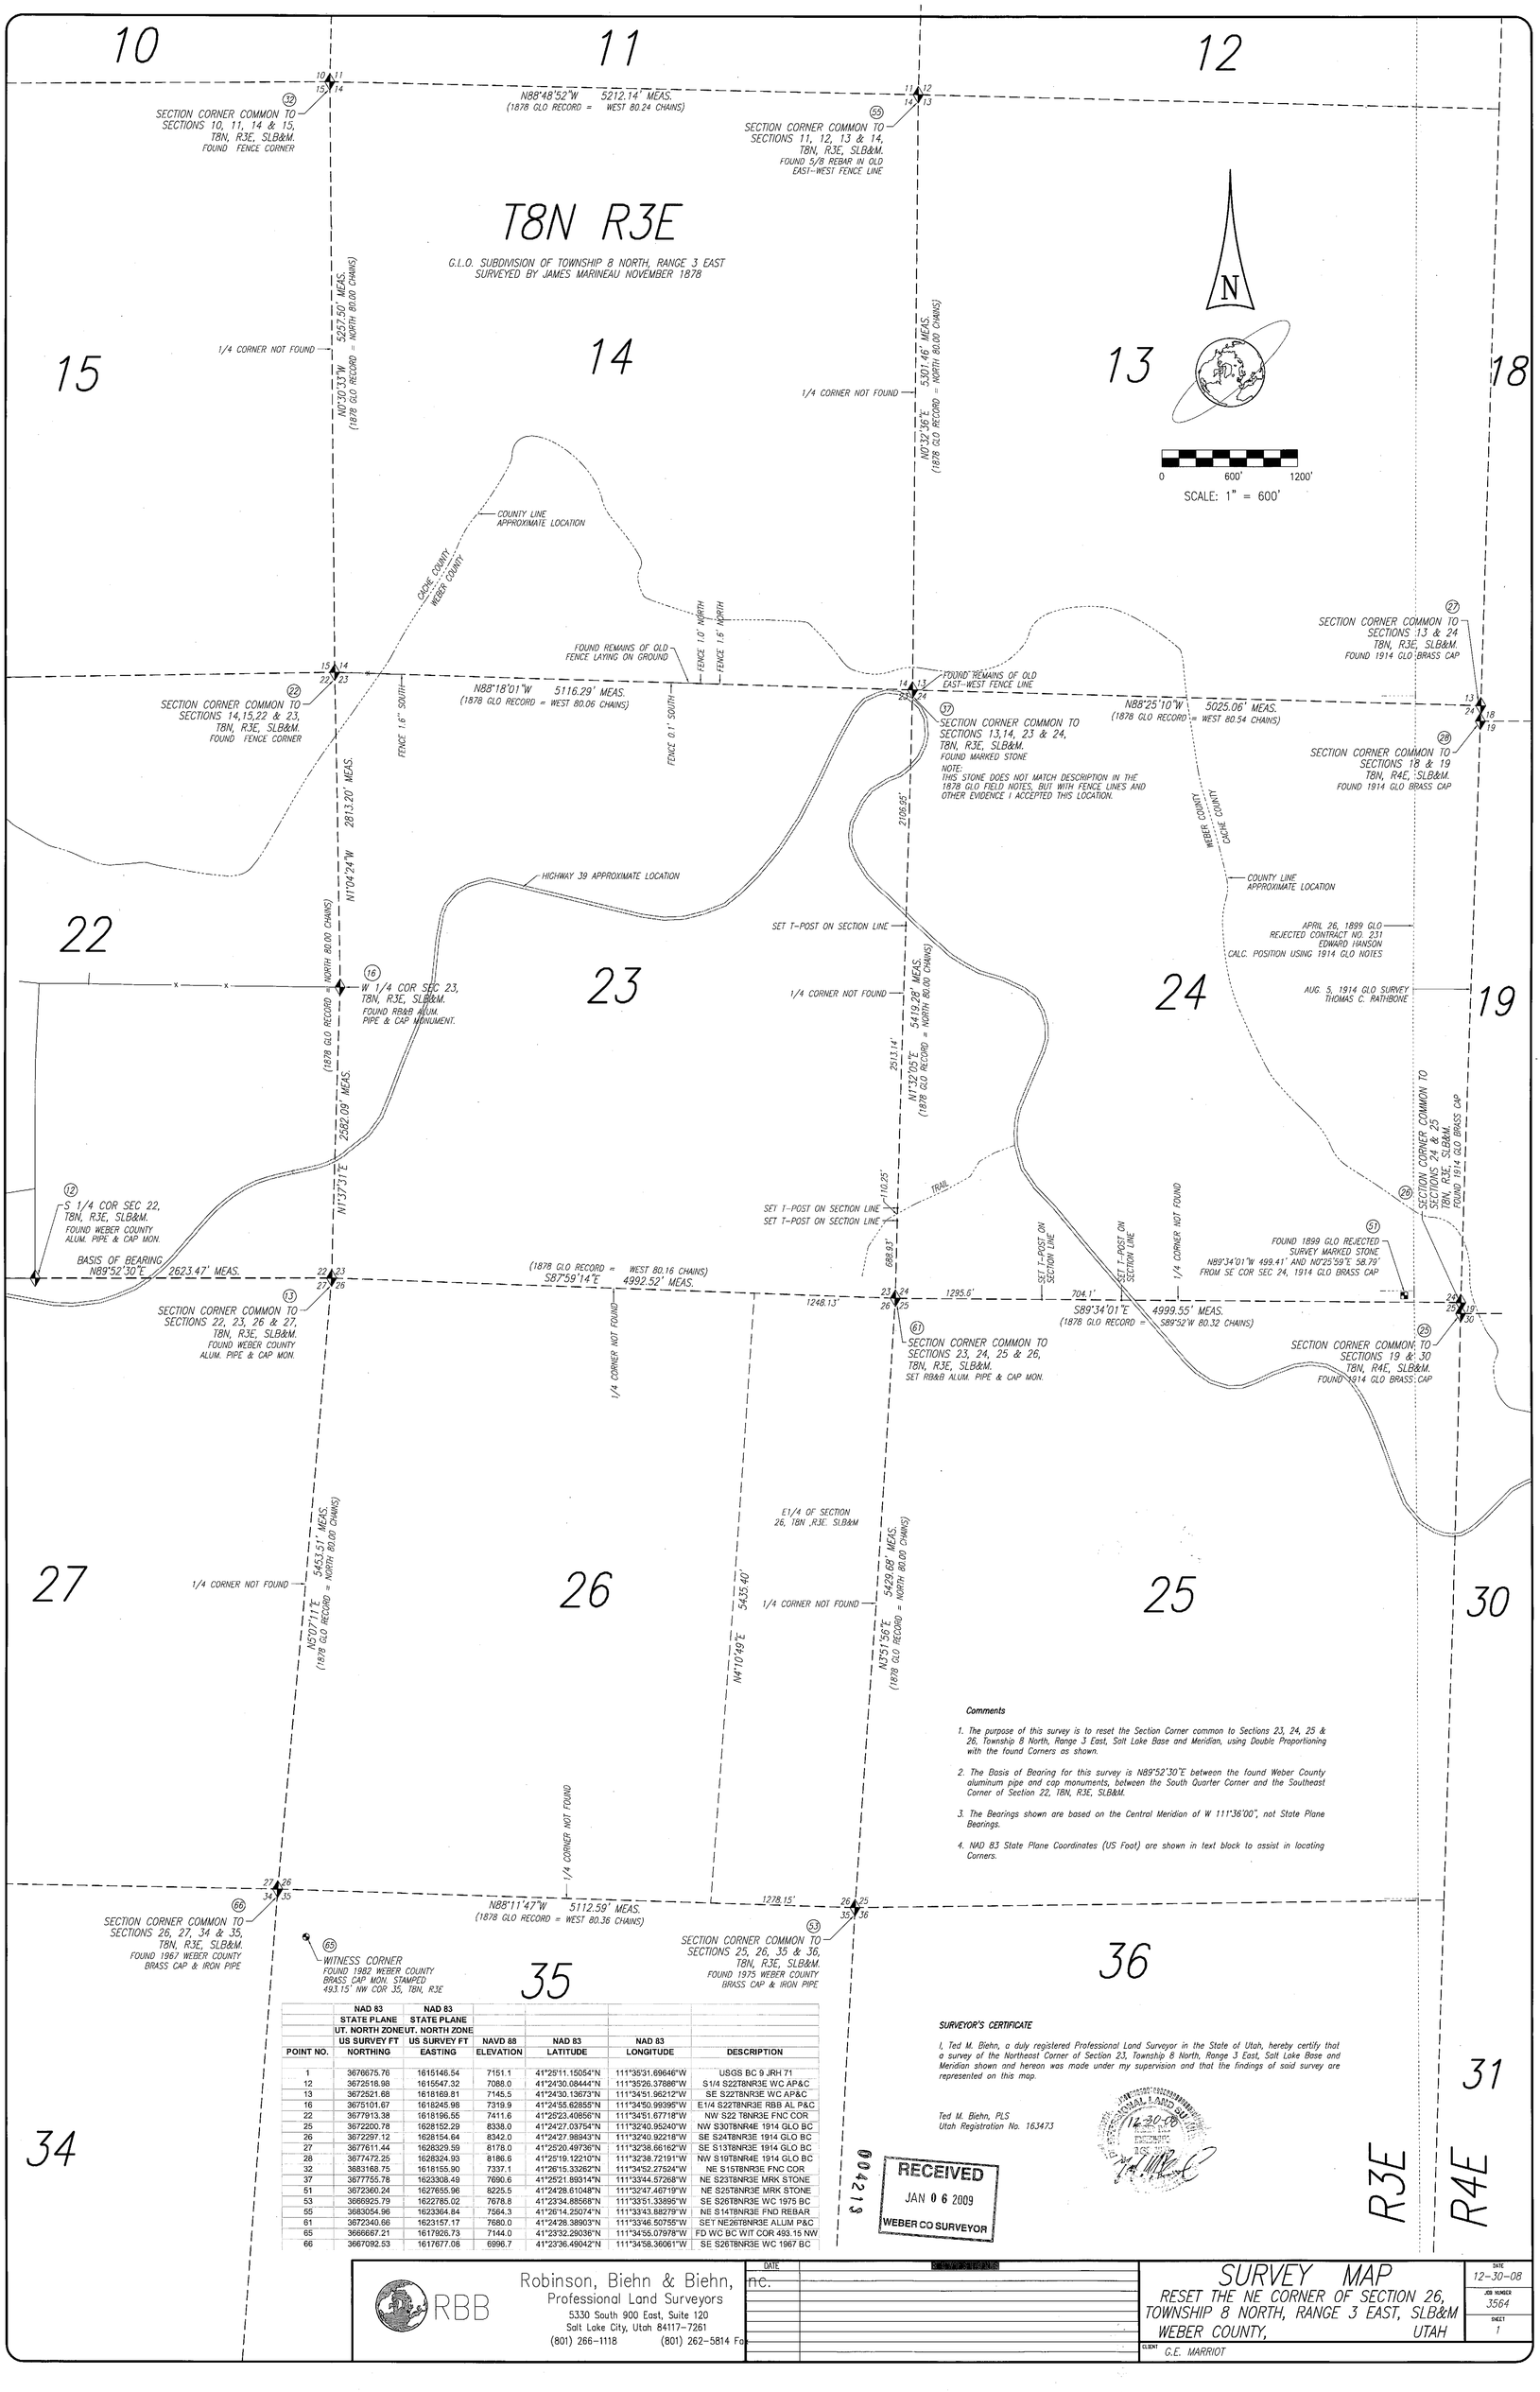

Comments

1. The purpose of this survey is to reset the Section Corner common to Sections 23, 24, 25 & 26, Township 8 North, Range 3 East, Salt Lake Base and Meridian, using Double Proportioning with the found Corners as shown.
2. The Basis of Bearing for this survey is N89°52'30"E between the found Weber County aluminum pipe and cap monuments, between the South Quarter Corner and the Southeast Corner of Section 22, T8N, R3E, SLB&M.
3. The Bearings shown are based on the Central Meridian of W 111°36'00", not State Plane Bearings.
4. NAD 83 State Plane Coordinates (US Foot) are shown in text block to assist in locating Corners.

POINT NO.	NAD 83 STATE PLANE UT. NORTH ZONE US SURVEY FT NORTHING	NAD 83 STATE PLANE UT. NORTH ZONE US SURVEY FT EASTING	NAVD 88 ELEVATION	NAD 83 LATITUDE	NAD 83 LONGITUDE	DESCRIPTION
1	3676675.76	1615146.54	7151.1	41°25'11.15054"N	111°35'31.69646"W	USGS BC 9 JRH 71
12	3672518.98	1615547.32	7088.0	41°24'30.08444"N	111°35'26.37888"W	S1/4 S22T8NR3E WC AP&C
13	3672521.68	1618169.81	7145.5	41°24'30.13673"N	111°34'51.96212"W	SE S22T8NR3E WC AP&C
16	3675101.67	1618245.98	7319.9	41°24'55.62855"N	111°34'50.99395"W	E1/4 S22T8NR3E RBB AL P&C
22	3677913.38	1618196.55	7411.6	41°25'23.40856"N	111°34'51.67718"W	NW S22 T8NR3E FNC COR
25	3672200.78	1628152.29	8338.0	41°24'27.03754"N	111°32'40.95240"W	NW S30T8NR4E 1914 GLO BC
26	3672297.12	1628154.64	8342.0	41°24'27.98943"N	111°32'40.92218"W	SE S24T8NR3E 1914 GLO BC
27	3677611.44	1628329.59	8178.0	41°25'20.49736"N	111°32'38.66162"W	SE S13T8NR3E 1914 GLO BC
28	3677472.25	1628324.93	8186.6	41°25'19.12210"N	111°32'38.72191"W	NW S19T8NR4E 1914 GLO BC
32	3683168.75	1618155.90	7337.1	41°26'15.33262"N	111°34'52.27524"W	NE S15T8NR3E FNC COR
37	3677755.78	1623308.49	7690.6	41°25'21.88314"N	111°33'44.57268"W	NE S23T8NR3E MRK STONE
51	3672360.24	1627655.96	8225.5	41°24'28.61048"N	111°32'47.46719"W	NE S25T8NR3E MRK STONE
53	3666925.79	1622785.02	7678.8	41°23'34.88568"N	111°33'51.33895"W	SE S26T8NR3E WC 1975 BC
55	3683054.96	1622364.84	7564.3	41°26'14.25074"N	111°33'43.88279"W	NE S14T8NR3E FND REBAR
61	3672340.66	1623157.17	7680.0	41°24'28.38903"N	111°33'46.50755"W	SET NE26T8NR3E ALUM P&C
65	3666667.21	1617926.73	7144.0	41°23'32.29036"N	111°34'55.07978"W	FD WC BC W/T COR 493.15 NW
66	3667092.53	1617677.08	6996.7	41°23'36.49042"N	111°34'58.36061"W	SE S26T8NR3E WC 1967 BC

SURVEYOR'S CERTIFICATE

I, Ted M. Biehn, a duly registered Professional Land Surveyor in the State of Utah, hereby certify that a survey of the Northeast Corner of Section 23, Township 8 North, Range 3 East, Salt Lake Base and Meridian shown and hereon was made under my supervision and that the findings of said survey are represented on this map.

Ted M. Biehn, PLS
Utah Registration No. 163473

12-30-08

RECEIVED
JAN 06 2009
WEBER CO SURVEYOR

00421S

RBB

Robinson, Biehn & Biehn, inc.
Professional Land Surveyors
5330 South 900 East, Suite 120
Salt Lake City, Utah 84117-7261
(801) 266-1118 (801) 262-5814 Fa

DATE	REVISIONS

SURVEY MAP

RESET THE NE CORNER OF SECTION 26, TOWNSHIP 8 NORTH, RANGE 3 EAST, SLB&M
WEBER COUNTY, UTAH

CLIENT: G.E. MARRIOT

DATE: 12-30-08
JOB NUMBER: 3564
SHEET: 1