



CALL BLUESTAKES
 @ 1-800-662-4111
 AT LEAST 48 HOURS
 PRIOR TO THE
 COMMENCEMENT OF
 ANY CONSTRUCTION.

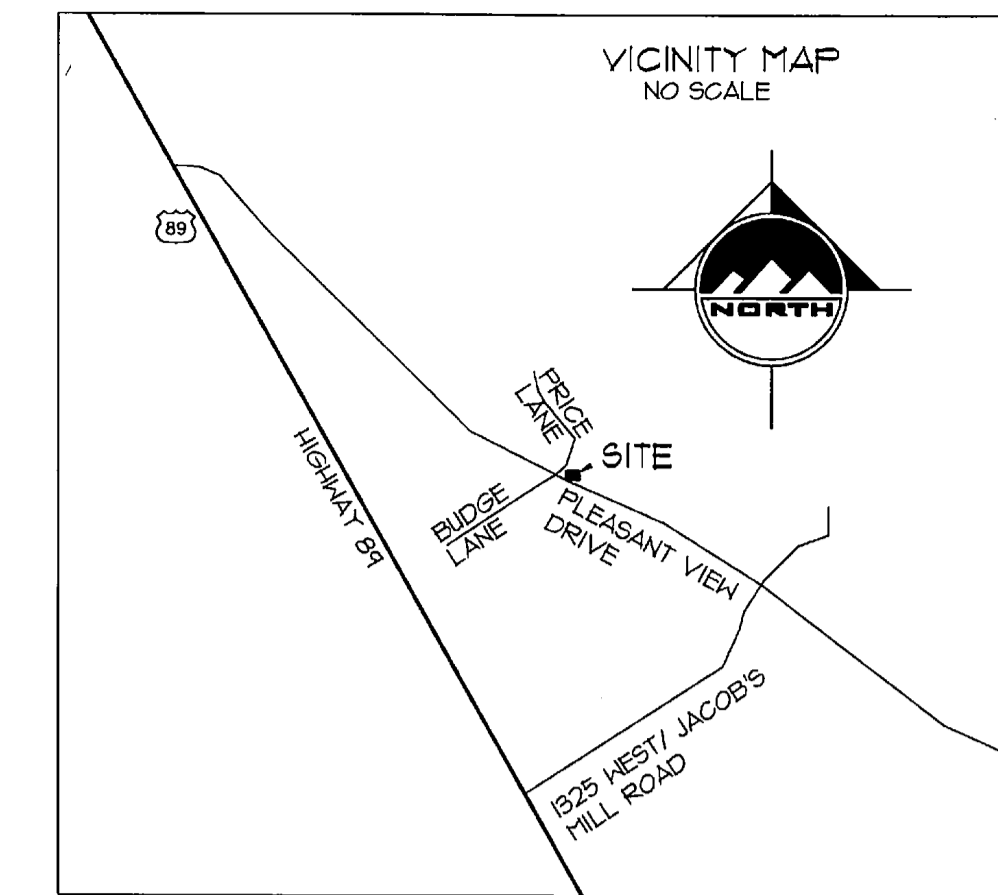

ENSIGN
 90 E. Fort Union Blvd
 Suite 100
 Midvale UT 84047
 Phone: 801.255.0529
 Fax: 801.255.4449
 1485 West Hillfield
 Rd. Suite 204
 Layton UT 84041
 Phone: 801.547.1100
 Fax: 801.593.6315
 795 South Main Street
 Pleasant Grove UT 84062
 Phone: 801.796.8145
 Fax: 801.796.8147
 WWW.ENSIGNUTAH.COM

FOR:
 BRETT HAWKINSON
 1608 WEST PLEASANT VIEW DRIVE
 PLEASANT VIEW CITY, UTAH 84414
 CONTACT:
 PHONE: (801) 389-2032
 FAX:


HAWKINSON PROPERTY
1608 WEST PLEASANT VIEW DRIVE
PLEASANT VIEW CITY, UTAH

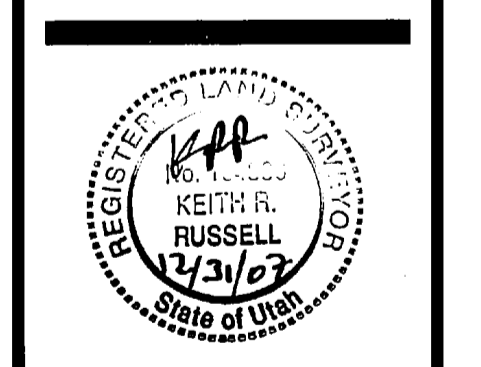

NO.	DATE	REVISION	BY
1		FOR REVIEW	
2			
3			
4			

BOUNDARY SURVEY

PROJECT NUMBER: L1684
 DATE: 12/16/07
 DRAWN BY: T. WILLIAMS
 CHECKED BY:
 PROJECT MANAGER: R. BRUNS

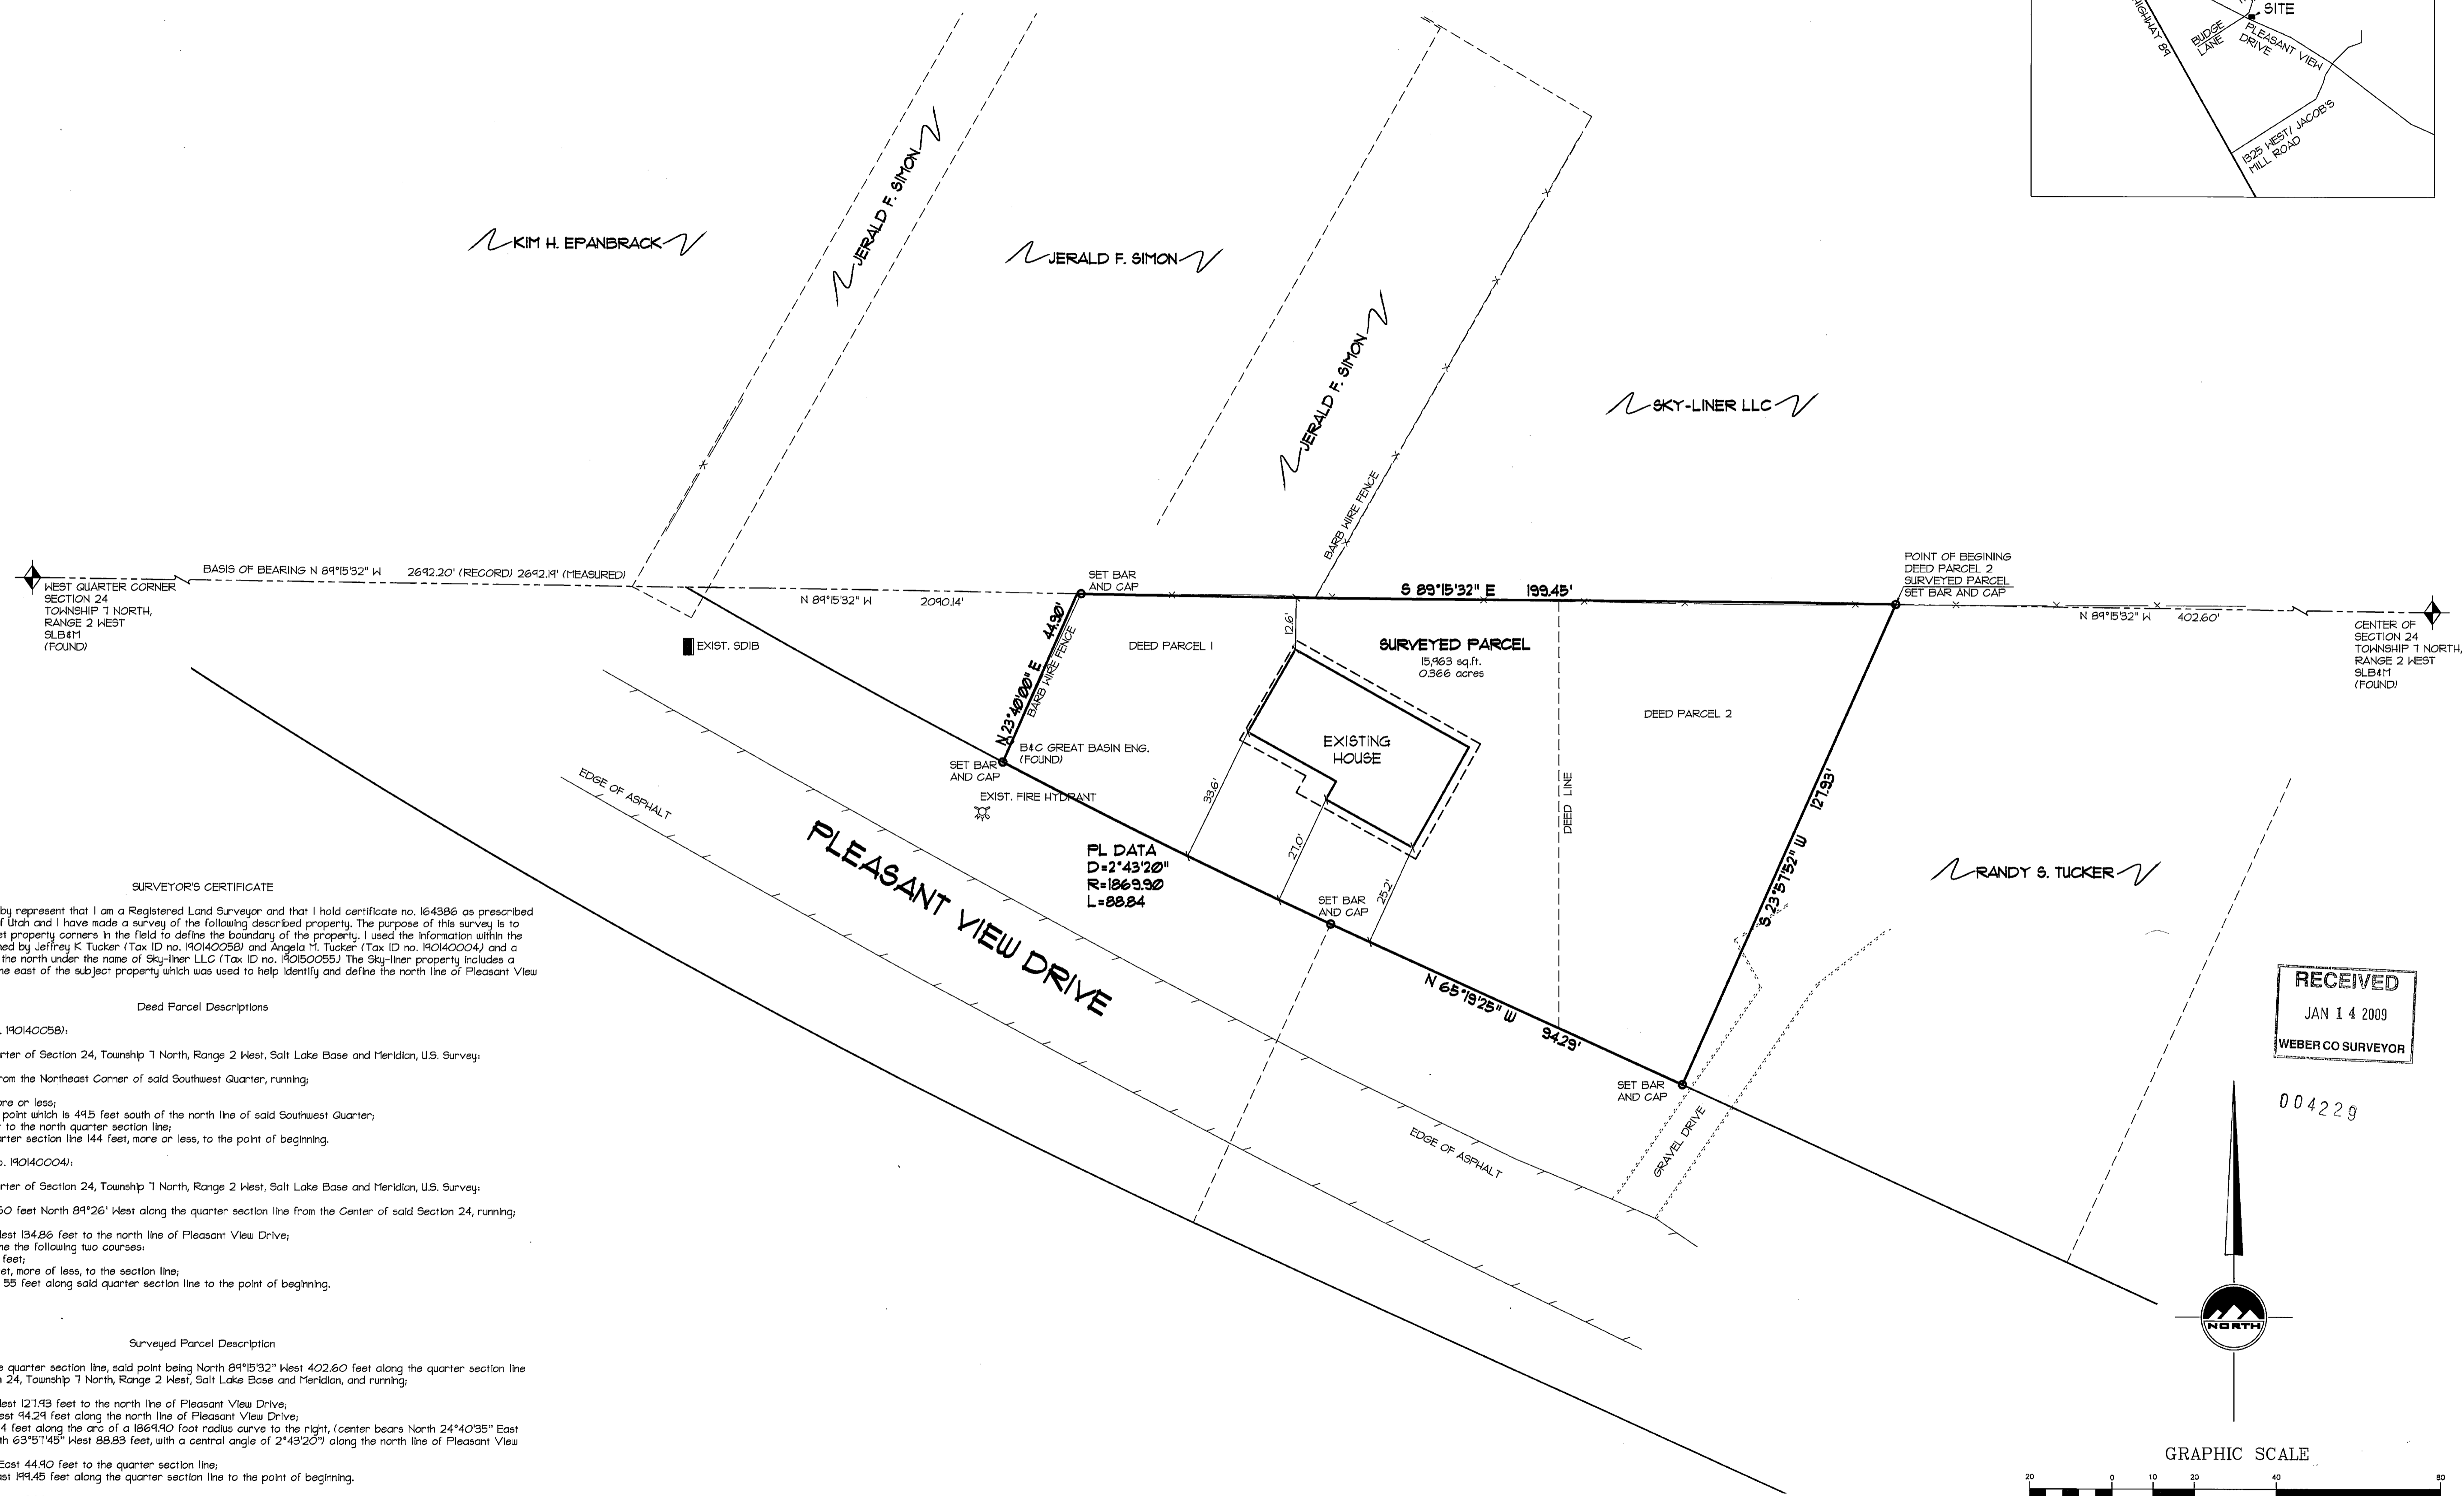

SURVEYOR'S CERTIFICATE

I, Keith R. Russell, do hereby represent that I am a Registered Land Surveyor and that I hold certificate no. 164386 as prescribed by the laws of the State of Utah and I have made a survey of the following described property. The purpose of this survey is to define the property and set property corners in the field to define the boundary of the property. I used the information within the deeds of the property owned by Jeffrey K. Tucker (Tax ID no. 19040058) and Angela M. Tucker (Tax ID no. 19040004) and a survey of the property to the north under the name of Sky-Liner LLC (Tax ID no. 19050055). The Sky-Liner property includes a description of a road to the east of the subject property which was used to help identify and define the north line of Pleasant View Drive.

Deed Parcel Descriptions


Deed Parcel 1, (Tax ID no. 19040058):
 Part of the Southwest Quarter of Section 24, Township 1 North, Range 2 West, Salt Lake Base and Meridian, U.S. Survey:
 Beginning 479 feet West from the Northeast Corner of said Southwest Quarter, running:
 Thence South 99.5 feet, more or less;
 Thence northeasterly to a point which is 44.5 feet south of the north line of said Southwest Quarter;
 Thence northerly 49.5 feet to the north quarter section line;
 Thence East along the quarter section line 144 feet, more or less, to the point of beginning.

Deed Parcel 2, (Tax ID no. 19040004):
 Part of the Southwest Quarter of Section 24, Township 1 North, Range 2 West, Salt Lake Base and Meridian, U.S. Survey:
 Beginning at a point 402.60 feet North 89°15'32" West along the quarter section line from the Center of said Section 24, running:
 Thence South 23°51'52" West 127.93 feet to the north line of Pleasant View Drive;
 Thence along said north line the following two courses:
 North 65°21' West 30 feet;
 thence North 99.50 feet, more or less, to the section line;
 Thence South 89°26' East 55 feet along said quarter section line to the point of beginning.

Surveyed Parcel Description

Beginning at a point on the quarter section line, said point being North 89°15'32" West 402.60 feet along the quarter section line from the Center of Section 24, Township 1 North, Range 2 West, Salt Lake Base and Meridian, and running:
 Thence South 23°51'52" West 127.93 feet to the north line of Pleasant View Drive;
 Thence North 65°19'25" West 94.28 feet along the north line of Pleasant View Drive;
 Thence northeasterly 88.84 feet along the arc of a 1869.90 foot radius curve to the right, (center bears North 24°40'35" East and long chord bears North 63°51'45" West 88.83 feet, with a central angle of 2°43'20") along the north line of Pleasant View Drive;
 Thence North 23°40'00" East 44.90 feet to the quarter section line;
 Thence South 89°15'32" East 199.45 feet along the quarter section line to the point of beginning.
 Contains 15,963 square feet, 0.366 acres.

Dec. 31, 2007
 Keith R. Russell
 License no. 164386

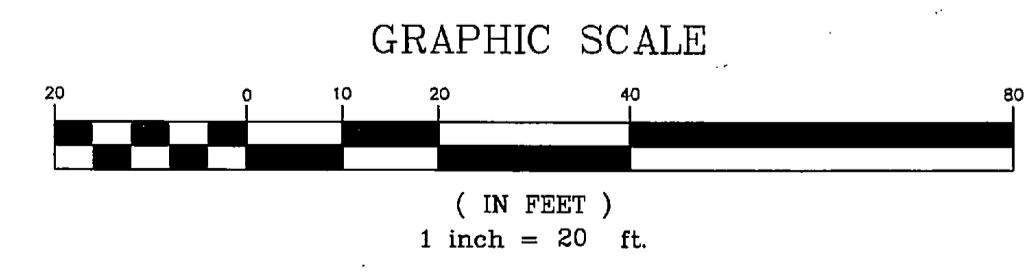

LOCATED IN THE SOUTHWEST QUARTER OF
 SECTION 24
 TOWNSHIP 1 NORTH, RANGE 2 WEST
 SALT LAKE BASE AND MERIDIAN
 PLEASANT VIEW CITY, WEBER COUNTY, UTAH