


LEGEND
 NOT ALL ITEMS IN THE LEGEND MAY BE APPLICABLE

- (E) EXISTING CONCRETE
- BOUNDARY LINE
- CENTERLINE
- ADJACENT PROP. LINE
- SECTION LINE
- SECTION CORNER
- MONUMENT
- CONTROL POINT
- SET BAR & CAP OR NAIL & WASHER
- STAMPED "PINNACLE"

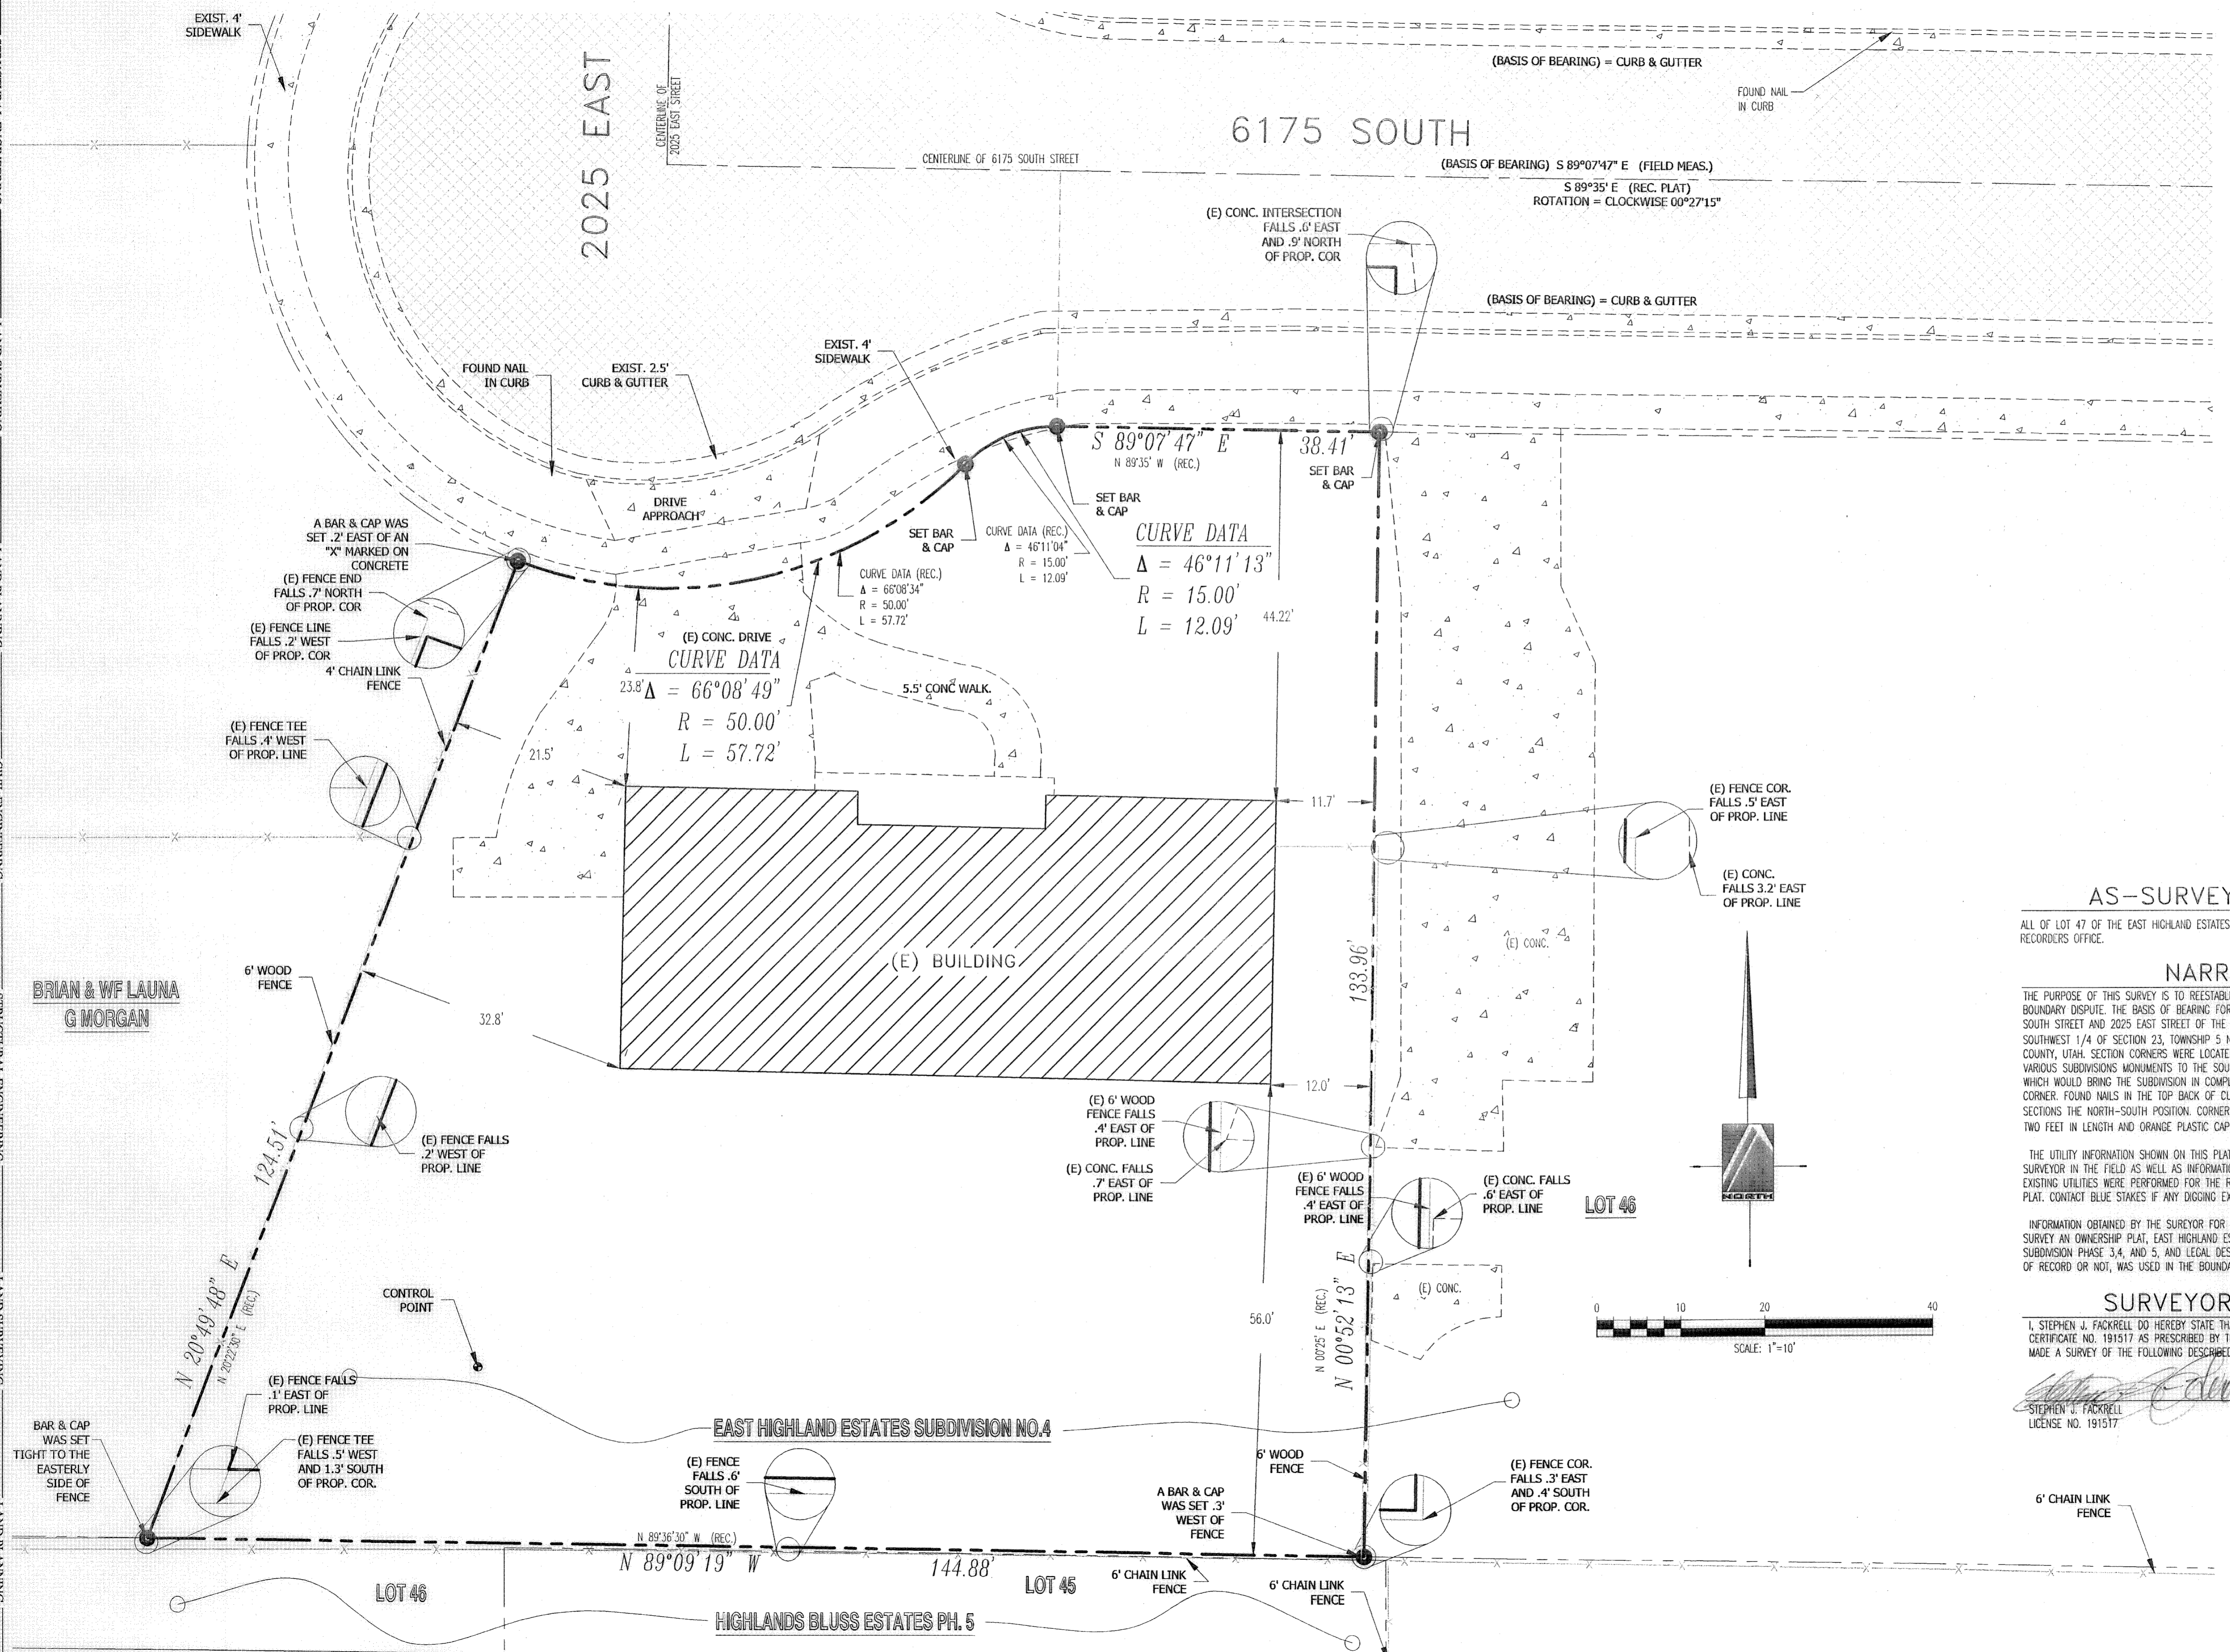

PINNACLE
 Engineering & Land Surveying, Inc.
 1513 North Hillfield Rd., Suite #2
 Layton, UT 84041
 Phone: (801) 628-7271
 Fax: (801) 544-0651

LOT 47, EAST HIGHLAND ESTATES SUBD. NO. 4
 BOUNDARY SURVEY
 FOR: KIRK WHITE
 2031 EAST 6175 SOUTH
 OGDEN UT, 84403
 PROJECT # 04-093

BRIAN & WF LAUNA
 G MORGAN

DATE	REVISION	BY	DATE
10/20/04	ADDED NOTES FROM CORNERS BEING SET	JDL	11/18/04
10/29/04		JDL	10/29/04
10/29/04		SJF	10/29/04

SHEET # 1 OF 1