


STRUCTURAL ENGINEERING
LAND SURVEYING
LAND PLANNING
CIVIL ENGINEERING
STRUCTURAL ENGINEERING
LAND SURVEYING
LAND PLANNING

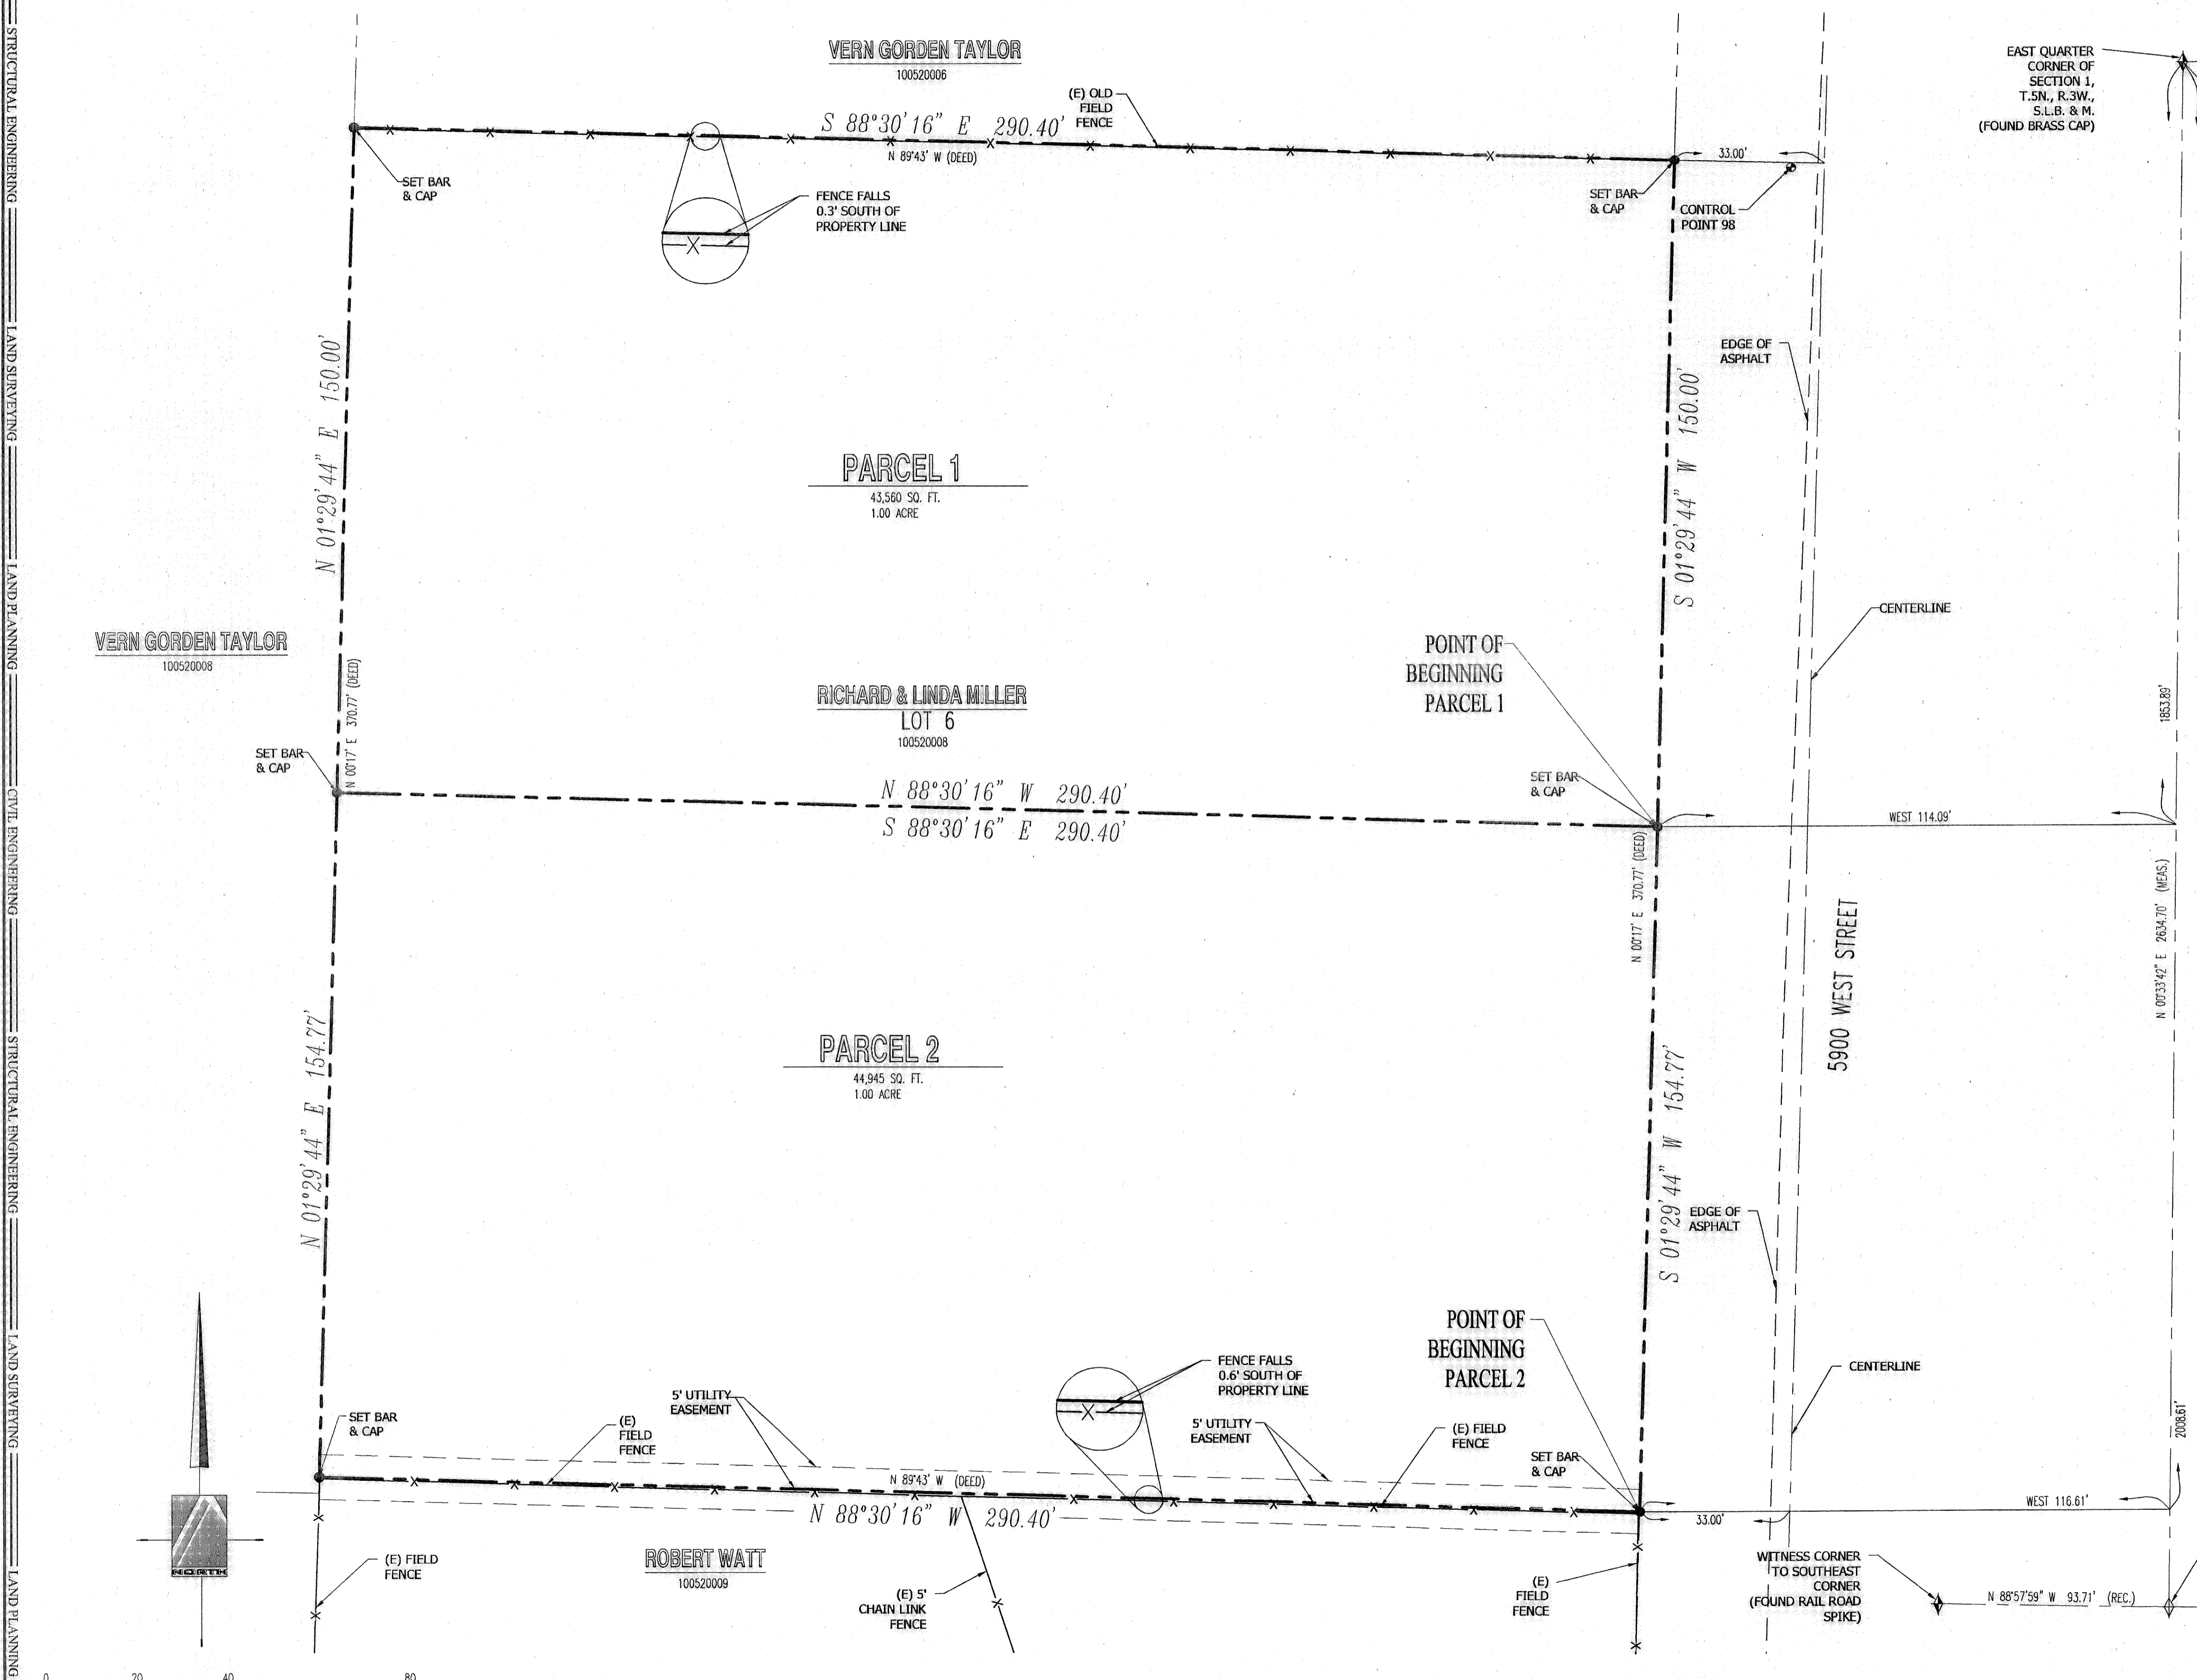

PINNACLE
Engineering & Land Surveying, Inc.
Layton • West Bountiful • Mount Pleasant • St. George
1513 North Hillfield Rd., Suite #2
Layton, UT 84041
Phone: (801) 866-0676
Fax: (801) 866-9678

MILLER SURVEY
BOUNDARY SURVEY/PARCEL SPLIT
LINDA MILLER
3885 SOUTH 5900 WEST
HOOPER, UT
JOB# 04-086

BY DATE

DATE	REVISION
09/20/04	
07/20/07	

SURVEYED BY SPB
DESIGNED BY BTB
DRAWN BY BTB
APPROVED BY SJF

DATE 09/20/04
DATE 07/20/07

SHEET # 1 **OF** 1