


PINNACLE
 Engineering & Land Surveying, Inc.
 Layton • West Bountiful • Mt. Pleasant
 1513 North Huffield Rd., Suite #2 Layton, UT 84041
 Phone: (801) 866-0676 Fax: (801) 866-0678

LOT 30, WEST HAVEN INDUSTRIAL PARK
 BOUNDARY SURVEY
 FOR: PETER FONDARIO
 APPROX: 2150 WEST 3300 SOUTH
 WEST HAVEN, UTAH
 JOB # 05-75

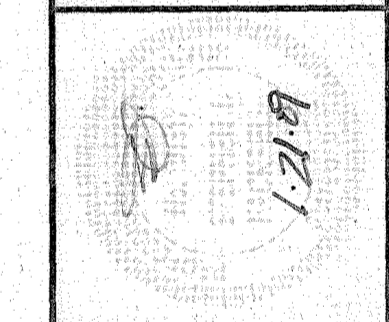

BY DATE		REVISION	
SURVEYED BY	DATE	DESIGNED BY	DATE
DW	6/2005	DRAWN BY	DATE
		JDL	6/2005
APPROVED BY			
SJF			
SHEET #	1	OF	1