


Z:\2008 Disk 4\2008\08-3-134-1-15\Drawings\08-3-134.dwg, Sheet 1 Recording, 1/30/2009 11:12:36 AM, 1:400

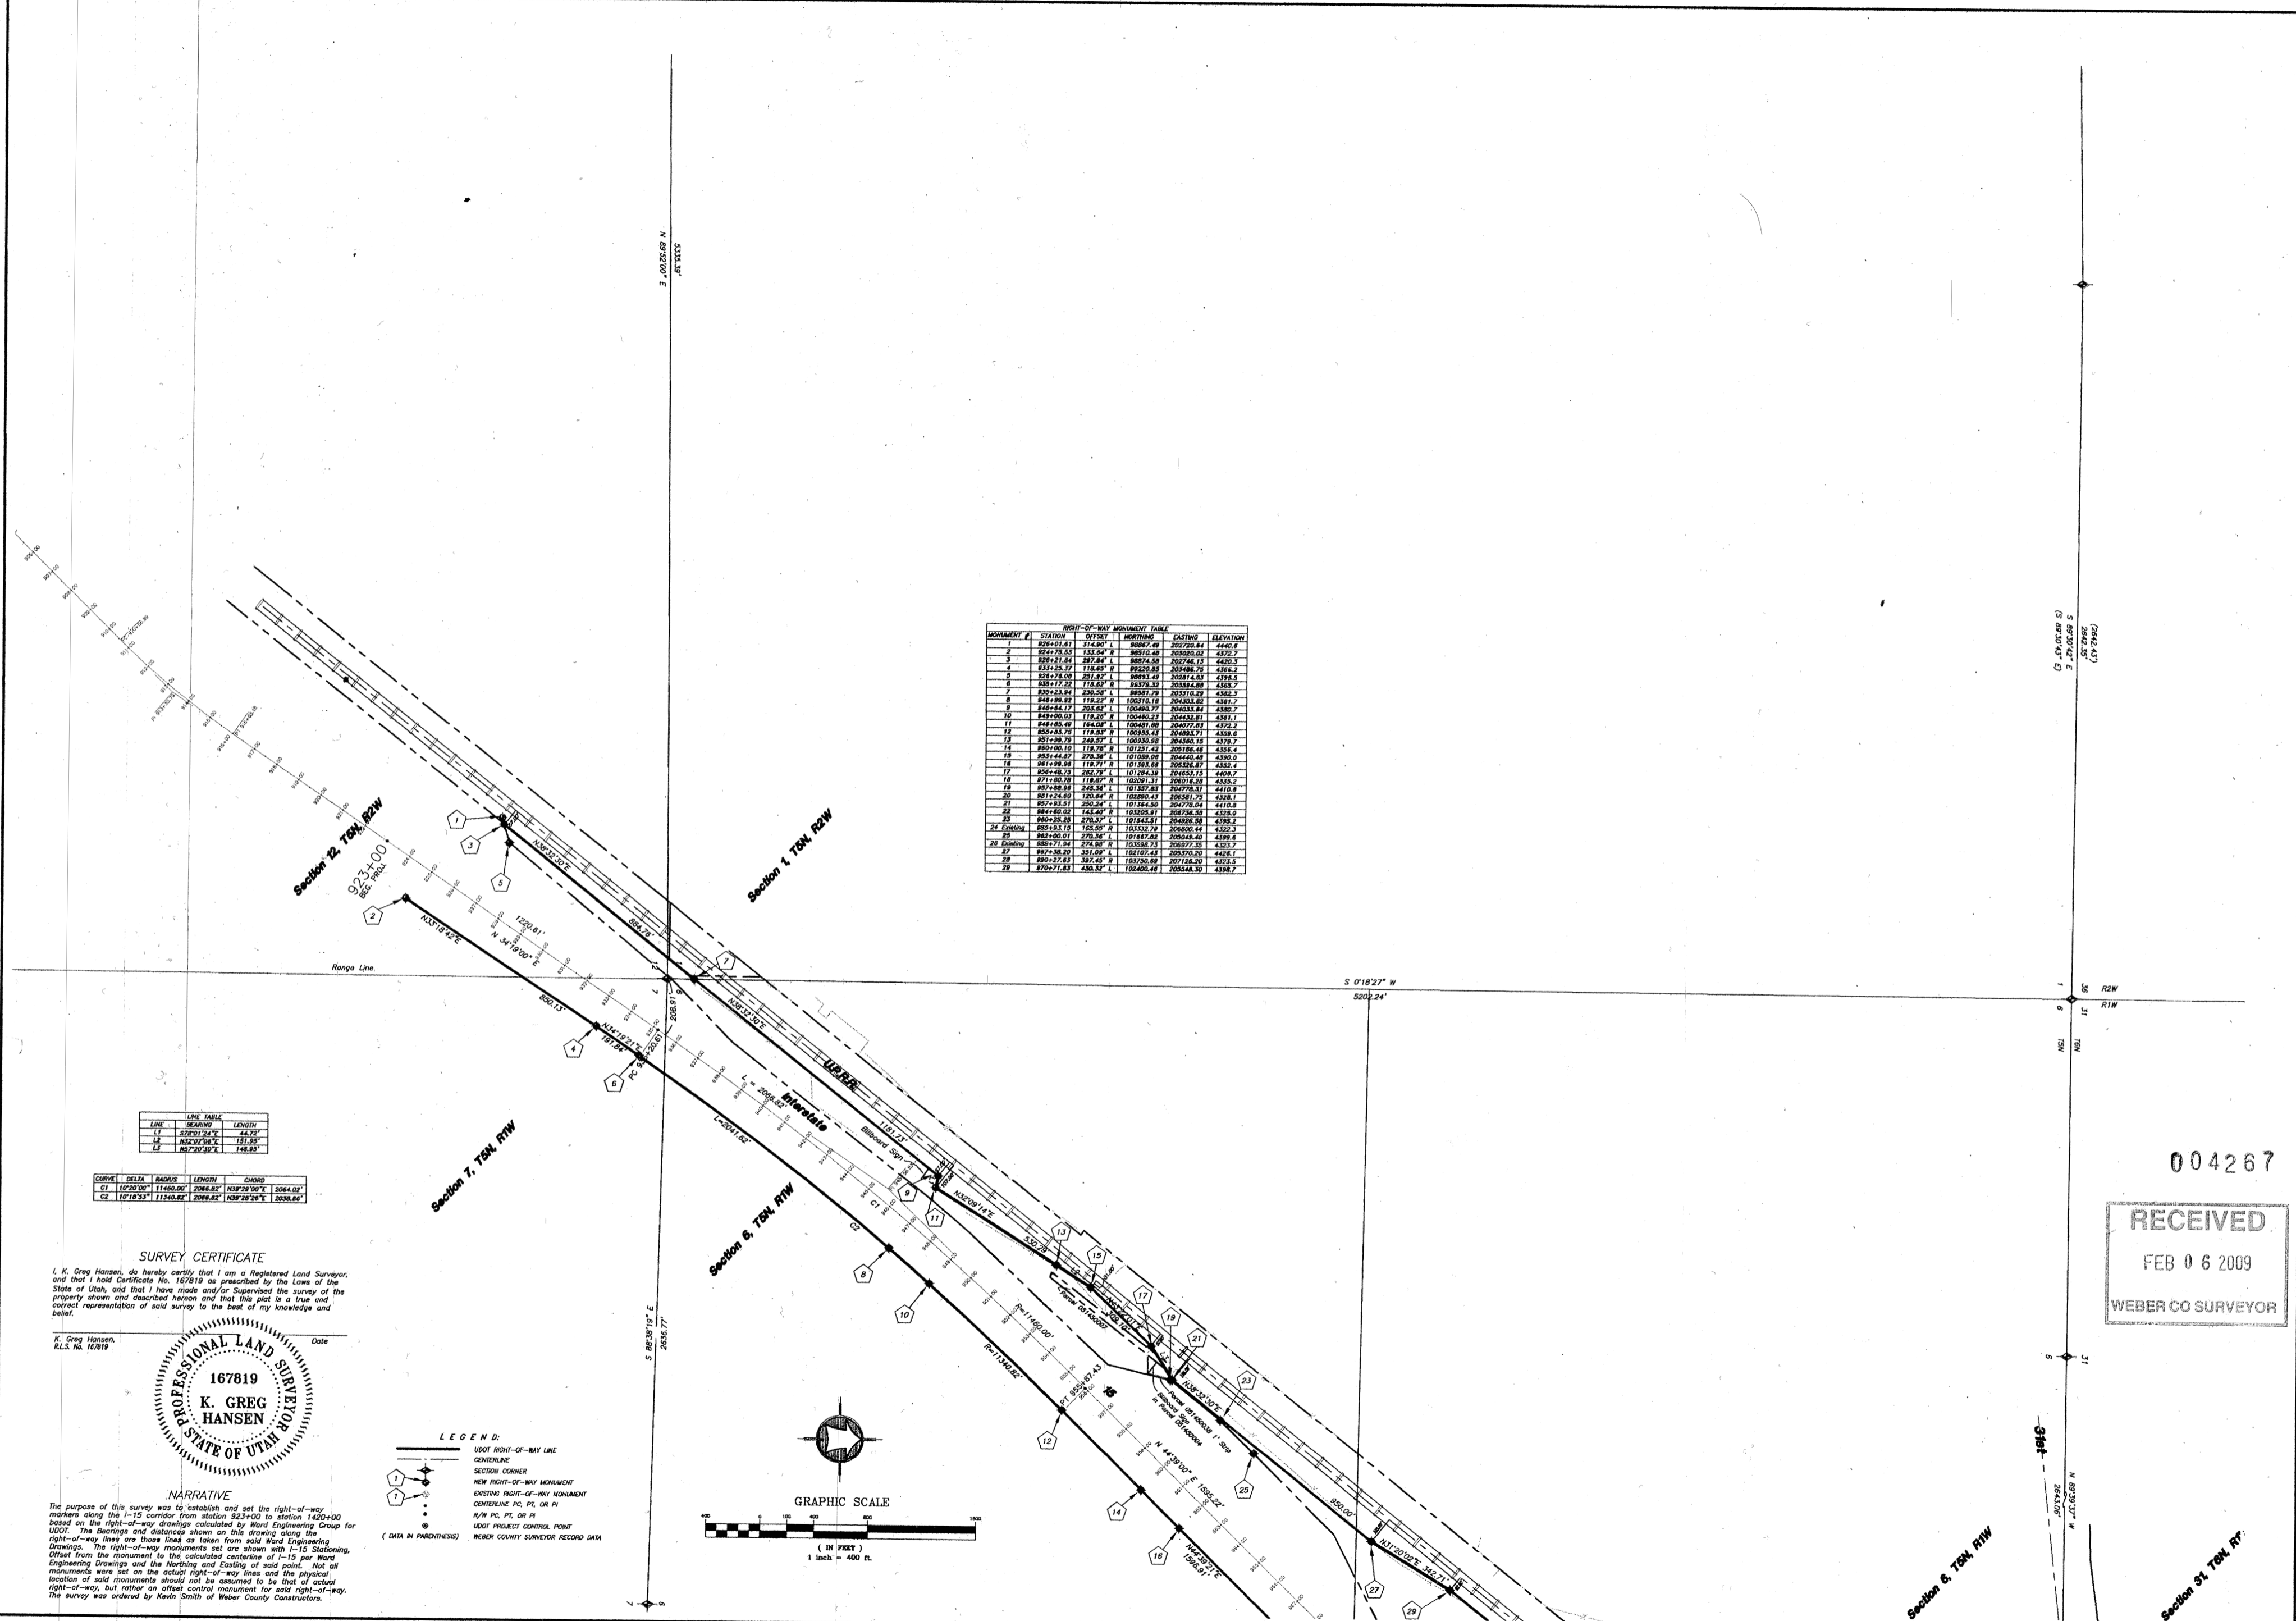

| LINE | BEARING | LENGTH |
|------|--------------|---------|
| L1 | S 72°01'24\" | 44.72' |


SURVEY CERTIFICATE


I, K. Greg Hansen, do hereby certify that I am a Registered Land Surveyor and that I hold Certificate No. 167819 as prescribed by the Laws of the State of Utah, and that I have made and/or Supervised the survey of the property shown and described hereon and that this plan is a true and correct representation of said survey to the best of my knowledge and belief.

K. Greg Hansen
R.L.S. No. 167819
Date _____



NARRATIVE
The purpose of this survey was to establish and set the right-of-way markers along the 1-15 corridor from station 823+00 to station 1420+00 based on the right-of-way drawings calculated by Ward Engineering Group for UDOT. The bearings and distances shown on this drawing along the right-of-way lines are those lines as taken from said Ward Engineering Drawings. The right-of-way monuments set are shown with 1-15 Stationing. Offset from the monument to the calculated centerline of 1-15 per Ward Engineering Drawings and the bearing and Easting of said point. Not all monuments were set on the actual right-of-way lines and the physical location of said monuments should not be assumed to be that of actual right-of-way, but rather on offset control monument for said right-of-way. The survey was ordered by Kevin Smith of Weber County Constructors.

LEGEND:
 UDOT RIGHT-OF-WAY LINE
 CENTERLINE
 SECTION CORNER
 NEW RIGHT-OF-WAY MONUMENT
 EXISTING RIGHT-OF-WAY MONUMENT
 CENTERLINE PC, PT, OR PI
 R/W PC, PI, OR PI
 UDOT PROJECT CONTROL POINT
 WEBER COUNTY SURVEYOR RECORD DATA
 (DATA IN PARENTHESES)

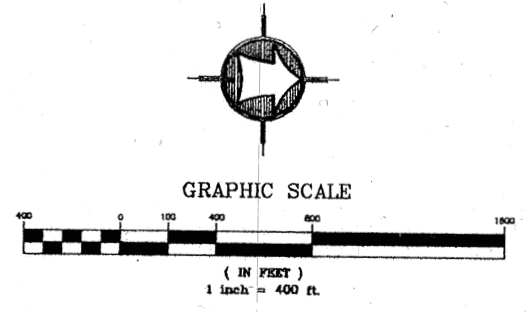

004267

RECEIVED
 FEB 06 2009
 WEBER CO SURVEYOR


Right-Of-Way Survey for
INTERSTATE 15
SP-15-8 (34) 342
 WEBER COUNTY, UTAH

SHEET
1
 OF
9
 SHEETS

Drawn By: JES Date: OCT. 2004
 Designed By:
 Checked By:
 Approved By:
 Scale: 1" = 200'
 Drawing File: 08-3-134.dwg
 JOB NUMBER: 08-3-134

HANSEN & ASSOCIATES, INC.
 Consulting Engineers and Land Surveyors
 538 North Main
 67 East 100 North
 Brigham City
 Logan
 Ogden
 (435) 723-3491
 (435) 723-7663 (901) 399-4905 (435) 752-9272

| No. | Date | By | Revision |
|-----|------|----|----------|
| | | | |
| | | | |
| | | | |

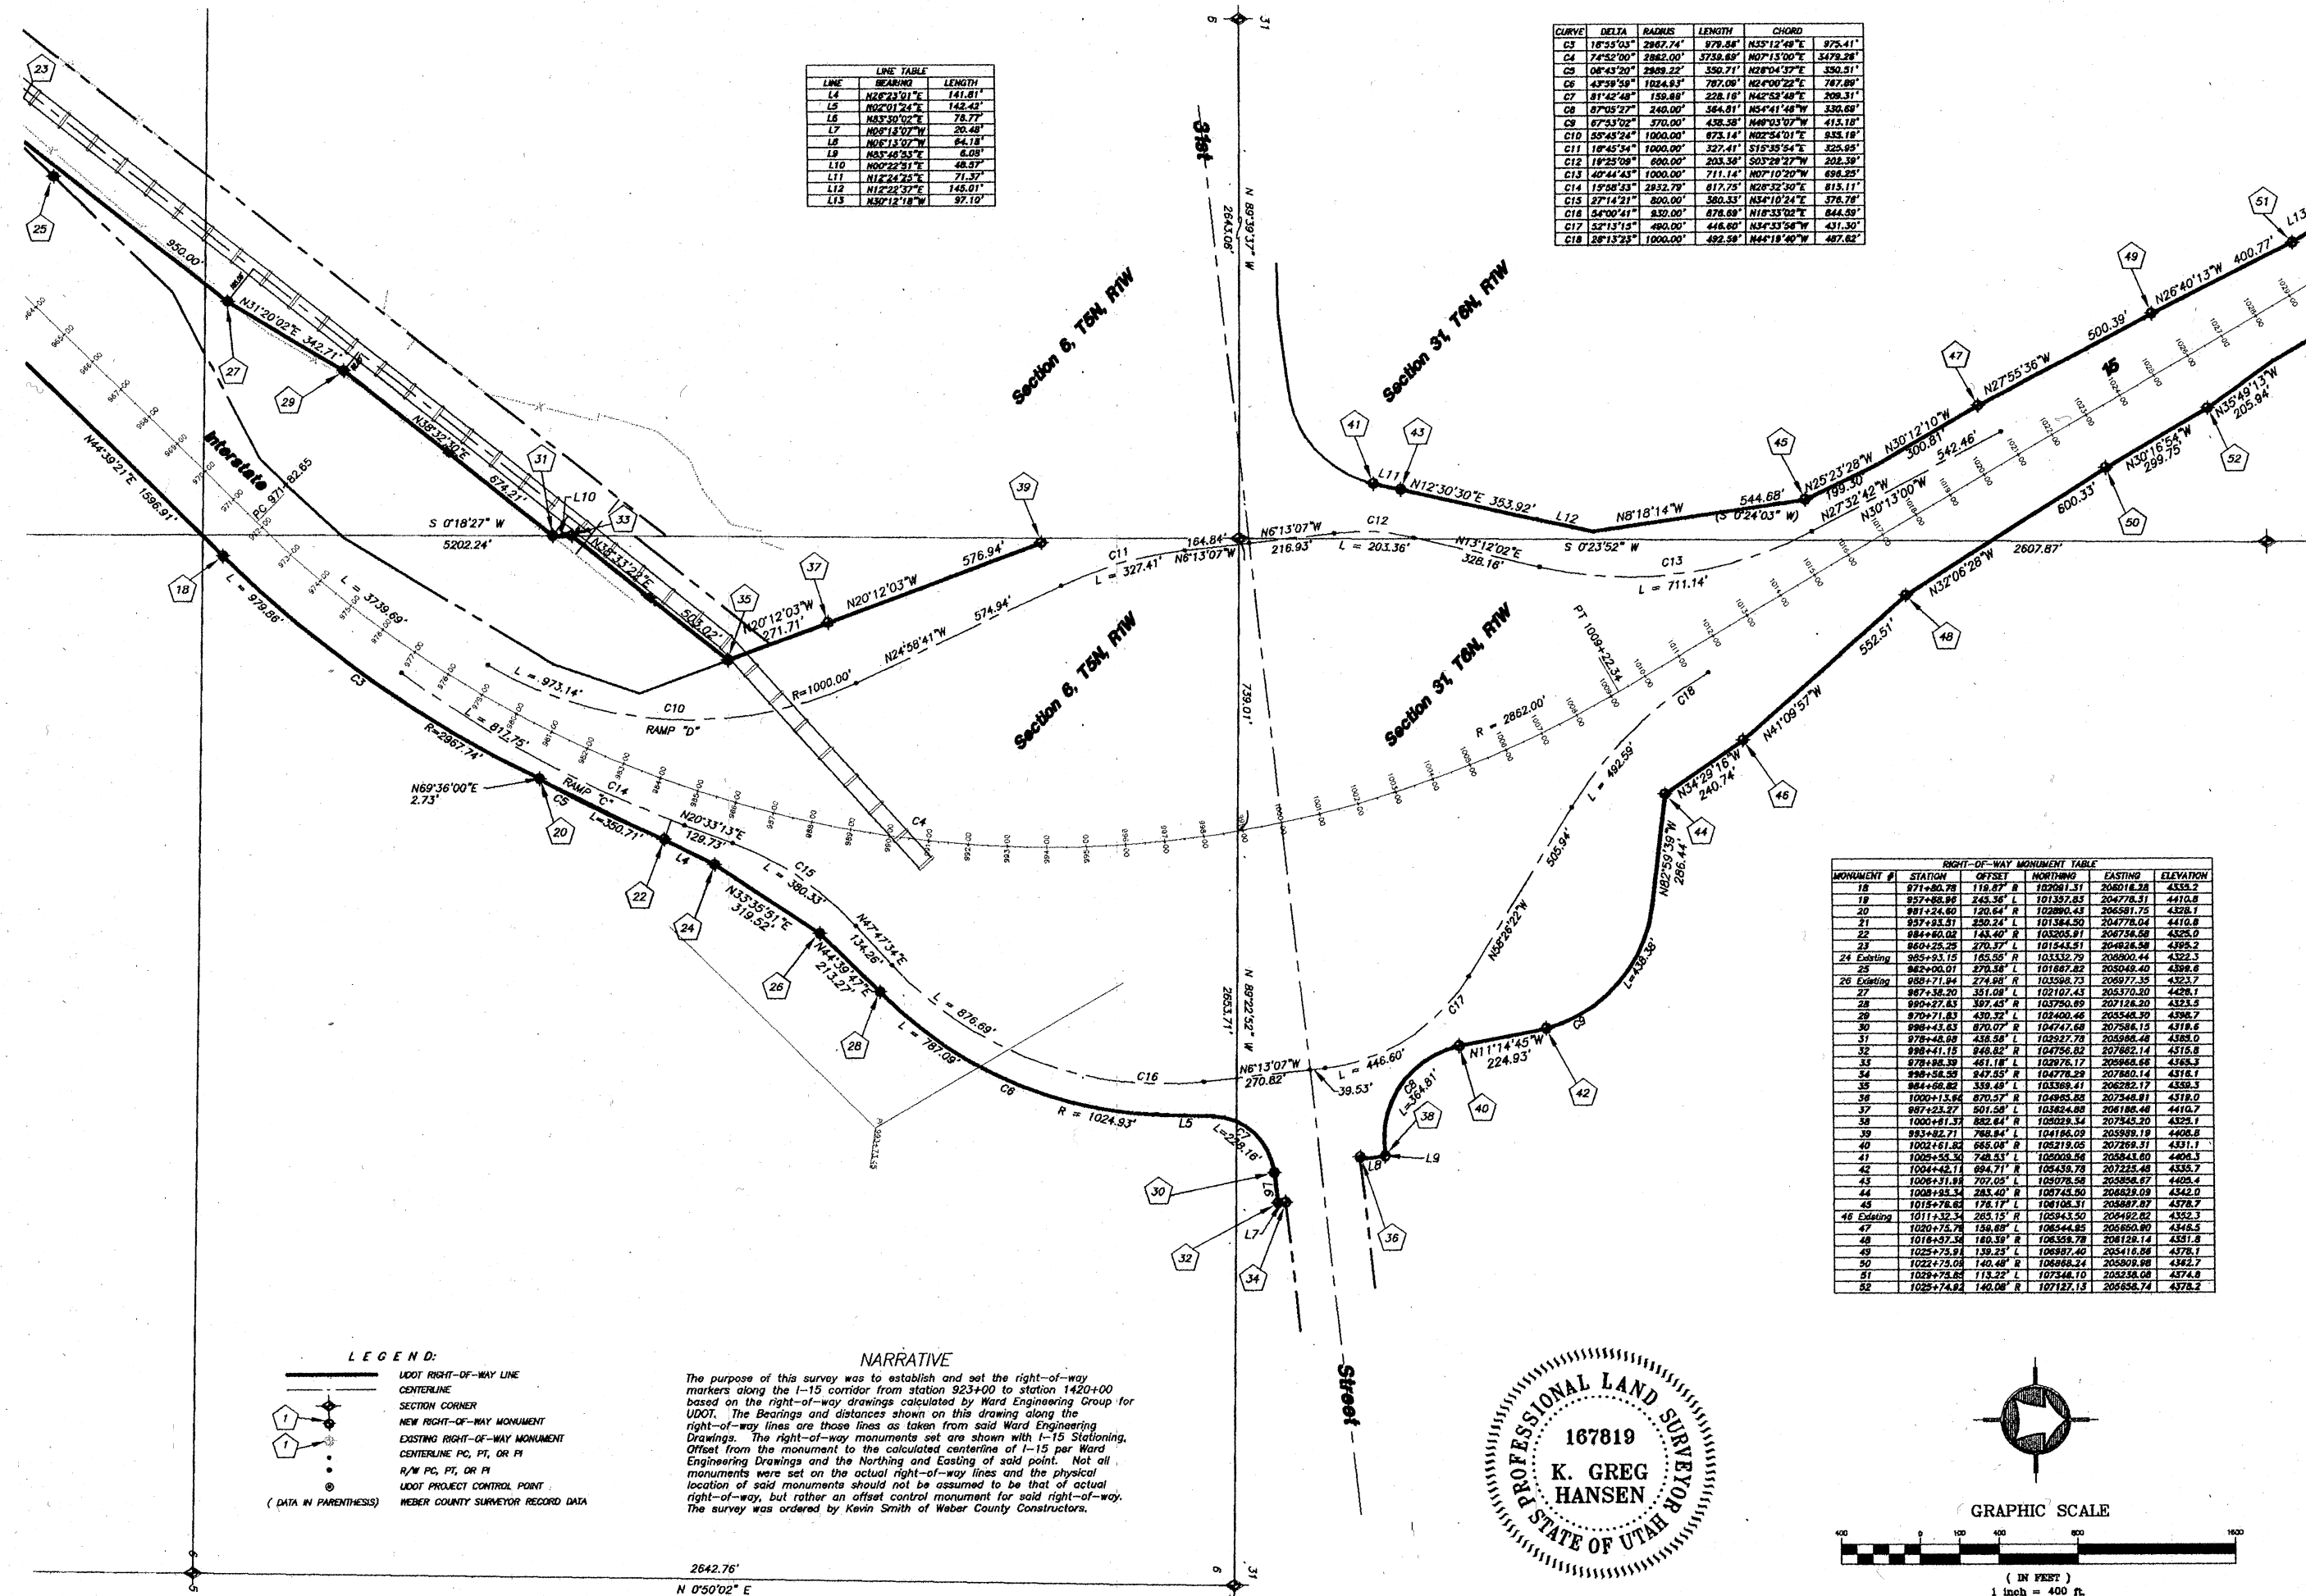

LINE TABLE

| LINE NUMBER | BEARING | LENGTH |
|-------------|-------------|---------|

CURVE DATA


RIGHT-OF-WAY MONUMENT TABLE



| MONUMENT # | STATION | OFFSET | NORTHING | EASTING | ELEVATION |
|------------|-------------|-----------|-----------|-----------|-----------|

NARRATIVE

The purpose of this survey was to establish and set the right-of-way markers along the I-15 corridor from station 823+00 to station 1420+00 based on the right-of-way drawings calculated by Ward Engineering Group for UDOT. The bearings and distances shown on this drawing along the right-of-way lines are those lines as taken from said Ward Engineering drawings. The right-of-way monuments set are shown with I-15 Stationing. Offset from the monument to the calculated centerline of I-15 per Ward Engineering Drawings and the Northing and Easting of said point. Not all monuments were set on the actual right-of-way lines and the physical location of said monuments should not be assumed to be that of actual right-of-way, but rather an offset control monument for said right-of-way. The survey was ordered by Kevin Smith of Weber County Constructors.

LEGEND:

- UDOT RIGHT-OF-WAY LINE
- CENTERLINE
- SECTION CORNER
- NEW RIGHT-OF-WAY MONUMENT
- EXISTING RIGHT-OF-WAY MONUMENT
- CENTERLINE PC, PT, OR PI
- R/W PC, PT, OR PI
- UDOT PROJECT CONTROL POINT
- WEBER COUNTY SURVEYOR RECORD DATA

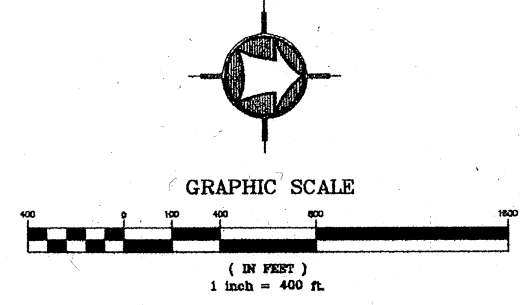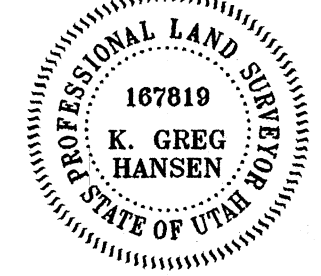

004267

RECEIVED
FEB 06 2009
WEBER CO SURVEYOR

| No. | Date | By | Revision |
|-----|------|----|----------|
| | | | |
| | | | |
| | | | |
| | | | |
| | | | |
| | | | |

HANSEN & ASSOCIATES, INC.
 Consulting Engineers and Land Surveyors
 538 North Main
 67 East 100 North
 Brigham City, Utah 84302
 Ogden, Utah (435) 752-9197
 (435) 723-7663 (801) 399-4905 (435) 752-8272

Drawn By: JES Date: OCT. 2004
 Designed By: _____
 Checked By: _____
 Approved By: _____
 Scale: 1" = 200'
 Drawing File: 08-3-134.dwg
 JOB NUMBER: 08-3-134


Right-of-Way Survey for
INTERSTATE 15
SP-15-8 (34) 342
 WEBER COUNTY, UTAH

SHEET
2
OF
9
SHEETS



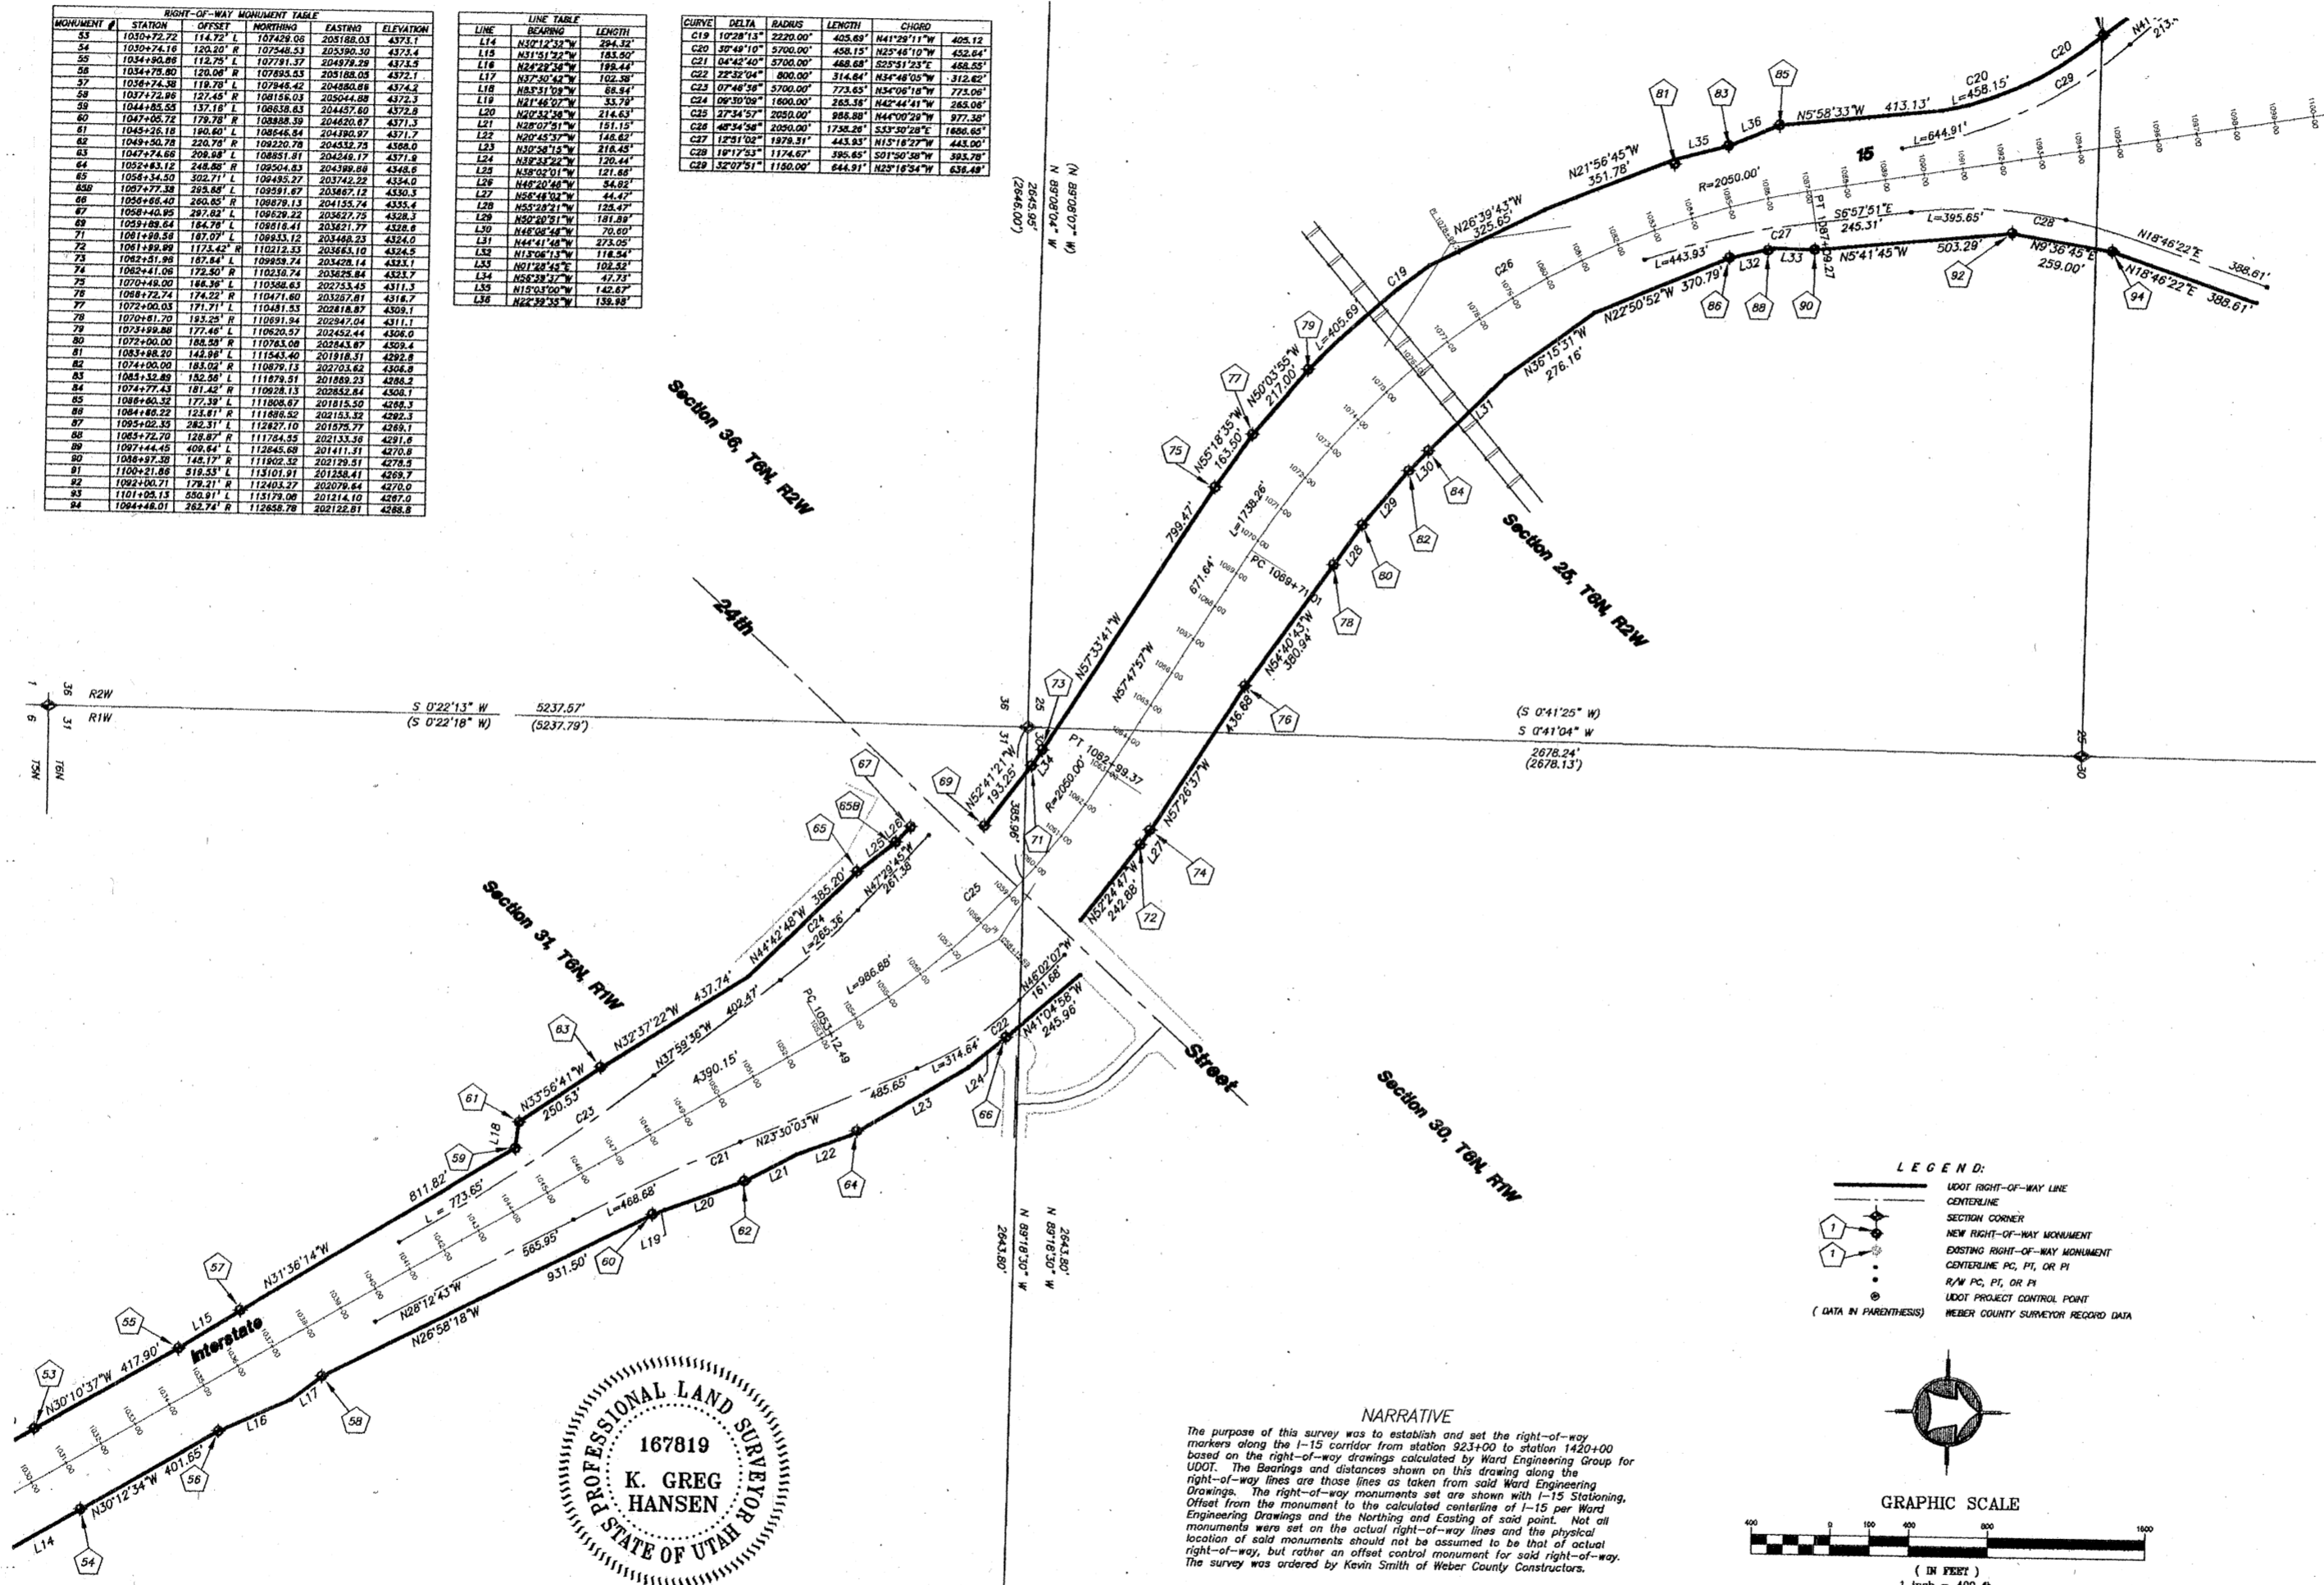

NARRATIVE
 The purpose of this survey was to establish and set the right-of-way markers along the I-15 corridor from station 923+00 to station 1420+00 based on the right-of-way drawings calculated by Ward Engineering Group for UDOT. The bearings and distances shown on this drawing along the right-of-way lines are those lines as taken from said Ward Engineering Group drawings. The right-of-way monuments set are shown with 1-15 Stationing. Offset from the monument to the calculated centerline of I-15 per Ward Engineering Group drawings and the bearing and distance to said point. Not all monuments were set on the actual right-of-way line and the physical location of said monuments should not be assumed to be that of actual right-of-way, but rather an offset control monument for said right-of-way. The survey was ordered by Kevin Smith of Weber County Constructors.


167819
 K. GREG HANSEN
 PROFESSIONAL LAND SURVEYOR
 STATE OF UTAH

| | |
|----------------------------------|-----------------|
| Drawn By: JES | Date: OCT. 2004 |
| Designed By: | |
| Checked By: | |
| Approved By: | |
| Scale: 1" = 200' | |
| Drawing File: 08-3-134.dwg | |
| JOB NUMBER: 08-3-134 | |
| Project Name: INTERSTATE 15 | |
| Project Number: SP-15-8 (34) 342 | |
| Location: WEBER COUNTY, UTAH | |

RECEIVED
 FEB 06 2009
 WEBER CO SURVEYOR

| No. | Date | By | Revision |
|-----|------|----|----------|
| | | | |

Z:\2008 Disk 4\2008\08-3-134 I-15\Drawings\08-3-134.dwg, Sheet 3 Recording, 1/30/2009 11:12:42 AM, 1:400

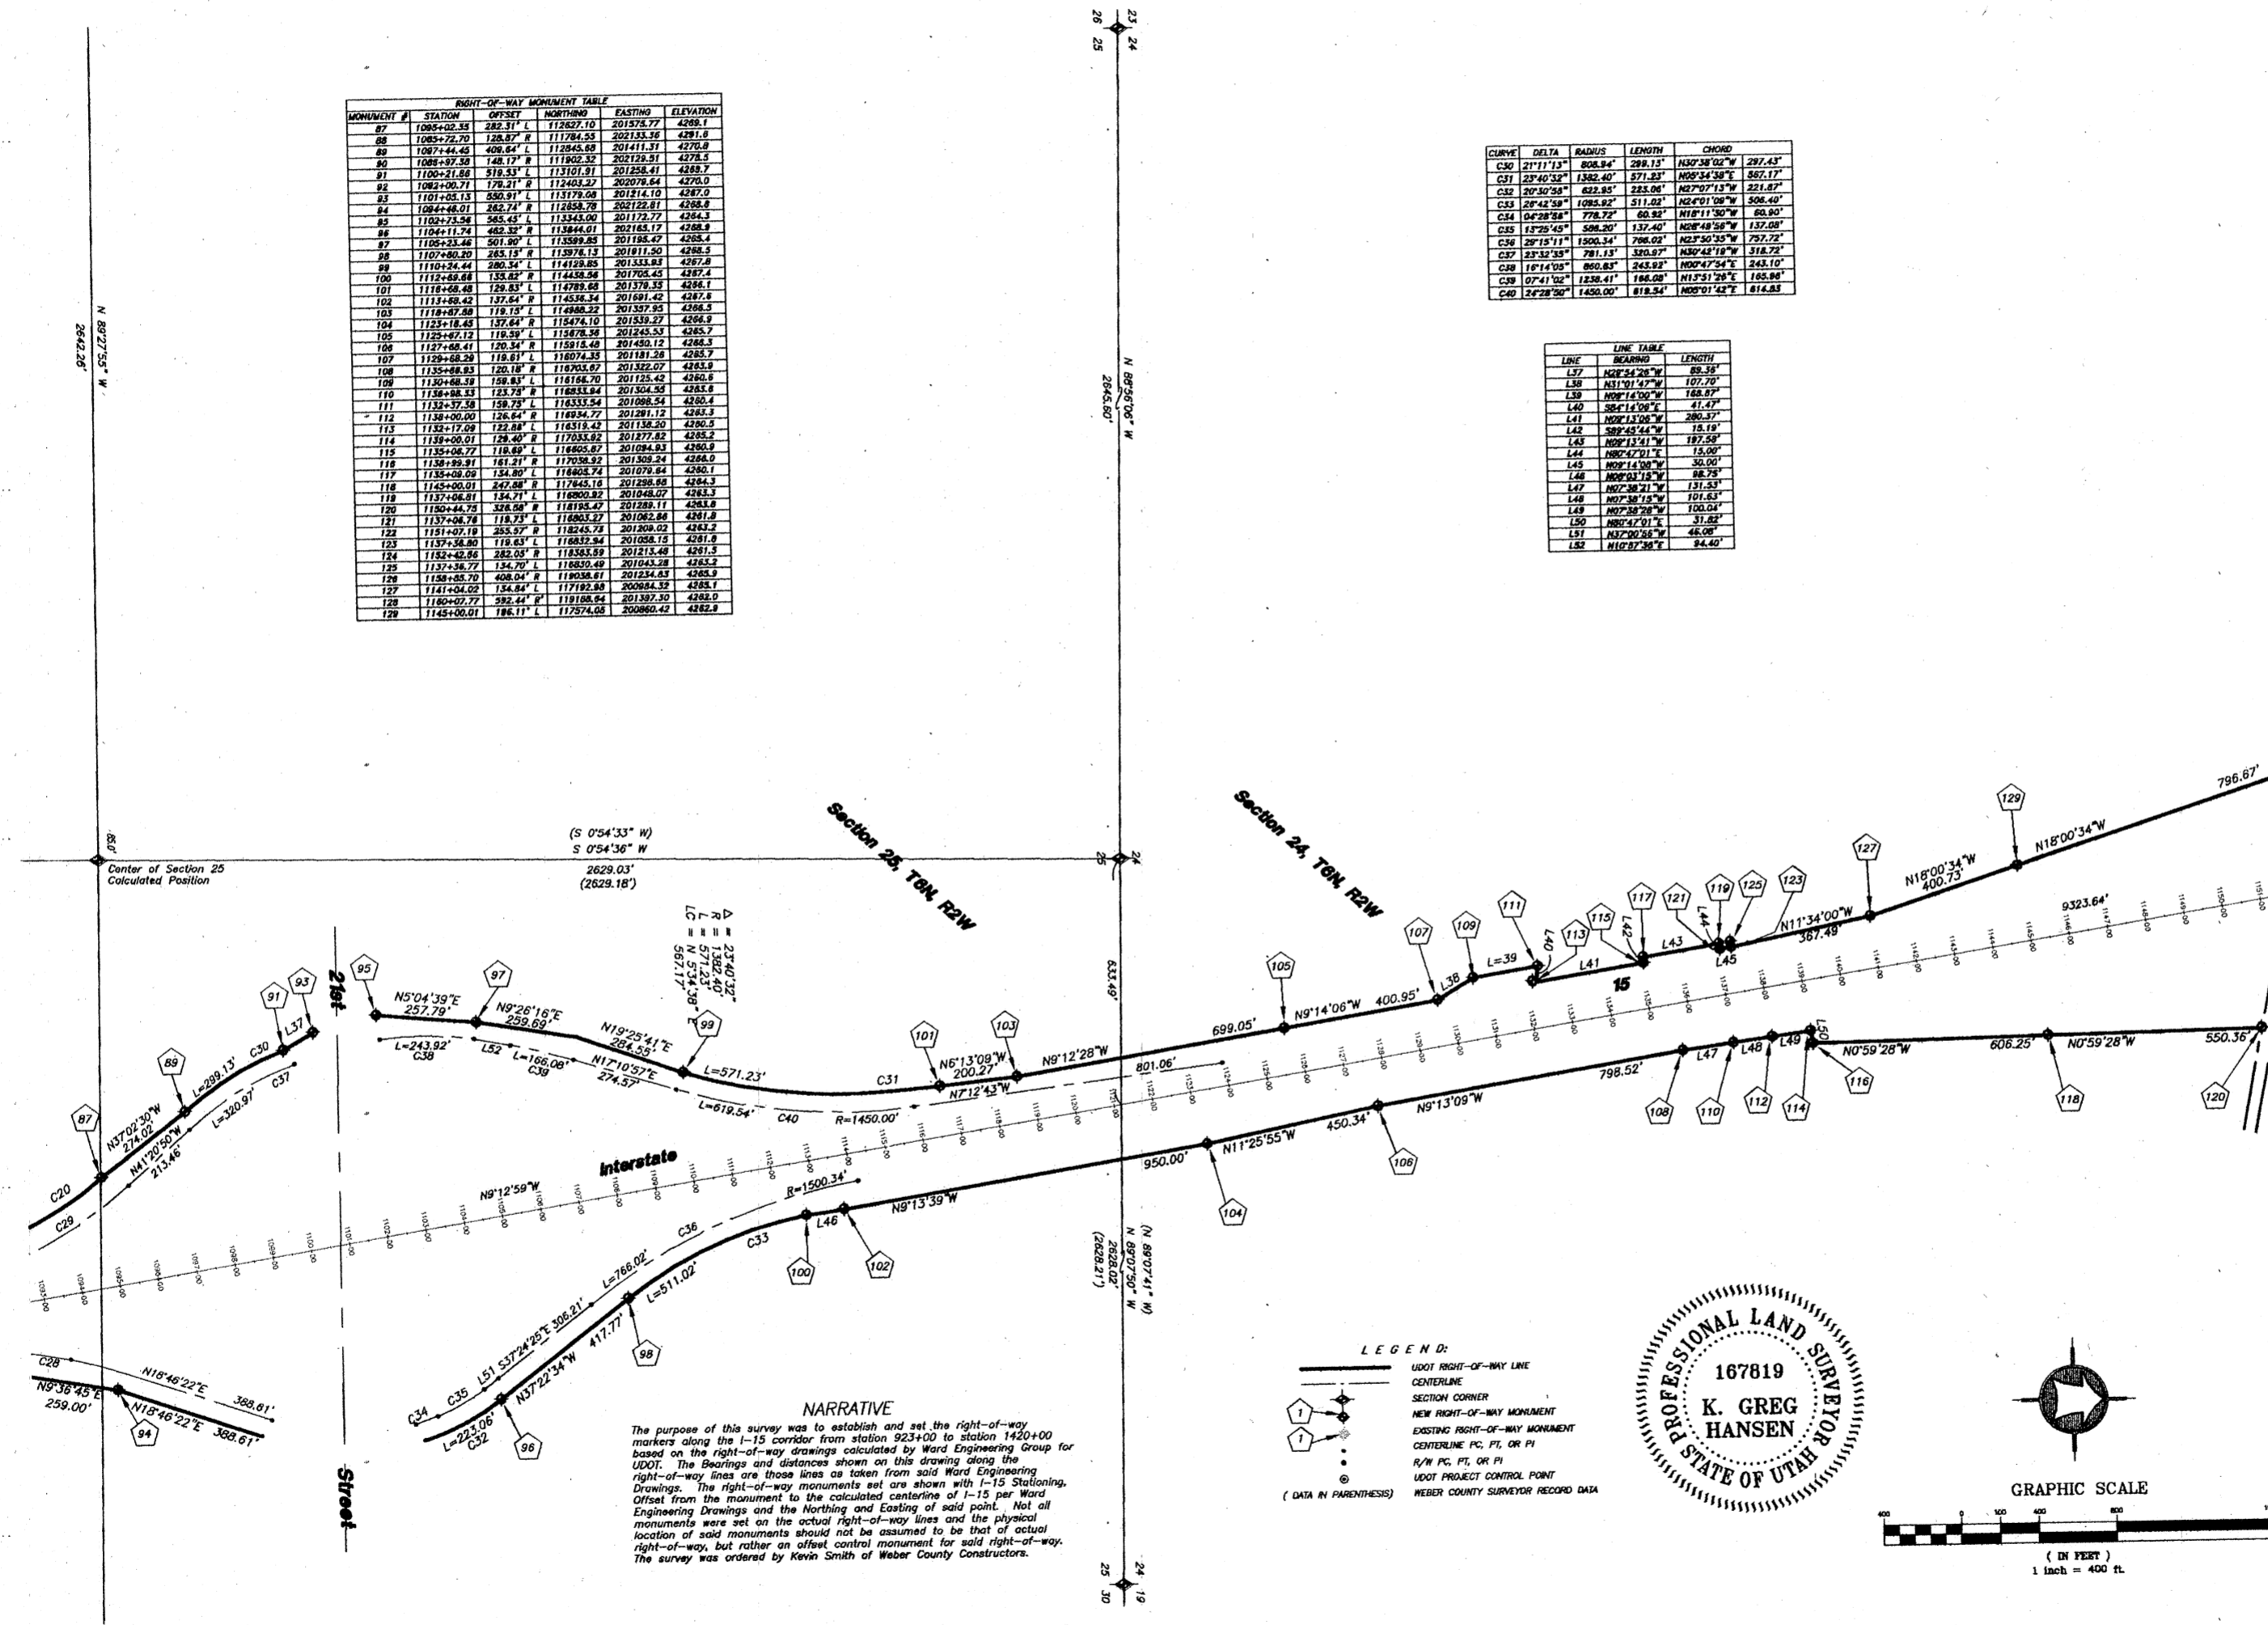

RIGHT-OF-WAY MONUMENT TABLE


LINE TABLE

| LINE | BEARING | LENGTH |
|------|-------------|---------|

NARRATIVE


The purpose of this survey was to establish and set the right-of-way markers along the I-15 corridor from station 923+00 to station 1420+00 based on the right-of-way drawings calculated by Ward Engineering Group for UDOT. The bearings and distances shown on this drawing along the right-of-way lines are those lines as taken from said Ward Engineering Drawings. The right-of-way monuments set are shown with I-15 Stationing. Offsets from the monument to the calculated centerline of I-15 per Ward Engineering Drawings and the Northing and Easting of said point. Not all monuments were set on the actual right-of-way lines and the physical location of said monuments should not be assumed to be that of actual right-of-way, but rather an offset control monument for said right-of-way. The survey was ordered by Kevin Smith of Weber County Constructors.

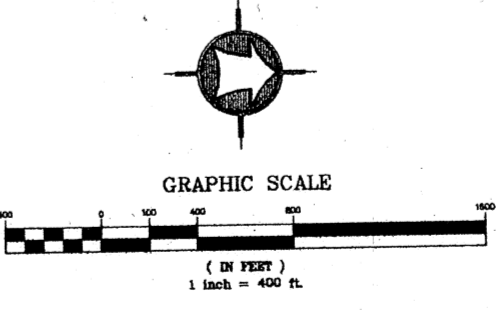

| | | |
|--|--|--|

| <p>Drawn By: JES Date: OCT. 2004</p> <p>Designed By: _____</p> <p>Checked By: _____</p> <p>Approved By: _____</p> <p>Scale: 1" = 200'</p> <p>Drawing File: 08-3-134.dwg</p> <p>JOB NUMBER: 08-3-134</p> | | <p>SHEET</p> <p>4</p> <p>OF</p> <p>9</p> <p>SHEETS</p> |

004267
RECEIVED
FEB 06 2009
WEBER CO SURVEYOR

Z:\2008 Disk 4\2008\08-3-134-1-15\drawings\08-3-134.dwg, Sheet 5 Recording, 1/30/2009 11:12:47 AM, 1:400


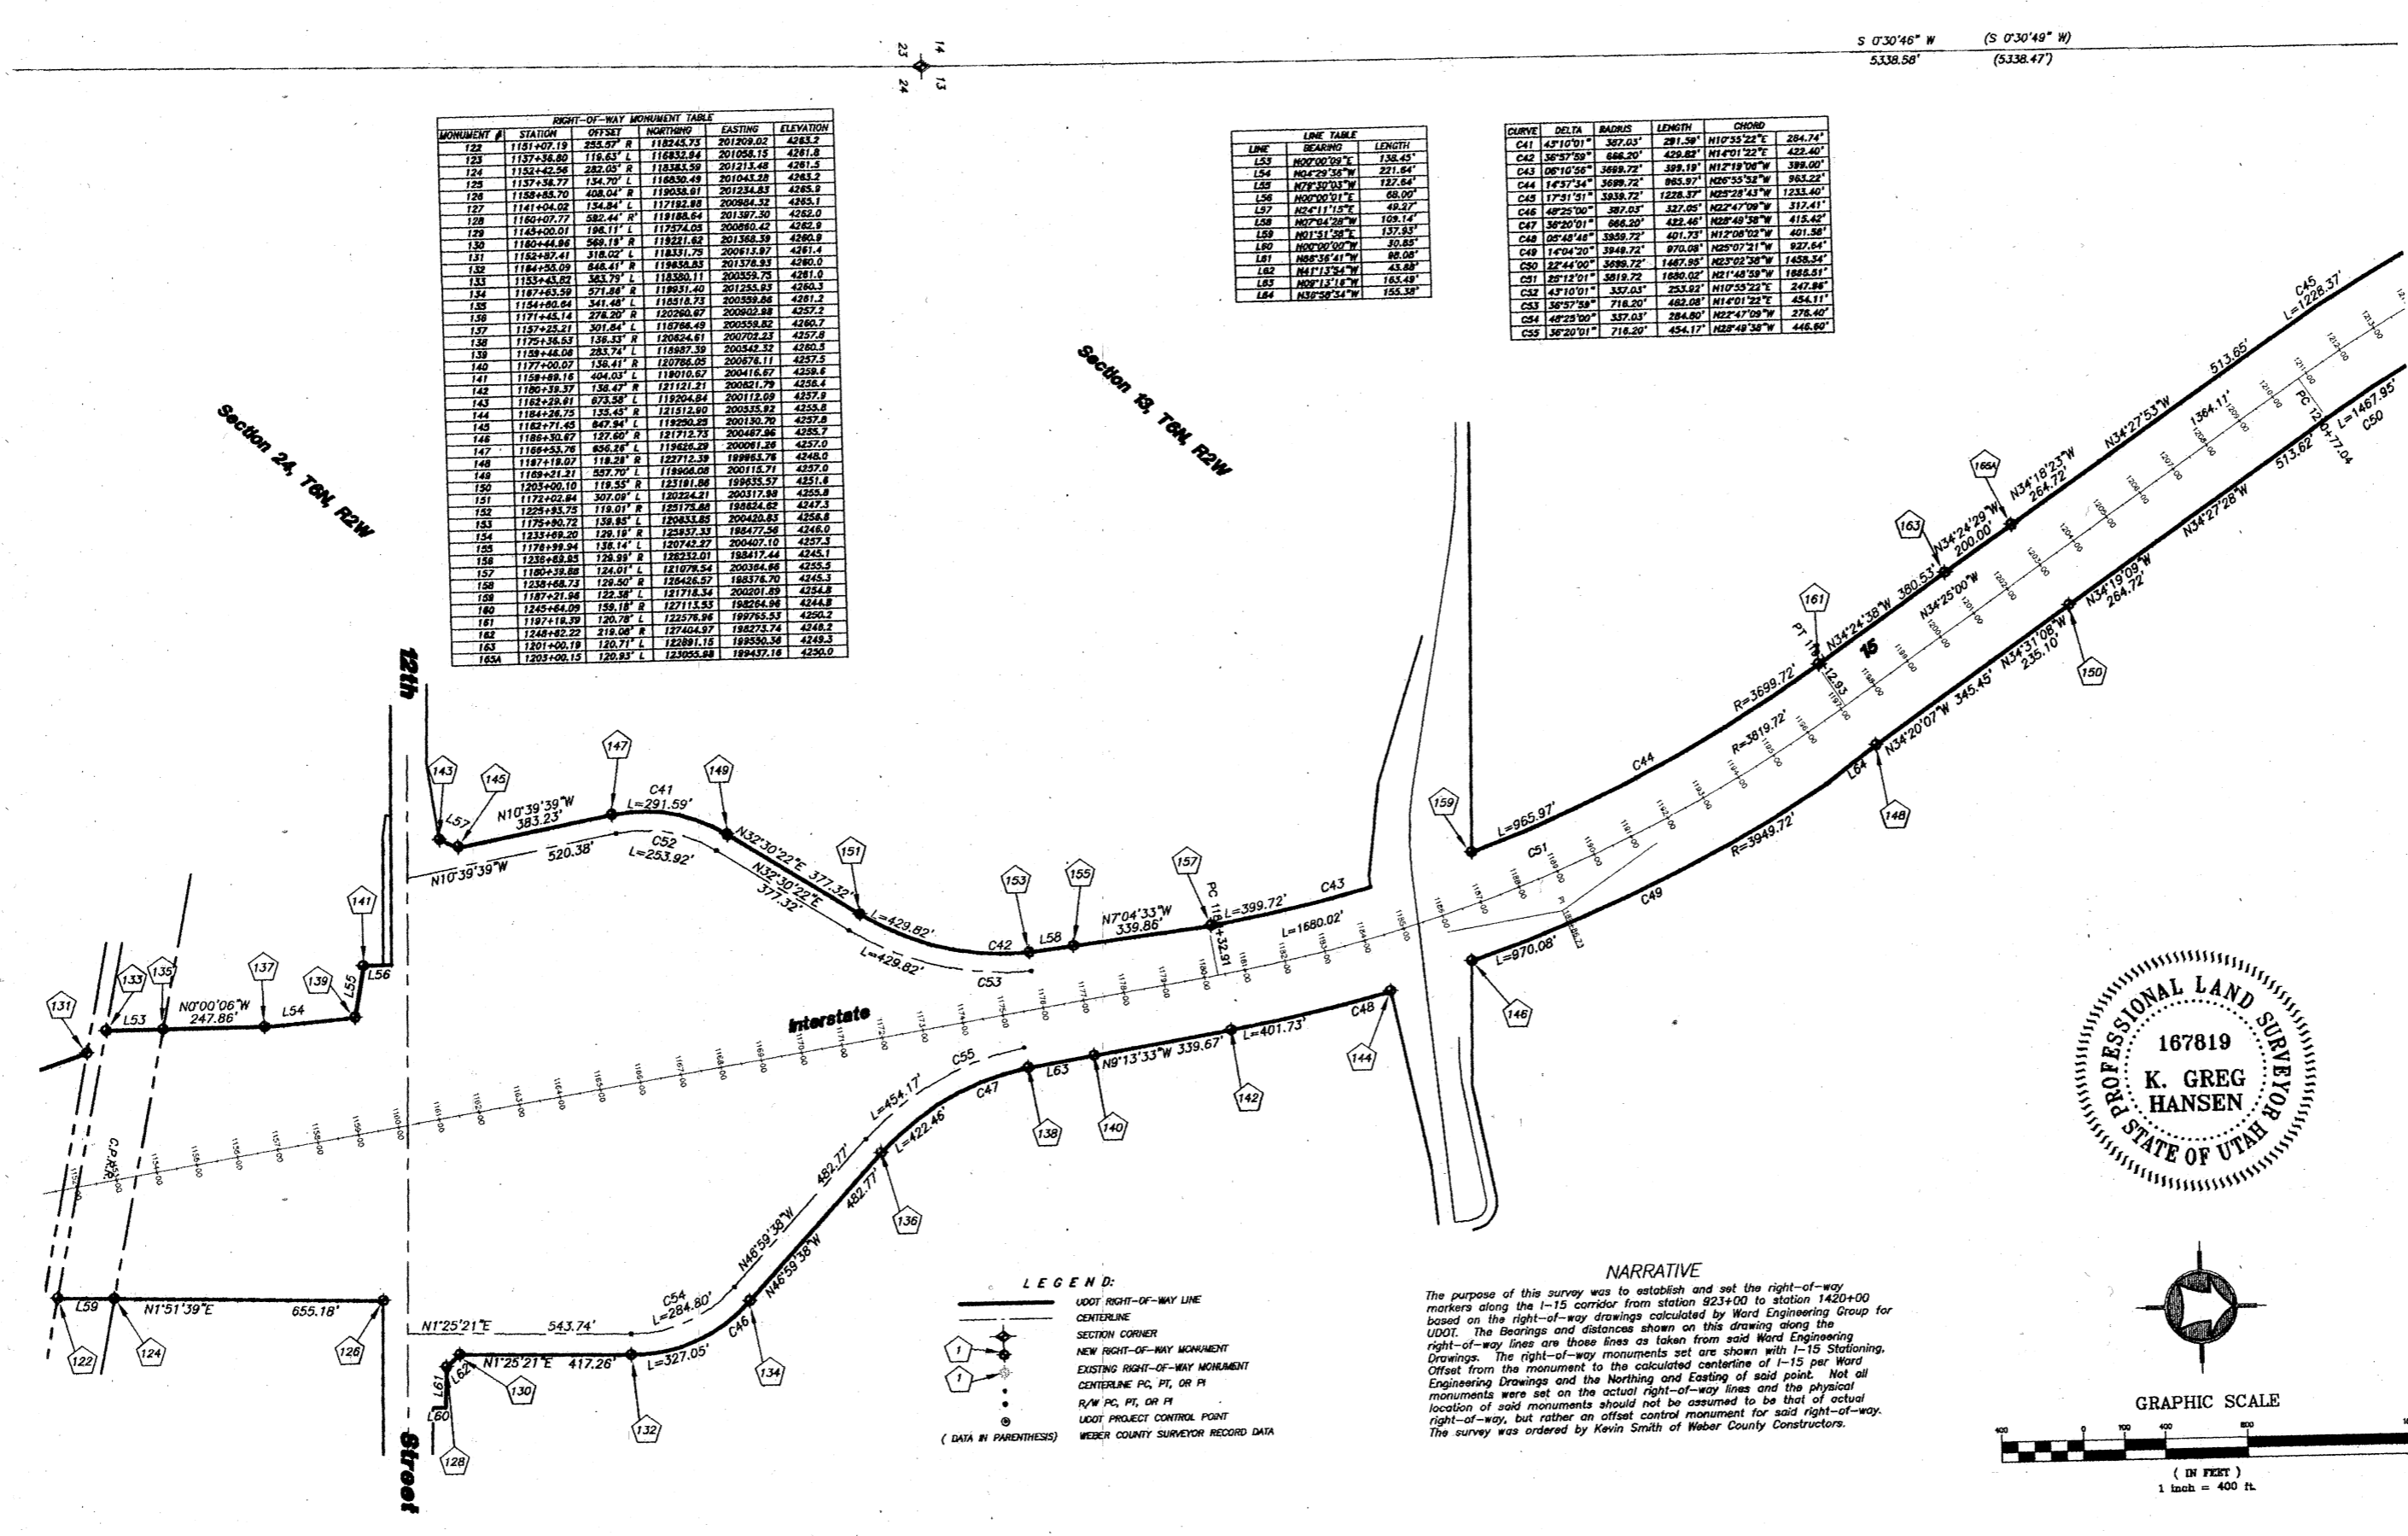



| LINE | Bearing | Length |
|------|--------------|---------|


S 0°30'46" W (S 0°30'46" W)
5338.58' (5338.47')

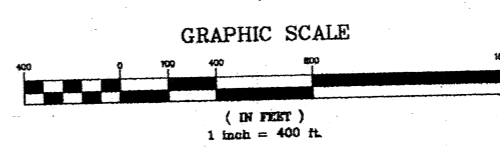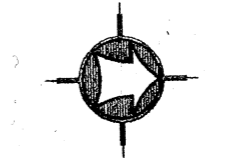


LEGEND:
 UDOT RIGHT-OF-WAY LINE
 CENTERLINE
 SECTION CORNER
 NEW RIGHT-OF-WAY MONUMENT
 EXISTING RIGHT-OF-WAY MONUMENT
 CENTERLINE PC, PT, OR PI
 R/W PC, PT, OR PI
 UDOT PROJECT CONTROL POINT
 WEBER COUNTY SURVEYOR RECORD DATA
 (DATA IN PARENTHESES)

NARRATIVE
 The purpose of this survey was to establish and set the right-of-way markers along the I-15 corridor from station 923+00 to station 1420+00 based on the right-of-way drawings calculated by Ward Engineering Group for UDOT. The bearings and distances shown on this drawing along the right-of-way lines are those lines as taken from said Ward Engineering Drawings. The right-of-way monuments set are shown with I-15 Stationing. Offset from the monument to the calculated centerline of I-15 per Ward Engineering Drawings and the Northing and Easting of said point. Not all monuments were set on the actual right-of-way lines and the physical location of said monuments should not be assumed to be that of actual right-of-way, but rather an offset control monument for said right-of-way. The survey was ordered by Kevin Smith of Weber County Constructors.

004267
RECEIVED
 FEB 06 2009
 WEBER CO SURVEYOR

| | | |
|---|--|---|
| HANSEN & ASSOCIATES, INC. Consulting Engineers and Land Surveyors 638 North Main Brigham City, Utah 84302 67 East 100 North Logan, Utah 84301 Ogden (435) 752-8197 (435) 723-5401 (435) 723-7663 (601) 369-4805 (435) 752-8272 | | No. _____ Date _____ By _____ Revision _____ |
| Drawn By: JES Date: OCT. 2004 Designed By: _____ Checked By: _____ Approved By: _____ Scale: 1" = 200' Drawing File: 08-3-134.dwg JOB NUMBER: 08-3-134 | | SHEET 5 OF 9 SHEETS |
| Right-Of-Way Survey for INTERSTATE 15 SP-15-8 (34) 342 WEBER COUNTY, UTAH | | |

Z:\2008 Disk 4\2008\08-3-134-I-15\drawings\08-3-134.dwg, Sheet 6 Recording, 1/30/2009 11:12:51 AM, 1:400

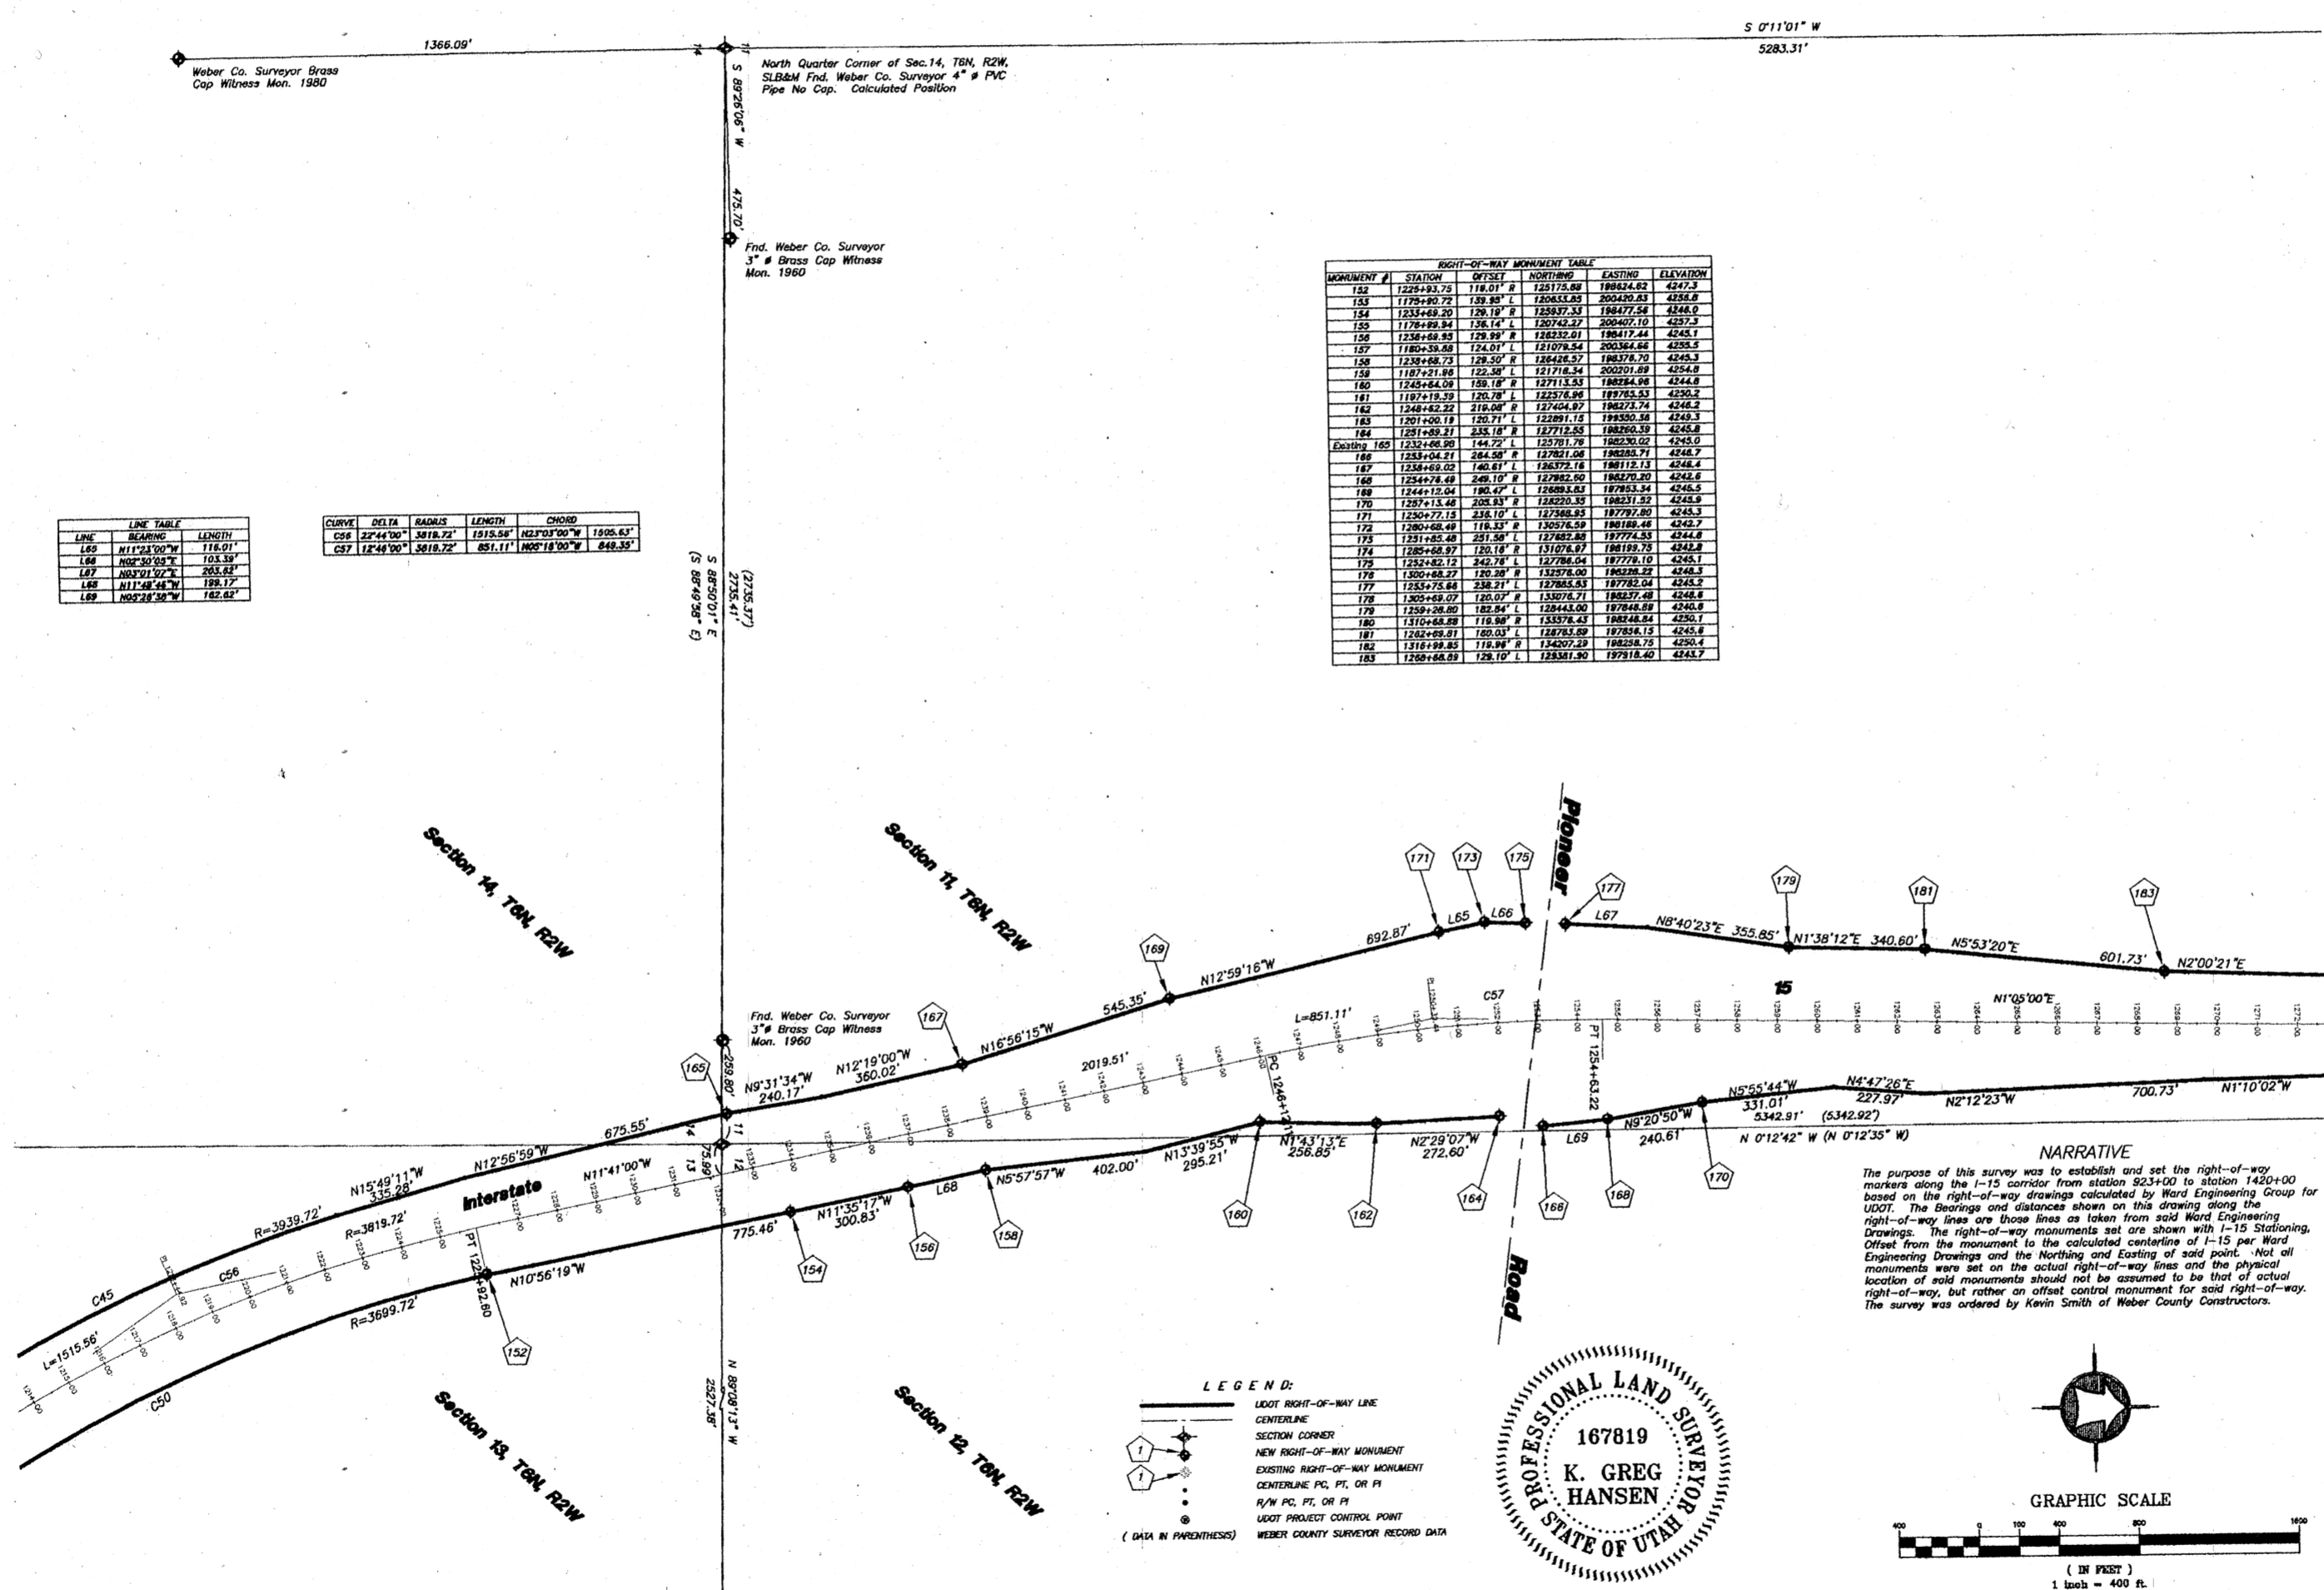


| LINE | BEARING | LENGTH |
|------|-------------|---------|

| CURVE | DELTA | RADIUS | LENGTH | CHORD |
|-------|-----------|----------|----------|---------------------|


NARRATIVE
 The purpose of this survey was to establish and set the right-of-way markers along the I-15 corridor from station 823+00 to station 1420+00 based on the right-of-way drawings calculated by Ward Engineering Group for UDOT. The bearings and distances shown on this drawing along the right-of-way lines are those lines as taken from said Ward Engineering Drawings. The right-of-way monuments set are shown with I-15 Stationing. Offset from the monument to the calculated centerline of I-15 per Ward Engineering Drawings and the Northing and Easting of said point. Not all monuments were set on the actual right-of-way lines and the physical location of said monuments should not be assumed to be that of actual right-of-way, but rather an offset control monument for said right-of-way. The survey was ordered by Kevin Smith of Weber County Constructors.

LEGEND:
 CENTERLINE
 SECTION CORNER
 NEW RIGHT-OF-WAY MONUMENT
 EXISTING RIGHT-OF-WAY MONUMENT
 CENTERLINE P.C., P.T., OR P.I.
 R/W P.C., P.T., OR P.I.
 (DATA IN PARENTHESES)
 WEBER COUNTY SURVEYOR RECORD DATA

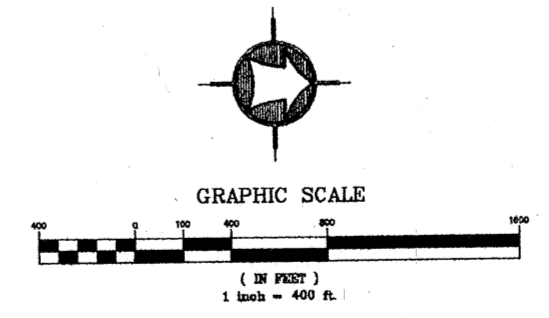


| No. | Date | By | Revision |
|-----|------|----|----------|
| | | | |


HANSEN & ASSOCIATES, INC.
 Consulting Engineers and Land Surveyors
 538 North Main
 Brigham City, Utah 84302
 67 East 100 North
 Logan, Utah 84301
 (435) 752-9197
 (435) 399-9005
 (801) 723-7663

Drawn By: JES Date: OCT. 2004
 Designed By: _____
 Checked By: _____
 Approved By: _____
 Scale: 1" = 200'
 Drawing File: 08-3-134.dwg
 JOB NUMBER: 08-3-134

Right-Of-Way Survey for
INTERSTATE 15
SP-15-8 (34) 342
 WEBER COUNTY, UTAH

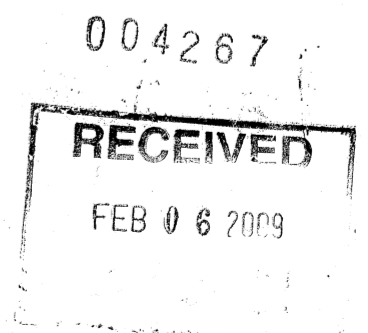

SHEET
6
 OF
9
 SHEETS

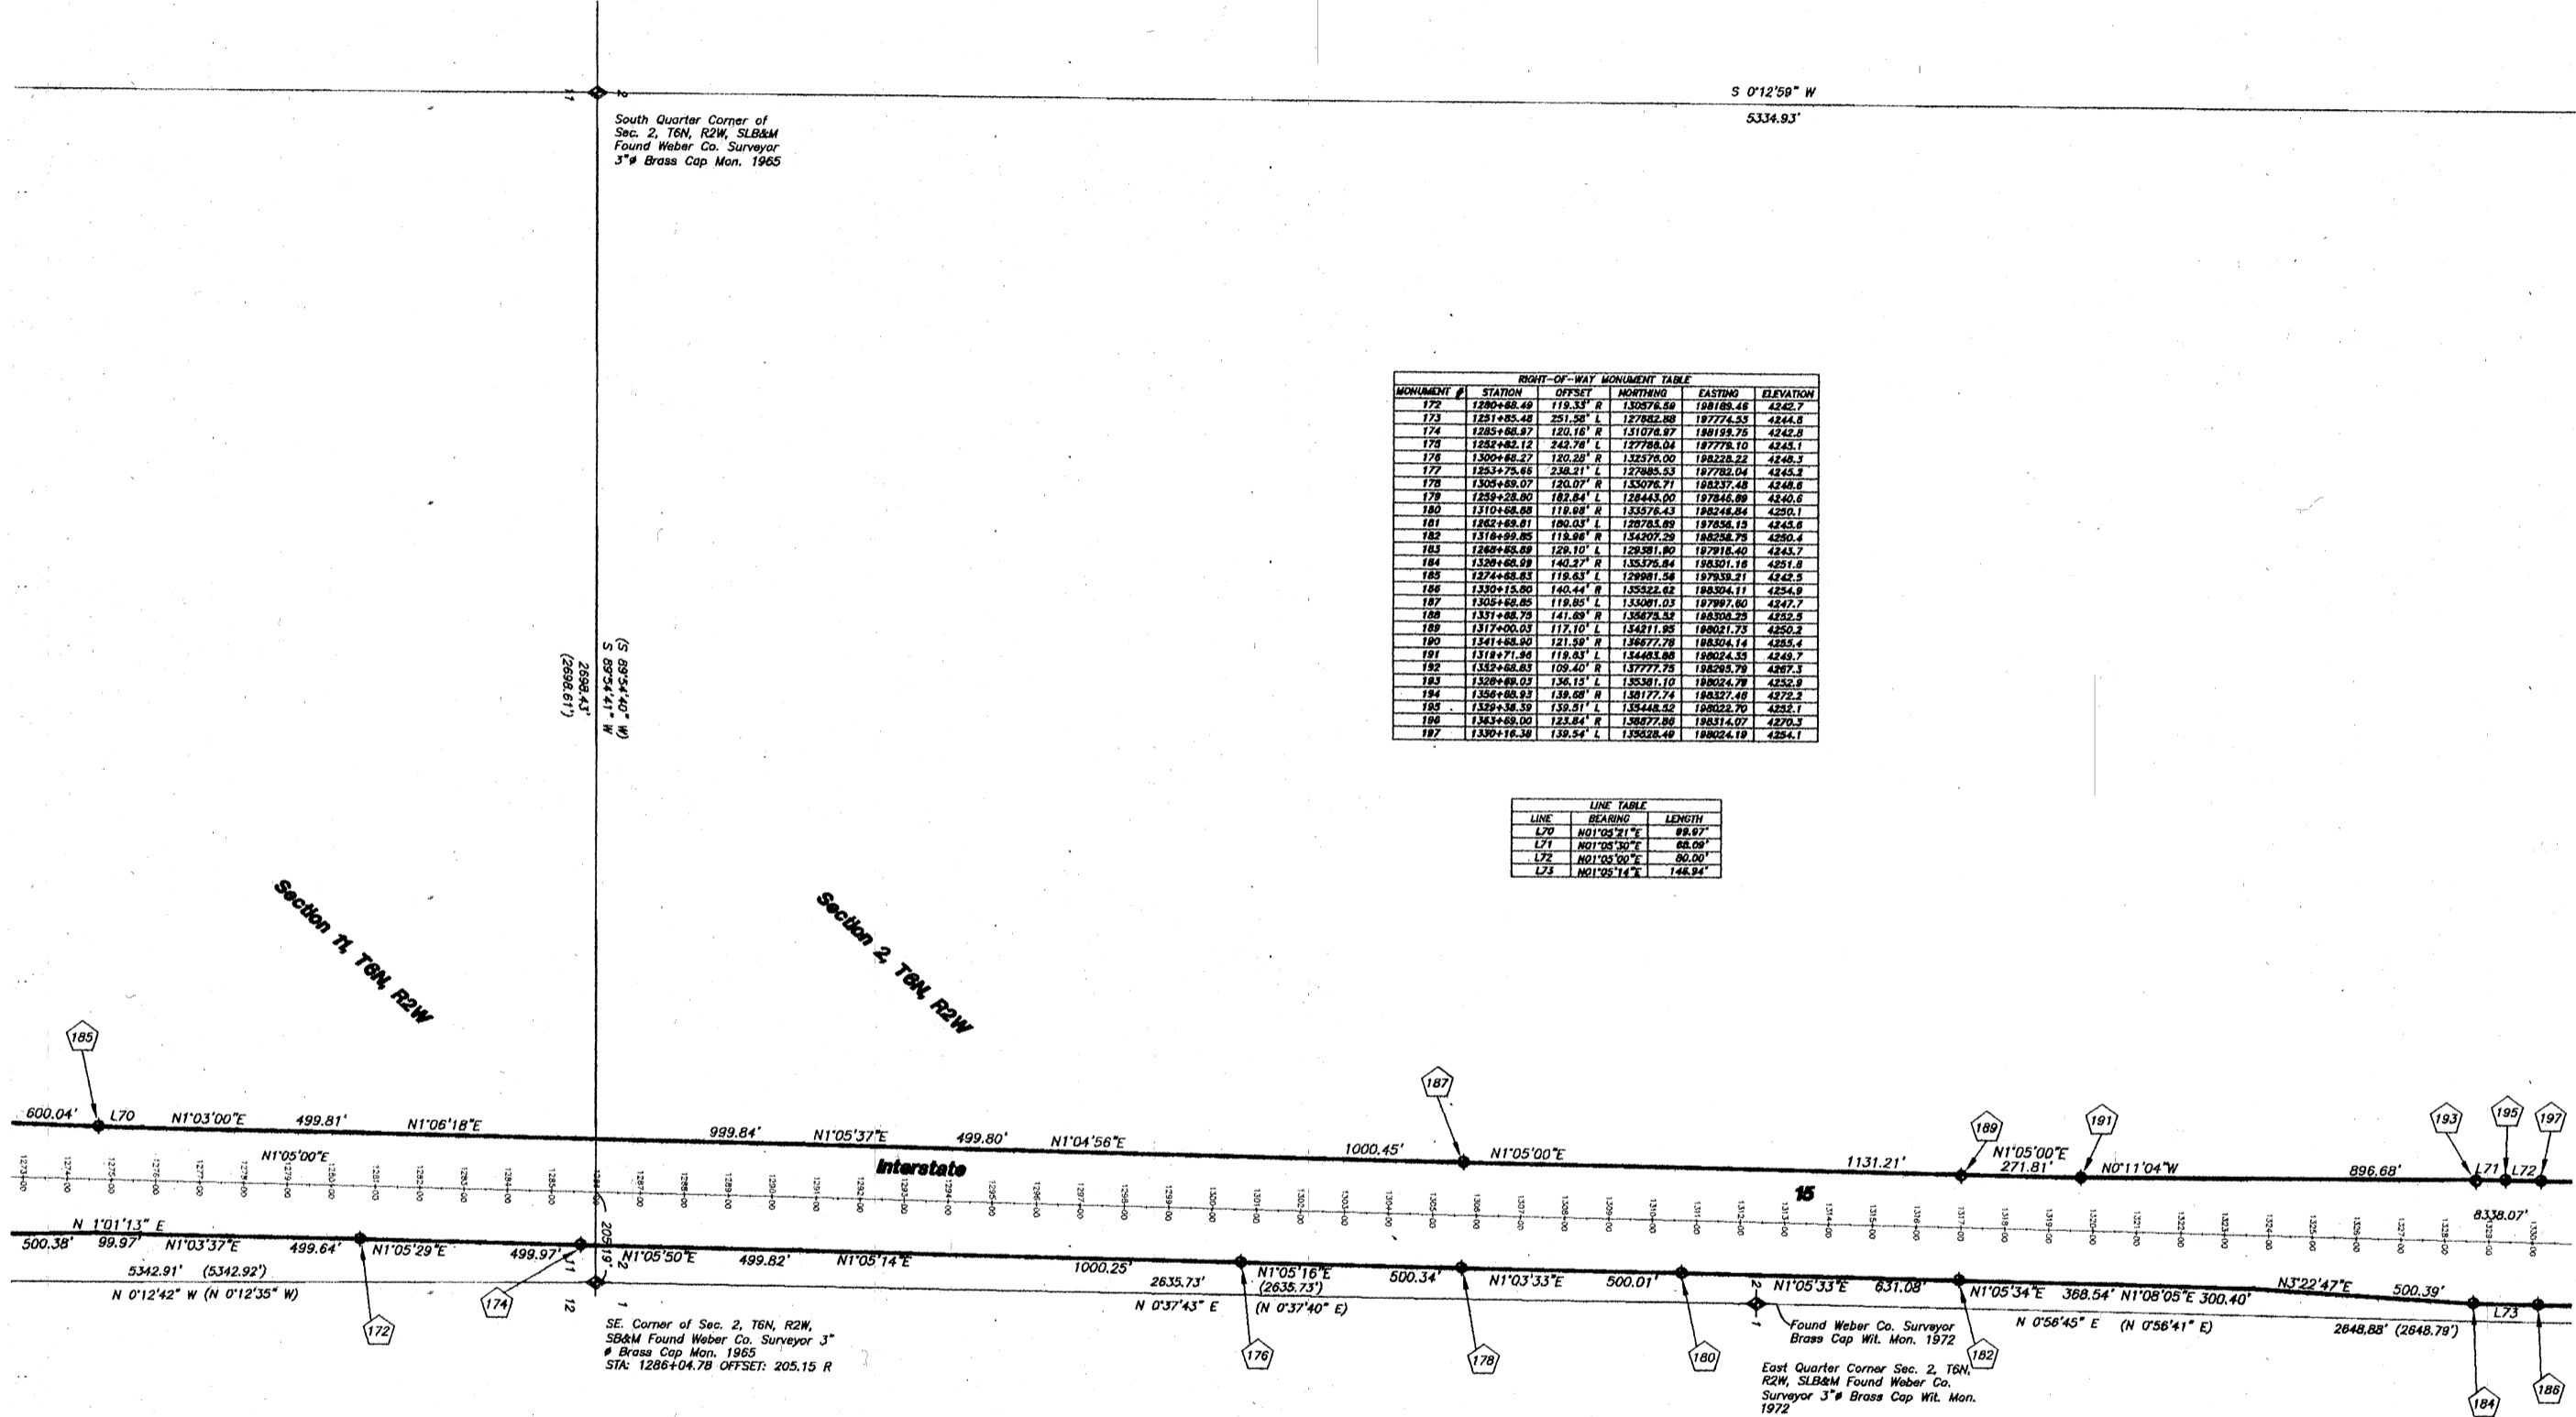


| MONUMENT # | STATION | OFFSET | NORTHING | EASTING | ELEVATION |
|------------|------------|-----------|-----------|-----------|-----------|

| LINE | BEARING | LENGTH |
|------|----------------|--------|



LEGEND:
 CENTERLINE
 SECTION CORNER
 NEW RIGHT-OF-WAY MONUMENT
 EXISTING RIGHT-OF-WAY MONUMENT
 CENTERLINE PC, PT, OR PI
 R/W PC, PT, OR PI
 UDOT PROJECT CONTROL POINT
 WEBER COUNTY SURVEYOR RECORD DATA
 (DATA IN PARENTHESES)

NARRATIVE
 The purpose of this survey was to establish and set the right-of-way markers along the I-15 corridor from station 923+00 to station 1420+00 based on the right-of-way drawings calculated by Ward Engineering Group for UDOT. The bearings and distances shown on this drawing along the right-of-way lines are those lines as given from said Ward Engineering Drawings. The right-of-way monuments set are shown with I-15 Stationing. Offset from the monument to the calculated centerline of I-15 per Ward Engineering Drawings and the Northing and Easting of said point. Not all monuments were set on the actual right-of-way lines and the physical location of said monuments should not be assumed to be that of actual right-of-way, but rather an offset control monument for said right-of-way. The survey was ordered by Kevin Smith of Weber County Constructors.

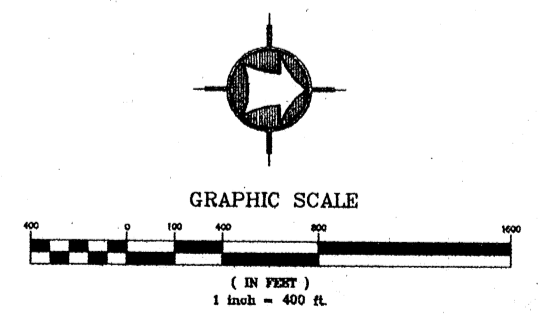

004267
RECEIVED
 FEB 06 2009
 WEBER CO SURVEYOR


Drawn By: JES Date: OCT. 2004
 Designed By: _____
 Checked By: _____
 Approved By: _____
 Scale: 1" = 200'
 Drawing File: 08-3-134.dwg
 JOB NUMBER: 08-3-134

HANSEN & ASSOCIATES, INC.
 Consulting Engineers and Land Surveyors
 538 North Main
 67 East 100 North
 Brigham City, Utah 84302
 Logan, Utah 84321
 Ogden, Utah (435) 752-8197
 (435) 723-3491
 (435) 723-7663 (801) 399-4905 (435) 752-8272

INTERSTATE 15
 SP-15-8 (34) 342
 WEBER COUNTY, UTAH

SHEET 7 OF 9 SHEETS

Z:\2008 Disk 4\2008\08-3-134 1-15\Drawings\08-3-134.dwg, Sheet 7 Recording, 1/30/2009 11:12:53 AM, 1:400

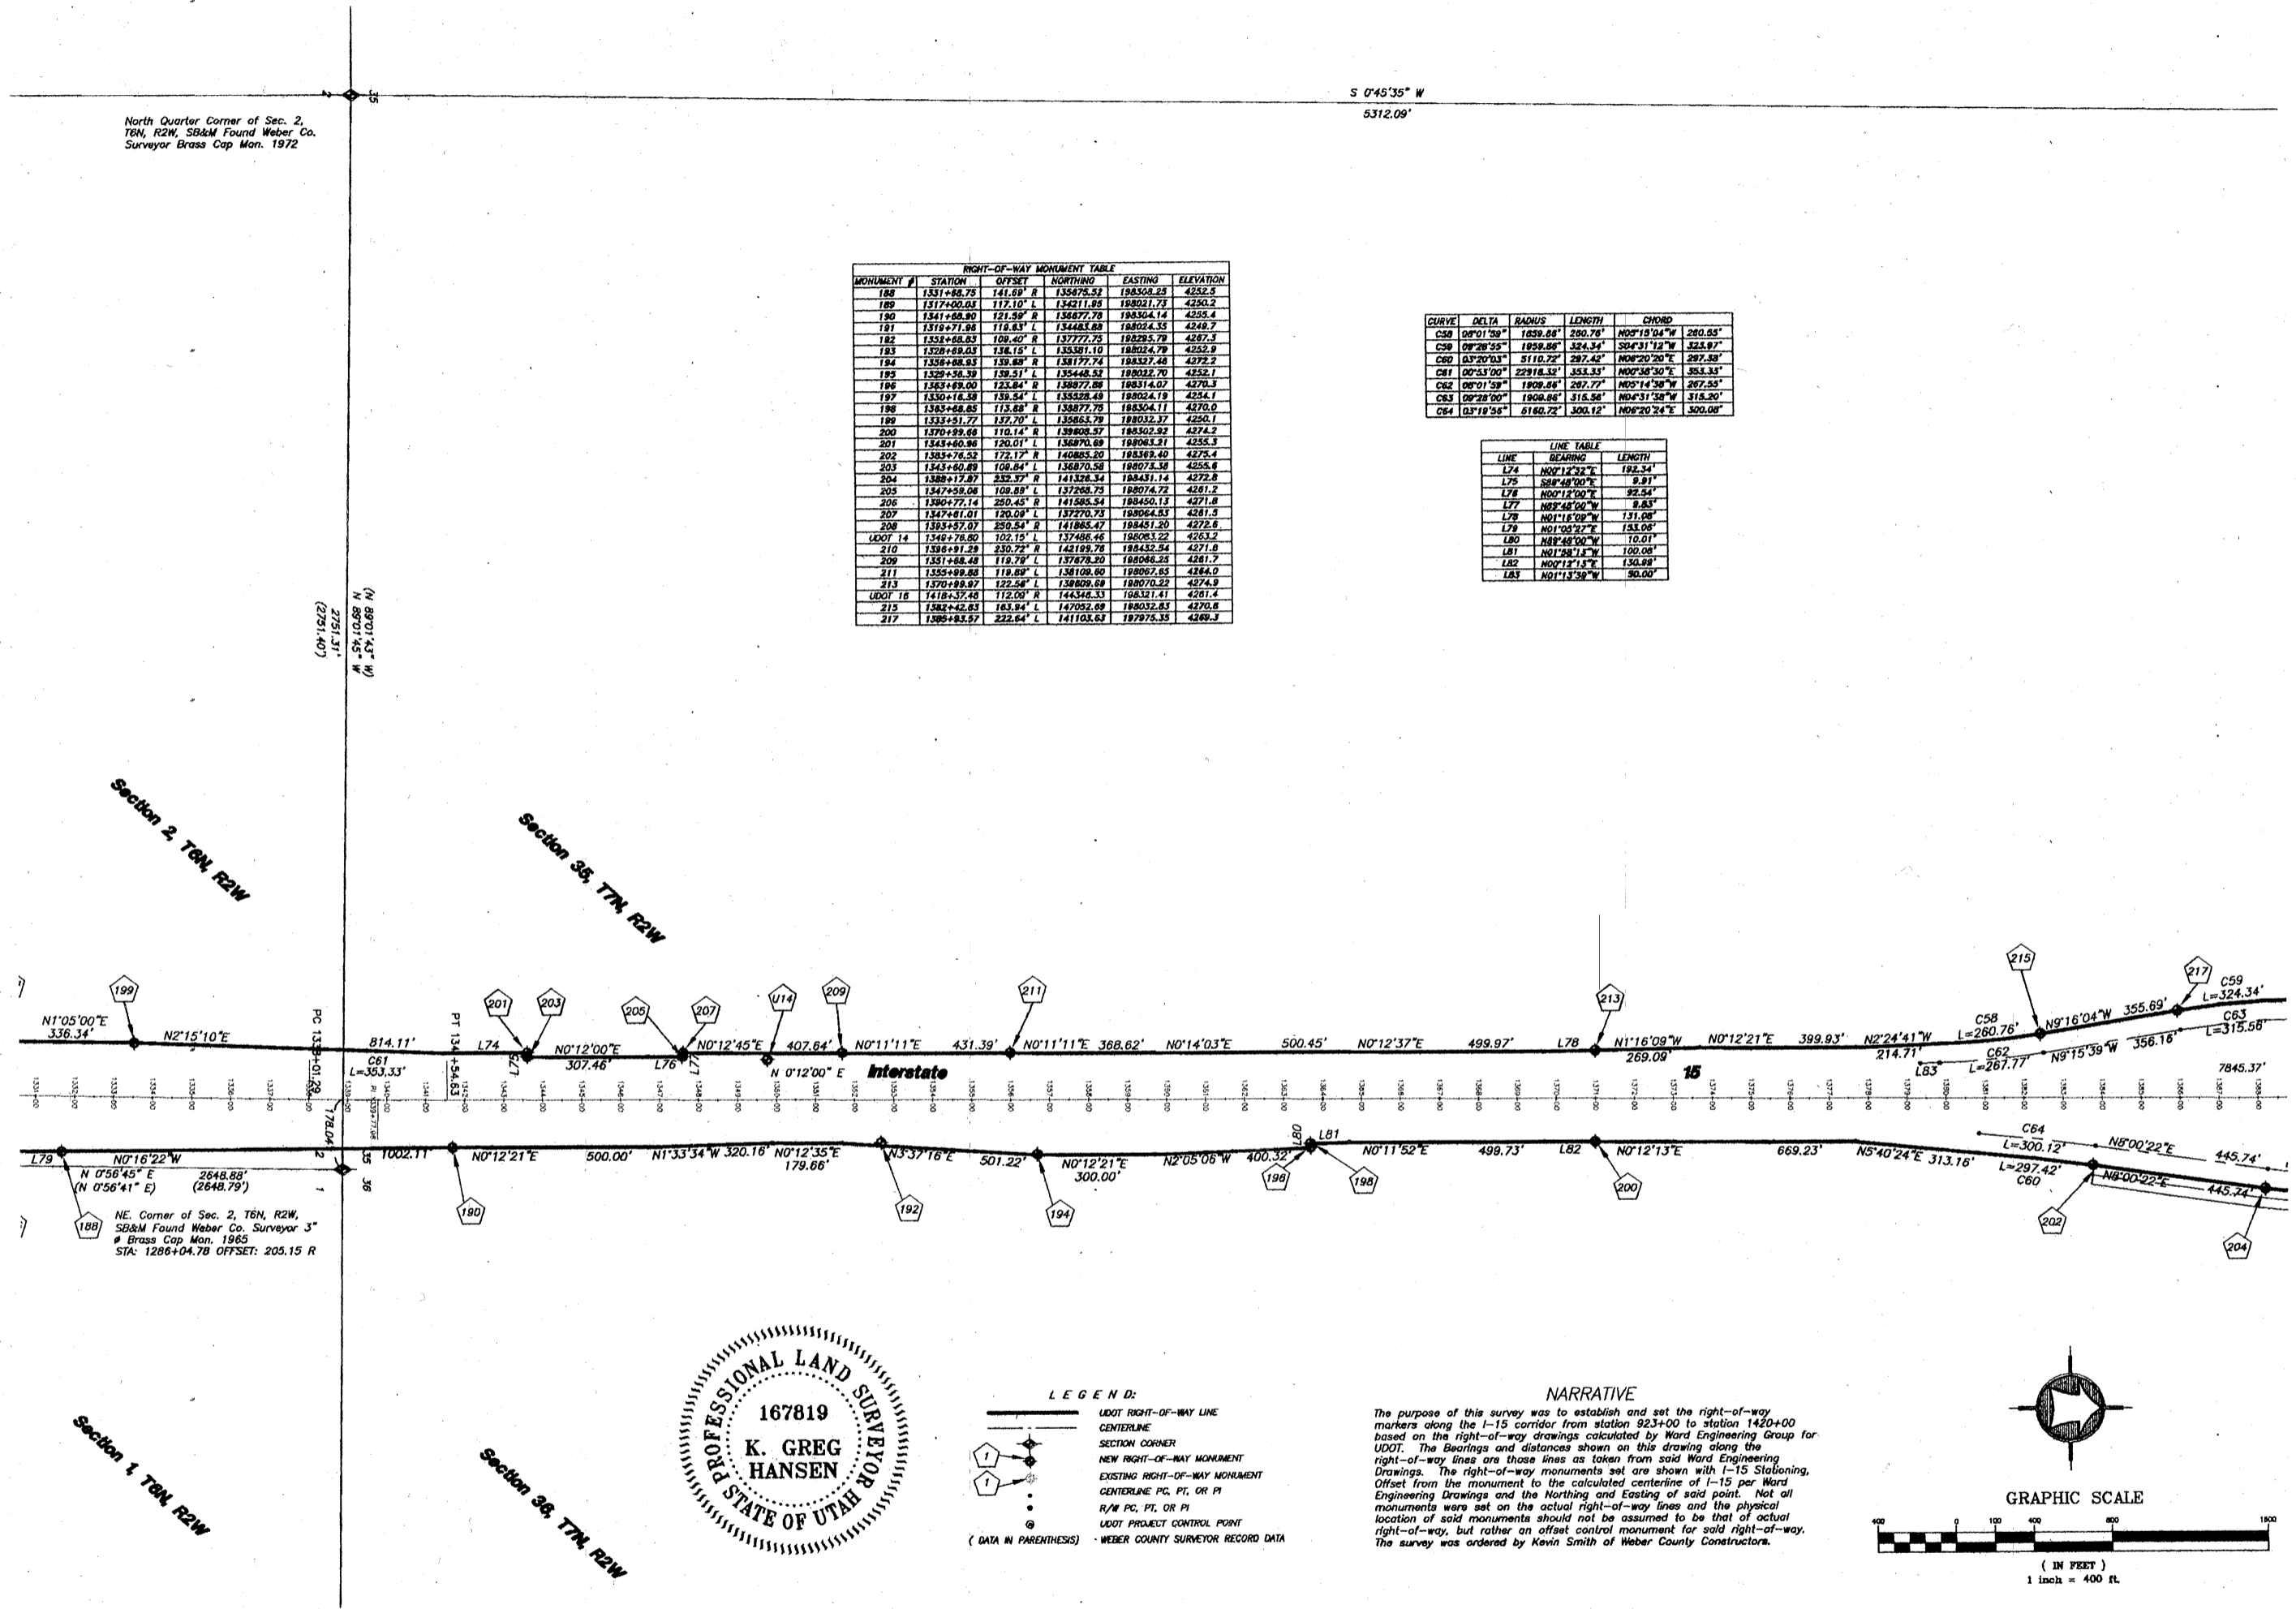

North Quarter Corner of Sec. 2,
T6N, R2W, S8&M Found Weber Co.
Surveyor Brass Cap Mon. 1972

S 0°45'35" W
5312.09'

| MONUMENT # | STATION | OFFSET | NORTHING | EASTING | ELEVATION |
|------------|------------|-----------|-----------|-----------|-----------|


| CURVE | DELTA | RADIUS | LENGTH | CHORD |
|-------|----------|-----------|---------|---------------------|

| L81 | N0°12'00"E | 100.00' |
| L82 | N0°12'13"E | 130.89' |
| L83 | N0°11'52"W | 90.00' |



LEGEND:
 UDOT RIGHT-OF-WAY LINE
 CENTERLINE
 SECTION CORNER
 NEW RIGHT-OF-WAY MONUMENT
 EXISTING RIGHT-OF-WAY MONUMENT
 CENTERLINE P.C., P.I., OR P.T.
 1/4 M. P.C., P.I., OR P.T.
 LEFT PROJECT CONTROL POINT
 WEBER COUNTY SURVEYOR RECORD DATA
 (DATA IN PARENTHESES)

NARRATIVE
 The purpose of this survey was to establish and set the right-of-way markers along the I-15 corridor from station 923+00 to station 1420+00 based on the right-of-way drawings calculated by Ward Engineering Group for UDOT. The Bearings and distances shown on this drawing along the right-of-way lines are those lines as taken from said Ward Engineering Drawings. The right-of-way monuments set are shown with 1-15 Stationing. Offset from the monument to the calculated centerline of I-15 per Ward Engineering Drawings and the Northing and Easting of said point. Not all monuments were set on the actual right-of-way lines and the physical location of said monuments should not be assumed to be that of actual right-of-way, but rather an offset control monument for said right-of-way. The survey was ordered by Kevin Smith of Weber County Constructors.

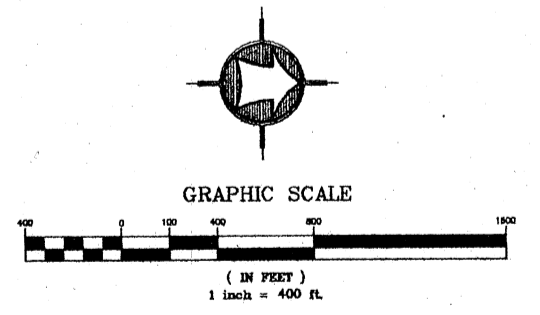

004267


RECEIVED
 FEB 06 2009
 WEBER CO SURVEYOR

HANSEN & ASSOCIATES, INC.
 Consulting Engineers and Land Surveyors
 538 North Main
 67 East 100 North
 Brigham City, Utah 84302
 Logan, Utah 84321
 Ogden, Utah (435) 752-9197
 (435) 723-3491
 (801) 399-4905 (435) 752-8272

Drawn By: JES Date: OCT. 2004
 Designed By: _____
 Checked By: _____
 Approved By: _____
 Scale: 1" = 200'
 Drawing File: 08-3-134.dwg
 JOB NUMBER: 08-3-134

Right-Of-Way Survey for
INTERSTATE 15
SP-15-8 (34) 342
 WEBER COUNTY, UTAH

SHEET
8
 OF
9
 SHEETS

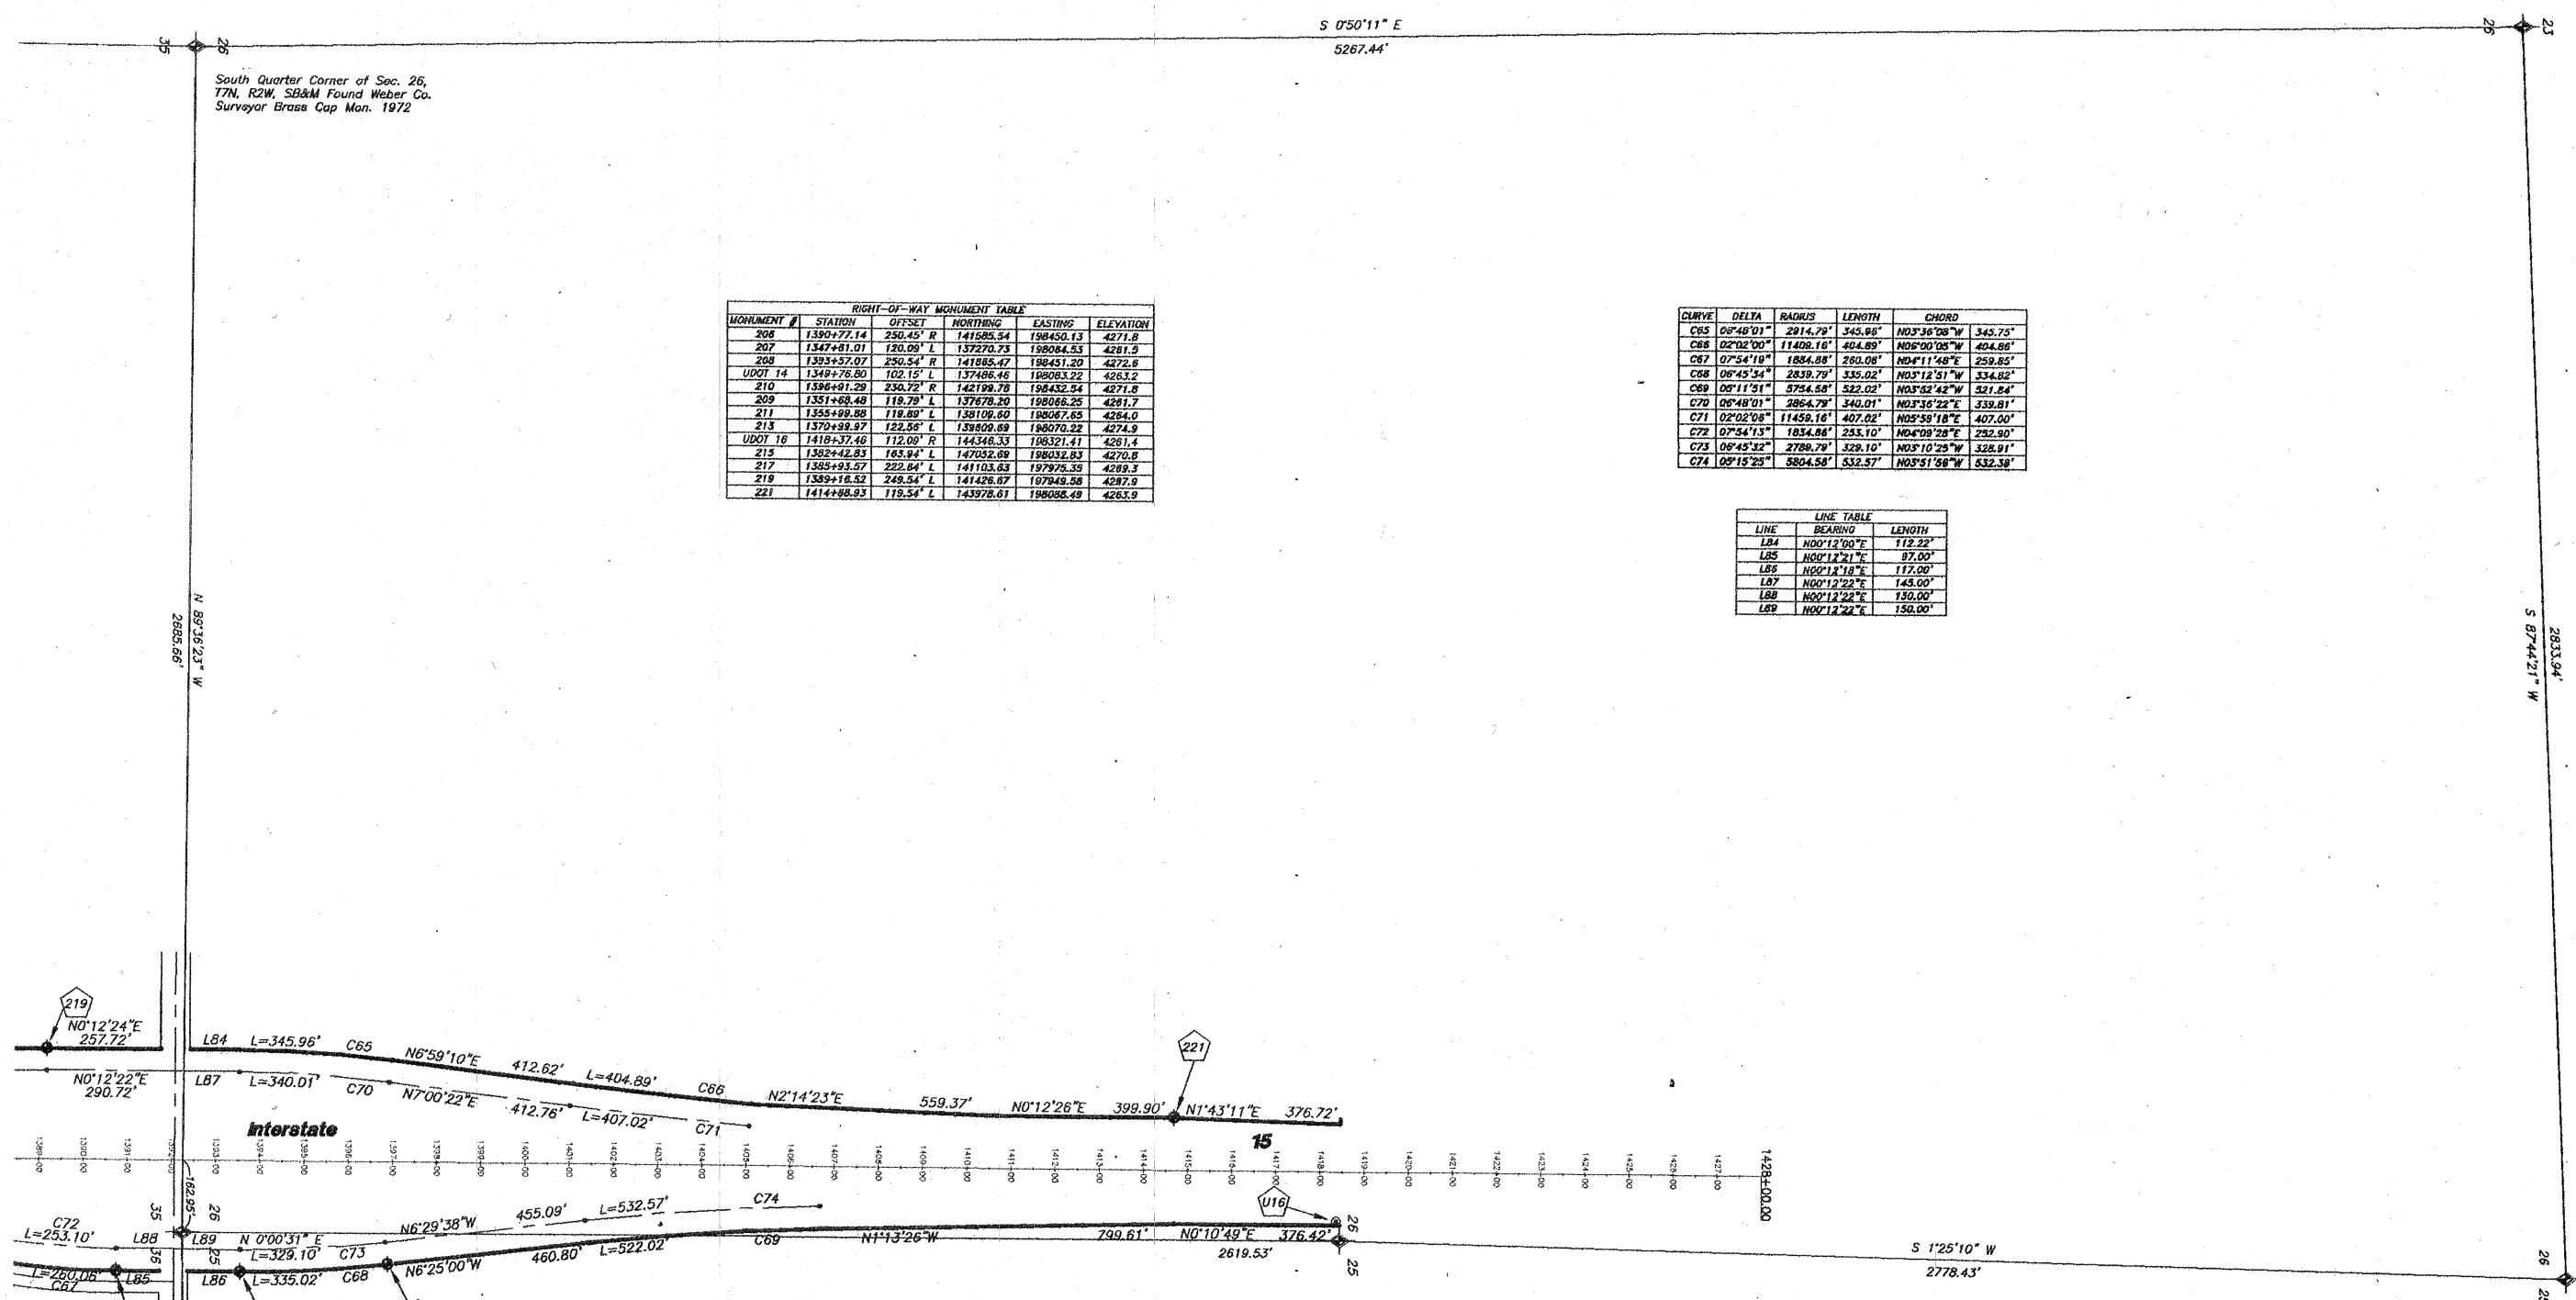

RIGHT-OF-WAY MONUMENT TABLE

| MONUMENT # | STATION | OFFSET | NORTHING | EASTING | ELEVATION |
|------------|------------|-----------|-----------|-----------|-----------|

CURVE DATA


| CURVE | DELTA | RADIUS | LENGTH | CHORD |
|-------|----------|-----------|---------|---------|

LINE TABLE

| LINE | BEARING | LENGTH |
|------|------------|---------|

NARRATIVE
 The purpose of this survey was to establish and set the right-of-way markers along the I-15 corridor from station 923+00 to station 1420+00 based on the right-of-way drawings calculated by Ward Engineering Group for UDOT. The bearings and distances shown on this drawing along the right-of-way lines are those lines or taken from said Ward Engineering Drawings. The right-of-way monuments set are shown with I-15 Stationing. Offset from the monument to the calculated centerline of I-15 per Ward Engineering Drawings and the Marking and Casting of said points. Not all monuments were set on the actual right-of-way lines and the physical location of said monuments should not be assumed to be that of actual right-of-way, but rather an offset control monument for said right-of-way. The survey was ordered by Kevin Smith of Weber County Constructors.

LEGEND:
 - - - - - UDOT RIGHT-OF-WAY LINE
 ——— CENTERLINE
 * SECTION CORNER
 ○ NEW RIGHT-OF-WAY MONUMENT
 ● EXISTING RIGHT-OF-WAY MONUMENT
 ○ CENTERLINE P.C., P.T., OR P.I.
 ○ R/W P.C., P.T., OR P.I.
 ● LEAD POINT/CONTROL POINT
 ○ WEBER COUNTY SURVEYOR RECORD DATA
 (○ DATA IN PARENTHESIS)

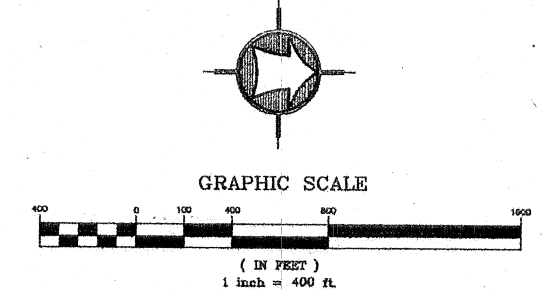

004267
RECEIVED
 FEB 06 2009
 WEBER CO SURVEYOR

| | |
|---|---|
| HANSEN & ASSOCIATES, INC. Consulting Engineers and Land Surveyors 538 North Main 67 East 100 North Brigham City, Utah 84302 Logan, Utah 84321 Ogden (435) 752-9197 Provo (435) 752-9222 | |
| Drawn By: JES Date: OCT. 2004 Designed By: _____ Checked By: _____ Approved By: _____ Scale: 1" = 200' Drawing File: 08-3-134.dwg JOB NUMBER: 08-3-134 | No. _____ Date _____ By _____ Revision _____ |
| Right-Of-Way Survey for INTERSTATE 15 SP-15-8 (34) 342 WEBER COUNTY, UTAH | |
| SHEET 9 OF 9 SHEETS | |