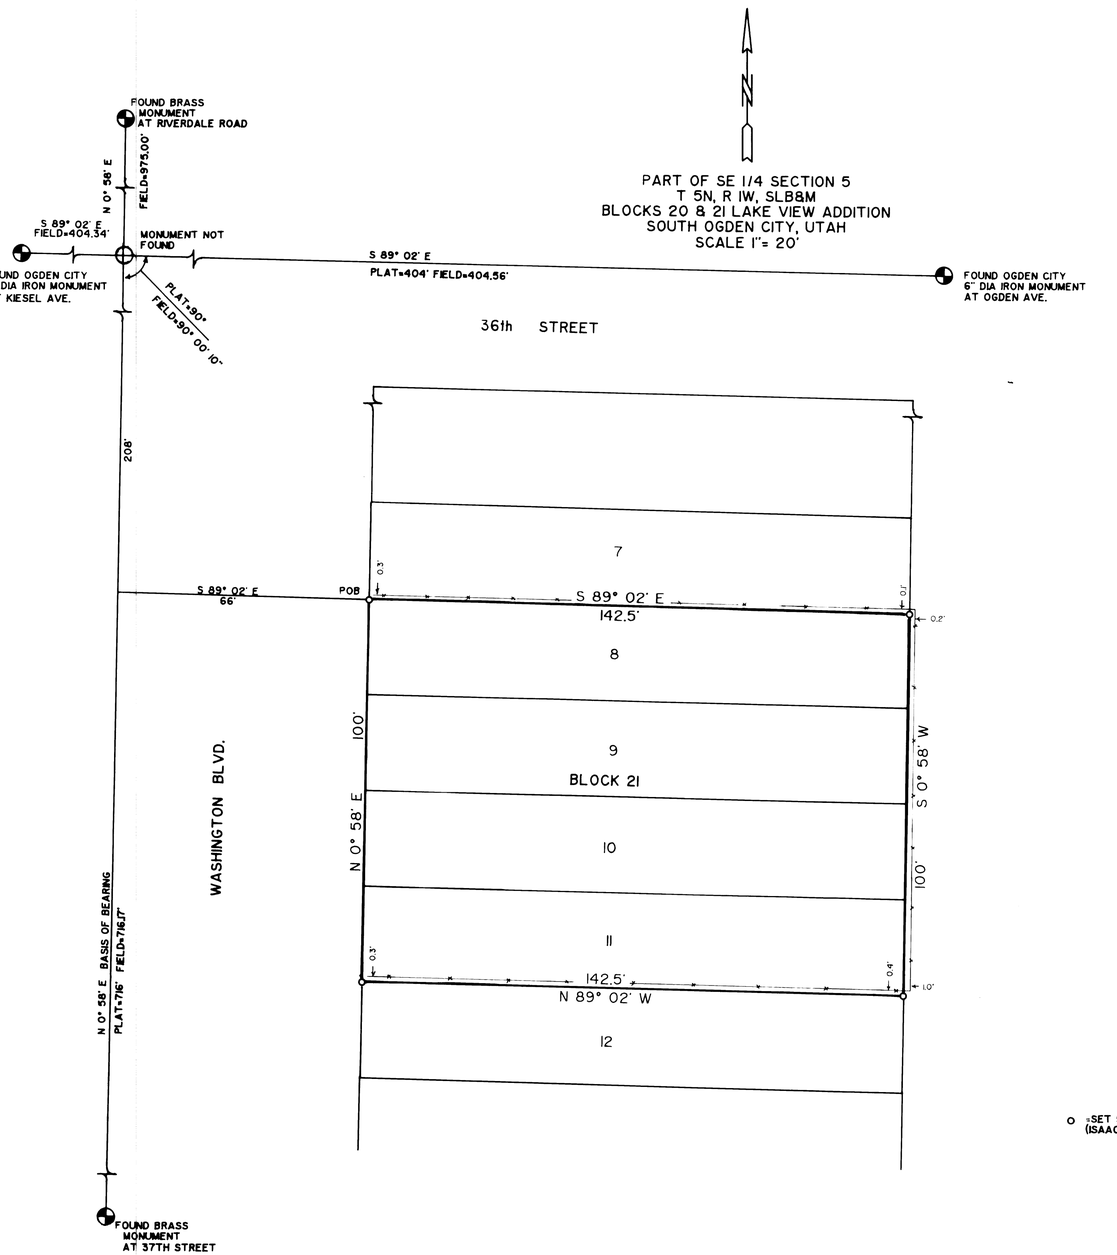

O =SET 5/8"x2' REBAR WITH CAP (ISAACSON ENGINEERING)

SURVEYOR'S CERTIFICATE

I, JERRY H. ISAACSON, DO HEREBY CERTIFY THAT I AM A REGISTERED LAND SURVEYOR, AND THAT I HOLD LICENSE NO. 4775, AS PRESCRIBED BY THE LAWS OF THE STATE OF UTAH, AND I FURTHER CERTIFY THAT I HAVE MADE A SURVEY OF THE DESCRIBED PROPERTY AND THAT THIS PLAT IS A TRUE AND CORRECT REPRESENTATION OF THE DESCRIBED PROPERTY.

11-29-90
DATE

Jerry H. Isaacson
JERRY H. ISAACSON

DESCRIPTION

ALL OF LOTS 8, 9, 10, AND 11, IN BLOCK 21, LAKEVIEW ADDITION TO OGDEN CITY, WEBER COUNTY, UTAH.

NARRATIVE

J-MAC RADIATOR SERVICE IS ADDING ON TO THEIR EXISTING BUILDING THUS REQUIRING THIS SURVEY.

RECEIVED
JAN 03 1990
Weber County Surveyor

PROPERTY SURVEY
Prepared for
J-MAC RADIATOR SERVICE
SOUTH OGDEN, UTAH

ISAACSON ENGINEERING & SURVEYING
KAYSVILLE, UTAH PH: 546-4704

DRAWN MI	DATE NOV. 1990	SHEET	REV.
CALCULATED JI	SCALE 1"= 20'		
CHECKED JI	JOB NO. 1978		

NO.	DATE	BY	DESCRIPTION