


Narrative

The purpose of this survey was to establish and set the property corners of the parcel as shown and described hereon. The survey was ordered by Danny Halverson. The control used to establish the property corners was the existing Property Corners and Centerline Monumentation surrounding Silver Springs Subdivision, Weber County, Section 4, T6N, R1W, SLB&M. The basis of bearing is the centerline of 975 East Street as currently monumented which by record bears North 07°50'58" East.

CENTERLINE MONUMENT 975 EAST AND 1500 NORTH STREET (FOUND BRASS CAP MONUMENT)

004315
RECEIVED
 JUN 19 2009
 WEBER CO SURVEYOR

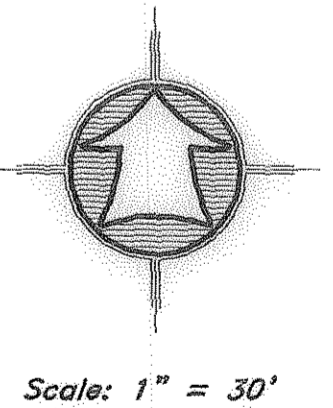


- LEGEND:**
- PROPERTY LINE
 - CENTERLINE
 - EXISTING CONCRETE
 - DEED LINE
 - OCCUPATION LINE
 - FENCE LINE
 - STREET MONUMENT
 - SET 5/8" REBAR W/ CAP

SURVEY CERTIFICATE

I, K. Greg Hansen, do hereby certify that I am a Registered Land Surveyor, and that I hold Certificate No. 167819 as prescribed by the Laws of the State of Utah, and that I have made and/or Supervised the survey of the property shown and described hereon and that this plat is a true and correct representation of said survey to the best of my knowledge and belief.

K. Greg Hansen,
 R.L.S. No. 167819

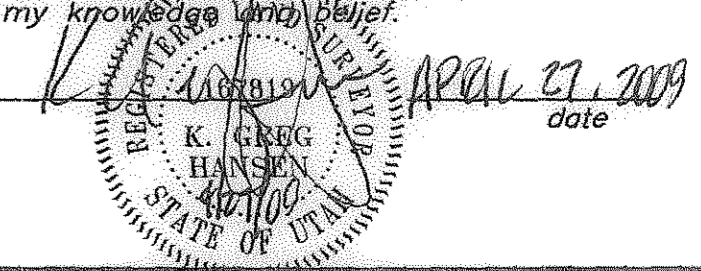

HANSEN & ASSOCIATES, INC. Consulting Engineers and Land Surveyors 538 North Main Brigham City, Utah 84302 (435) 723-3491 (435) 723-7663		Ogden (435) 589-4905 Logan (435) 752-8272
Drawn By: KGH Checked By: --- Approved By: --- Scale: 1" = 30' Drawing File: 09-3-32PS.DWG JOB NUMBER: 09-3-32	Date: 3/25/09	No. _____ Date _____ By _____
PROPERTY SURVEY FOR DANNY HALVERSON 1560 NORTH 975 EAST NORTH OGDEN, UTAH A PART OF THE NORTHEAST QUARTER OF SECTION 4, TOWNSHIP 6 NORTH, RANGE 1 WEST, S.L.B. & M.		
SHEET 1 OF 1 SHEETS		