


**SURVEYOR'S CERTIFICATE**

I, DALLAS K. BUTTARS, HOLDING LICENSE NUMBER 167594 IN ACCORDANCE WITH TITLE 58, CHAPTER 22, PROFESSIONAL ENGINEERS AND LAND SURVEYORS LICENSING ACT, HAVE COMPLETED A SURVEY OF THE PROPERTY DESCRIBED ON THE PLAT IN ACCORDANCE WITH SECTION 17-23-17 AND HAVE VERIFIED ALL MEASUREMENTS AND PLACED MONUMENTS AS REPRESENTED ON THE PLAT.

SIGNED THIS 4TH DAY OF June 2009

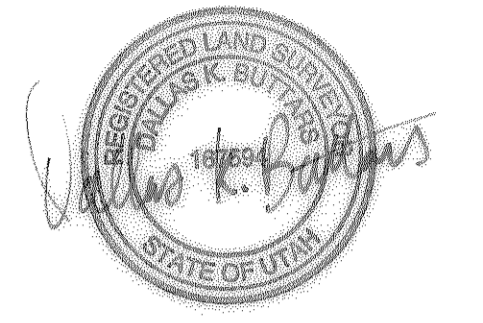

**SURVEYED BOUNDARY DESCRIPTION**


PART OF THE NORTHEAST QUARTER OF SECTION 34, TOWNSHIP 7 NORTH, RANGE 2 WEST, SALT LAKE BASE AND MERIDIAN; BEGINNING AT A POINT BEING SOUTH 88°30'00" EAST 275.55 FEET AND NORTH 1°30'00" EAST 528.00 FEET FROM THE CENTER OF SAID SECTION 34 AND RUNNING THENCE NORTH 1°30'00" EAST 99.00 FEET, THENCE SOUTH 88°30'00" EAST 321.75 FEET, THENCE SOUTH 1°30'00" WEST 99.00 FEET, THENCE NORTH 88°30'00" WEST 321.75 FEET TO THE POINT OF BEGINNING. CONTAINS 0.73 ACRES

**RECORD BOUNDARY DESCRIPTION**

PART OF THE NORTHEAST QUARTER OF SECTION 34, TOWNSHIP 7 NORTH, RANGE 2 WEST, SALT LAKE BASE AND MERIDIAN, U.S. SURVEY. BEGINNING 16.7 RODS EAST AND 32 RODS NORTH OF THE CENTER OF SECTION 34, THENCE NORTH 6 RODS, THENCE EAST 19.5 RODS, THENCE SOUTH 6 RODS, THENCE WEST 19.5 RODS TO THE POINT OF BEGINNING.

**NARRATIVE**

THIS SURVEY WAS PERFORMED TO DETERMINE AN UNFENCED AREA NORTH OF THE PLAIN CITY CANAL. MOST OF THE DEEDS IN THIS AREA HAVE DEED CALLS NORTH, SOUTH, EAST AND WEST DIRECTIONS. BY ROTATING THE DEED CALLS OF THIS PARCEL CLOCKWISE 1°30' MATCHES THE FENCES OF THE AREA. THE BASIS OF BEARING IS THE WEBER COUNTY STATE PLANE GRID SYSTEM AS SHOWN.

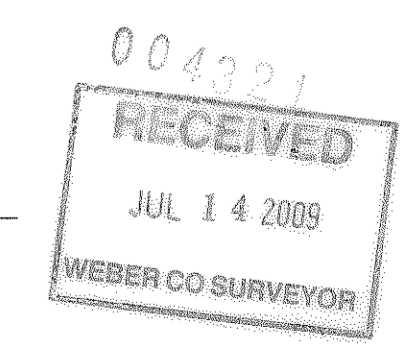

REVISIONS	
1.) _____	5.) _____
2.) _____	6.) _____
3.) _____	7.) _____
4.) _____	8.) _____

DRAWN BY: D.B.	DATE: 05-11-09
CHECKED BY: D.B.	SCALE: AS SHOWN
JOB NO. 3087	

**LANDMARK SURVEYING, INC.**  
 A COMPLETE LANDSURVEYING SERVICE  
 4646 S. 3500 W. #A-3, WEST HAVEN, UTAH 84401  
 PHONE 801-731-4075 FAX 801-731-8506

**RECORD OF SURVEY**  
 TRAVIS MURPHY

**LOCATED IN**  
 A PART OF THE N.E. 1/4 OF SECTION 34, T.7N., R.2W., S.L.B.&M.  
 WEBER COUNTY COUNTY, UTAH