

**LEGEND**

|      |                        |
|------|------------------------|
| CONC | CONCRETE SURFACE       |
| CO   | CONCRETE               |
| EB   | ELECTRICAL BOX         |
| ET   | ELECTRICAL TRANSFORMER |
| GM   | GAS METER              |
| GN   | GAS NETER              |
| MAN  | MANHOLE                |
| PL   | PLASTER                |
| TEL  | TELEPHONE BOX          |
| WV   | WATER VALVE            |


- COMMENTS**
1. THIS SURVEY WAS MADE AT THE INSTANCE OF VAN COTT, BAZLEY, CORNWELL & MCKARTHY FOR THEIR SPECIFIC PURPOSES.
  3. RECORD BEARINGS HAVE BEEN UNIFORMLY ROTATED 0°24'00" WHERE APPROPRIATE, TO THE SURVEYED BEARINGS ON HIGHWAY 84.

**NEW COMPOSITE LEGAL DESCRIPTION**



ADDRESS:  
3485 NORTH 2000 WEST  
FARR WEST, UTAH

SCHUCHERT & ASSOCIATES  
PROFESSIONAL LAND SURVEYORS  
5330 SOUTH 900 EAST • SALT LAKE CITY, UTAH 84117  
(801) 268-1118


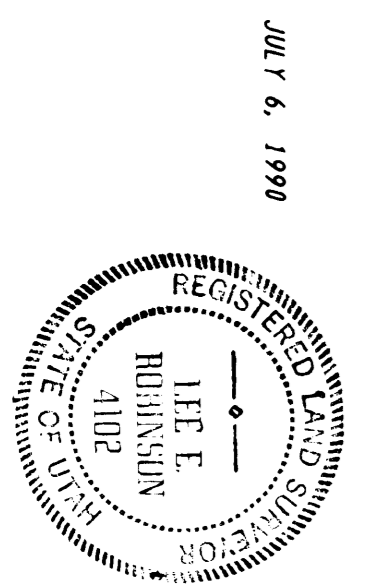


**SURVEYOR'S CERTIFICATE**

I, LEE E. ROBINSON, A duly registered land surveyor in the State of Utah, do hereby certify to the accuracy of the above described property and associated title information, that a survey of the above described property was made under my direct supervision, and that the same was made in accordance with minimum standard detail requirements for a subdivision of land in accordance with minimum standard detail requirements for a subdivision of land, and meets the accuracy standards for a class "A" survey as defined therein.

SCHUCHERT & ASSOCIATES

RECORDED  
JAN 02 1994

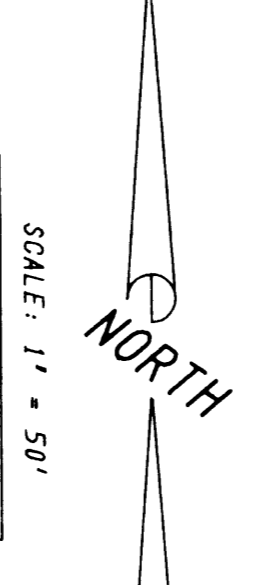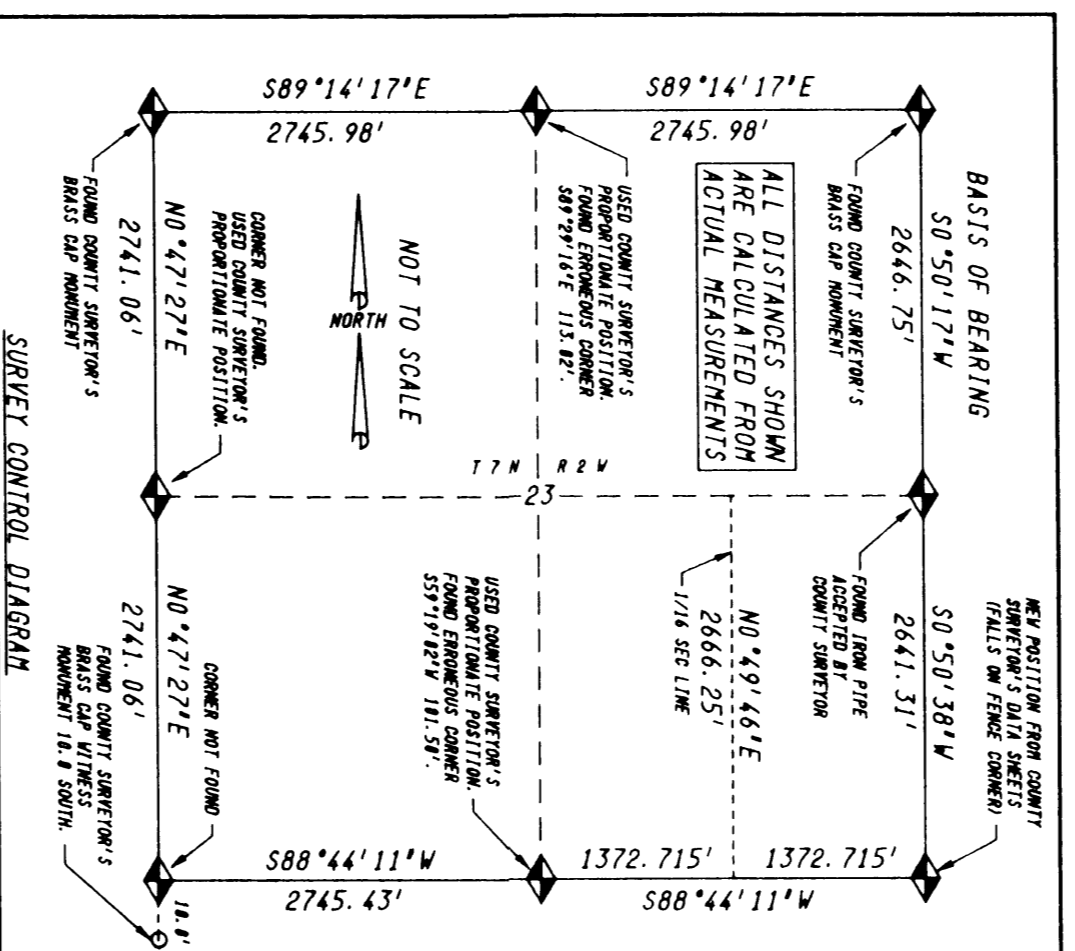

NEW POSITION FROM COUNTY SURVEYOR'S DATA SHEETS (FALLS ON FENCE CORNER)

ALTA/ASCH LAND TITLE SURVEY  
SE 1/4 SEC 23, T7N, R2W, SLB & M  
WEBER COUNTY, UTAH

07/28/94  
2027  
2027