


Narrative


The purpose of this survey was to adjust and set the property corners of the parcel as shown and described hereon. The survey was ordered by Cinda Wayment. It is the opinion of Hansen and Associates the distance of 1320.00 feet as called in the deed for tax parcel 170660009 is an assumed distance based on a perfect section and is intended to represent the North line of the South half of the Northwest Quarter of said Section. The control used to establish the property corners was the existing Weber County Survey Monumentation surrounding Section 31, T7N, R1W, SLB&M. The basis of bearing is the East line of the Northwest Quarter of said Section which bears South 00°49'50" West State Plane Grid.

PARCEL A
A Part of the Northwest Quarter of Section 31, Township 7 North, Range 1 West, of the Salt Lake Base and Meridian. Beginning at a Point on the West Right of Way Line of 750 West Street Said Point Being Located South 00°49'50" West (South by Record) 1182.26 Feet Along the East Line of the Northwest Quarter of Said Section and North 89°10'10" West 33.00 Feet From the North Quarter Corner of Said Section; Running Thence Along Said Right of Way Line South 00°49'50" West 174.98 to an Existing Fence Line; Thence Along Said Fence Line North 89°14'11" West 468.20 Feet; Thence North 00°49'50" East 175.53 Feet; Thence South 89°10'10" East 468.20 Feet (East 501.20 Feet by Record) to the Point of Beginning. Containing 1.884 Acres.

PARCEL B
A Part of the Northwest Quarter of Section 31, Township 7 North, Range 1 West, of the Salt Lake Base and Meridian. Beginning at a Point on the West Right of Way Line of 750 West Street Said Point Being Located North 00°49'50" East (North by Record) 1131.15 Feet Along the East Line of the Northwest Quarter of Said Section and North 89°10'10" West (West by Record) 33.00 Feet From the Southeast Corner of Said Northwest Quarter; Running Thence North 89°10'10" West (West by Record) 1133.69 Feet; Thence North 09°36'00" West 203.91 Feet to the North Line of the South Half of Said Quarter Section (North 11°10'30" West 192.50 Feet by Record); Thence Along Said North Line South 89°40'56" East (East by Record) 702.43 Feet; Thence South 00°49'50" West 10.85 Feet to an Existing Fence Line; Thence Along Said Existing Fence Line South 89°14'11" East 468.20 to Said West Right of Way Line; Thence Along Said Right of Way Line South 00°49'50" West (South by Record) 196.51 Feet to the Point of Beginning. Containing 5.309 Acres.

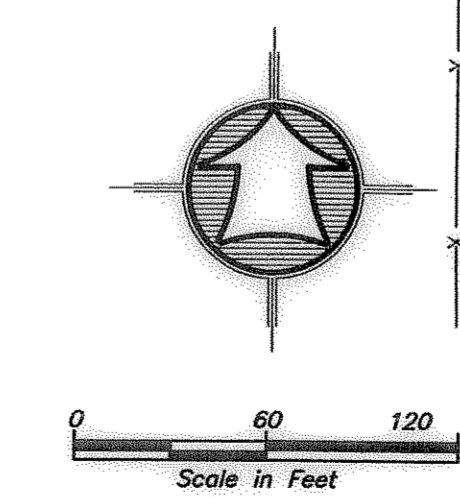


- LEGEND**
- PROPERTY LINE
 - - - CENTERLINE
 - - - RIGHT OF WAY LINE
 - - - ORIGINAL DEED LINE
 - - - 40 ACRE LINE
 - - - SECTION LINE
 - - - FENCE LINE
 - - - SECTION CORNER
 - RIGHT OF WAY MARKER
 - SET 5/8" REBAR W/ CAP

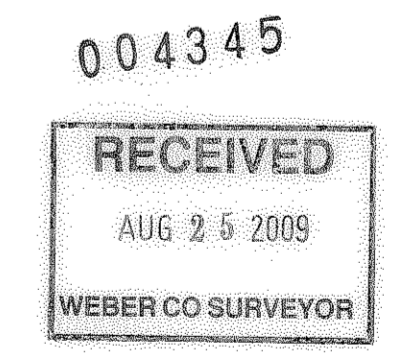

SURVEY CERTIFICATE

I, K. Greg Hansen, do hereby certify that I am a Registered Land Surveyor, and that I hold Certificate No. 167819 as prescribed by the Laws of the State of Utah, and that I have made and/or Supervised the survey of the property shown and described hereon and that this plat is a true and correct representation of said survey to the best of my knowledge and belief.

K. Greg Hansen,
R.L.S. No. 167819

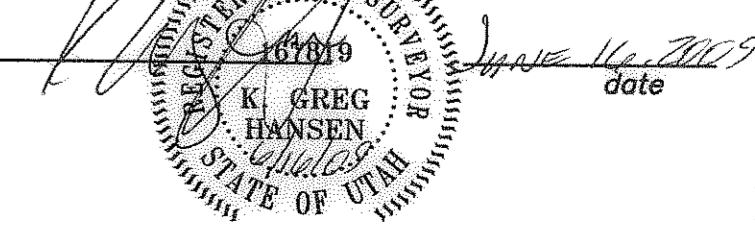

BOUNDARY ADJUSTMENT FOR		CINDA WAYMENT	
750 WEST STREET		HARRISVILLE, WEBER COUNTY, UTAH	
A PART OF THE SOUTHEAST OF SECTION 31		TOWNSHIP 7 NORTH, RANGE 1 WEST, S.L.B.& M.	
Drawn By: KSH	Date: 6-9-09	Designed By:	
Checked By:		Approved By:	
Scale: 1" = 60'		Drawing File: PS09-3-68.DWG	
JOB NUMBER: 09-3-68			
HANSEN & ASSOCIATES, INC.		Consulting Engineers and Land Surveyors	
538 North Main	Brigham City, Utah	84302	
Brigham City	Ogden	(435) 723-3491	(435) 752-9272
(435) 723-7663	(801) 399-4905		
No.	Date	By	Revision
1			
1			
SHEETS			