


004363

RECEIVED  
OCT 05 2009  
WEBER CO SURVEYOR

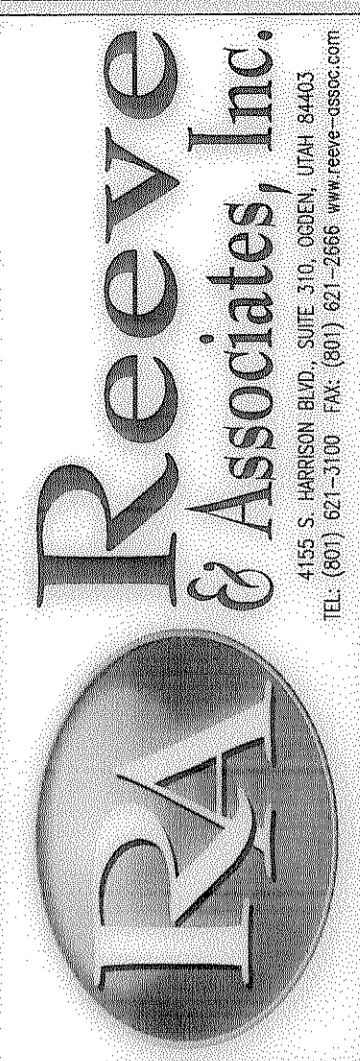

**Reeve & Associates, Inc.**  
4155 S. HARRISON BLVD., SUITE 310, OGDEN, UTAH 84403  

REVISIONS	DESCRIPTION

**Record of Survey**  
**Harmony Vanguard**

**Project Info.**  
Surveyor: R. KUNZ  
Designer: N. ANDERSON  
Begin Date: 10-18-07  
Name: HARMONY VANGUARD R.O.S.  
Scale: 1"=200'  
Checked:  
Number: 5516-01

Sheet **2** of **2** Sheets