

- LEGEND**
- ▲ Set Nail & Washer
 - Set Rebar & Cap w/ Fencepost
 - Set Hub & Tack
 - ⊕ Monument to be set
 - (Rad.) Radial Line
 - (N/R) Non-Radial Line

NARRATIVE

This survey was requested by Mrs. Laura Warburton in order to establish the Property Corners. Brass Cap monuments were found at the Northwest Corner and the West 1/4 Corner of Section 6, T6N, R2E, SLB&M. A line bearing N 0°16'36" E Between those two Monuments was used as the Basis of Bearings. Property Corners were monumented as depicted in this drawing.



BOUNDARY DESCRIPTION

All of Lot 3 of Middle Fork Ranches, according to the Official Plat thereof, on record in the Weber County Surveyor's Office.

SURVEYOR'S CERTIFICATE

I, Andy Hubbard, do hereby certify that I am a Registered Professional Land Surveyor, and that I hold Certificate No. 6242920, in accordance with Title 58, Chapter 22, of the Professional Engineers and Surveyors Licensing Act, and I have made a survey of the above described property according to Section 17-23-17 and that the above plat correctly shows the true dimensions of the property surveyed.

Date 9-10-2009

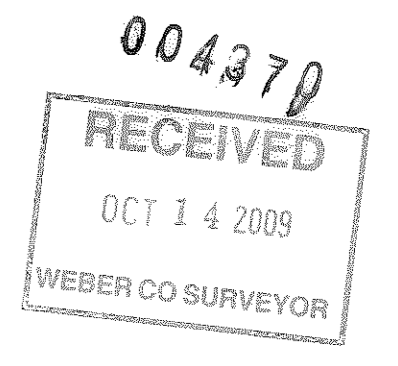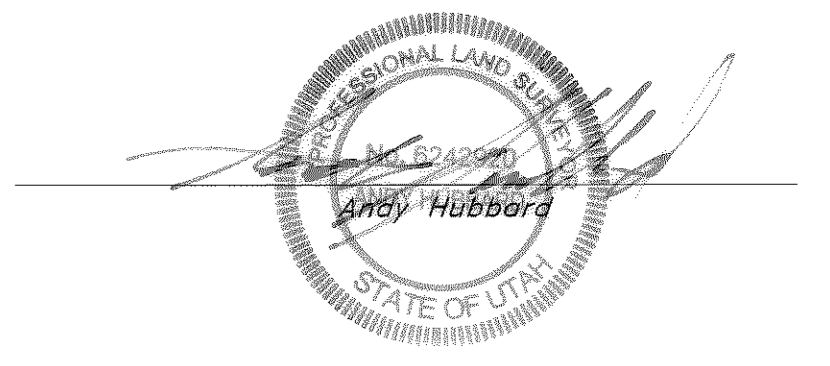

Property Survey		Warburton Property All of Lot 3, Middle Fork Ranches, Weber County And a part of Section 6, T6N, R2E, SLB&M, U.S. Survey Weber County, Utah	
GREAT BASIN ENGINEERING NORTH <small>CONSULTING ENGINEERS AND SURVEYORS</small> 5746 South 1475 East - Suite 200 Ogden, Utah 84403 P.O. Box 150049, Ogden, Utah 84415 <small>Ogden (801)384-4515 Salt Lake City (801)321-0222 Fax (801)382-7544</small>	SCALE : 1"=50'	DATE : 2 Sep, 2009	DRWG. NO.
	DRAWN : DH	REVISIONS :	09N732
09N732-PS			