DRAWING NUMBER
000445
DRAWING NUMBER
000445
DRAWING NUMBER
000445
000445

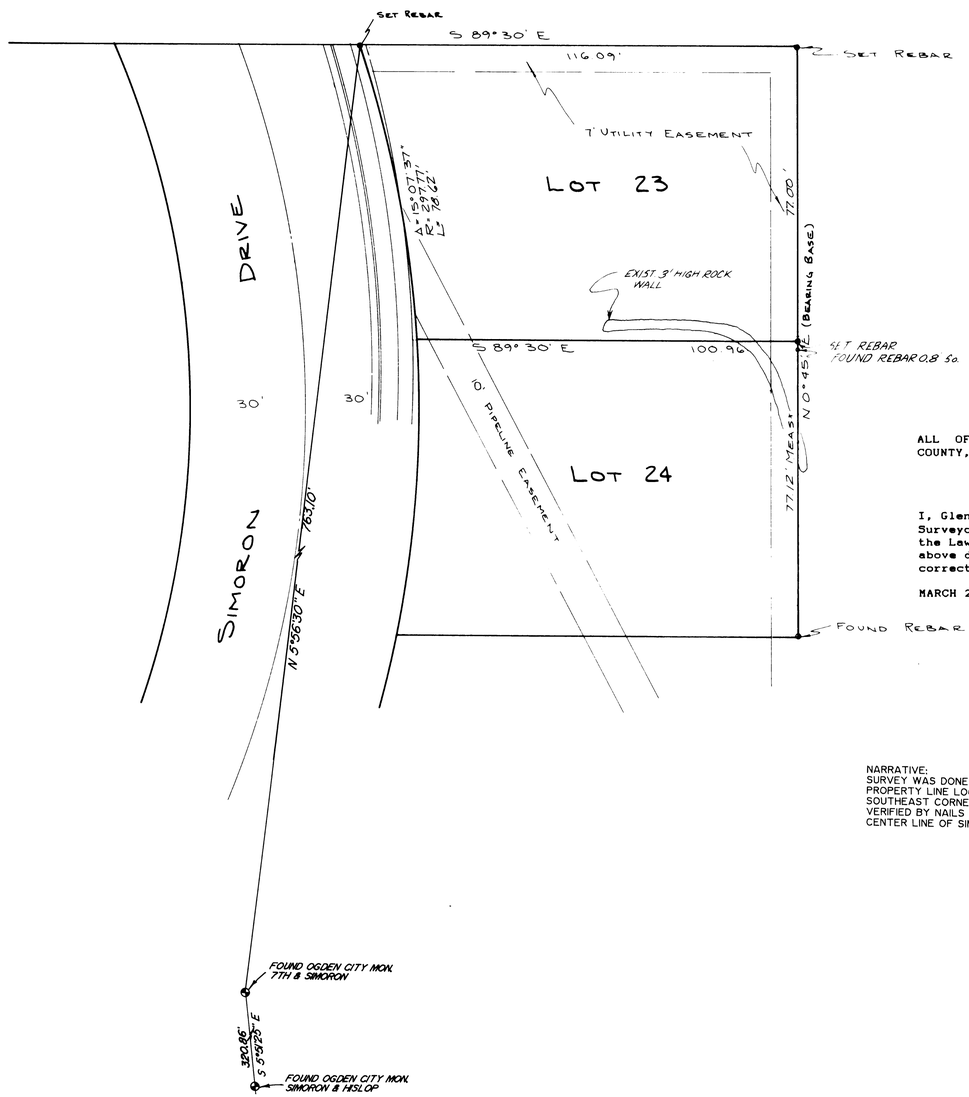

SCALE 1" = 20'

ALL OF LOT 23, CHERRY HILL ADDITION NO. 2, OGDEN CITY, WEBER COUNTY, UTAH ACCORDING TO THE OFFICIAL PLAT THEREOF.

I, Glenn Ravenberg, do hereby certify that I am a registered Land Surveyor, and that I hold Certificate No. 3835, as prescribed by the Laws of the State of Utah, and I have made a survey of the above described property. I further certify that the above plat correctly shows the true dimensions of the property surveyed.

MARCH 25, 1987

Glenn Ravenberg
Glenn Ravenberg

NO. 3835
GLENN R. RAVENBERG

NARRATIVE:
SURVEY WAS DONE TO VERIFY SOUTH PROPERTY LINE LOCATION. REBAR ON SOUTHEAST CORNER OF LOT 24 WAS VERIFIED BY NAILS FOUND IN THE CENTER LINE OF SIMORON DRIVE.

RECEIVED
JAN 0 8 1990
Weber County Surveyor

PART OF THE WEST 1/2 OF SEC 15, T6N, R1W, SLB&M

INTERMOUNTAIN SURVEYING
Layton, Utah 84041 (801) 544-1170

PROPERTY SURVEY FOR SHIRLEY DOUGLAS

LOT 23 CHERRY HILL ADDITION NO. 2

MARCH 25, 1987	1" = 20'	

LABRUM'S DRAFTING SYSTEMS 94474

000445