

**LEGEND**

- ▲ Set Nail & Washer
- ⊙ Set Rebar & Cap w/ Fanpost
- ⊙ Set Hub & Tack
- ⊙ Found Monument
- Calc'd Calculated Bearings and Distances
- Meas. Measured Bearings and Distances
- X- Existing Fence
- P.U.E. Public Utility Easement

A 5/8" rebar 24" long with plastic cap (see detail below) was set as shown on this drawing.



**NARRATIVE**

This survey was requested by Mr. David Stearns for the purpose of defining the property line. Rebar and Cap were found at the Southerly most corner of Lot 93 and the most Southerly corner of Lot 90 of Green Hill Country Estates Phase No. 6, Huntsville, Weber County, Utah. A line bearing N 46°16'51" E between the two rebars was used as basis of bearings. Lot corners were monumented as depicted on this drawing.


**BOUNDARY DESCRIPTION**

All of Lot 100, Green Hill Country Estates Phase No. 6, Huntsville City, Weber County, Utah, according to the official plat thereof, on file in the Weber County Recorders Office.

**SURVEYOR'S CERTIFICATE**

I, Andy Hubbard, do hereby certify that I am a Registered Professional Land Surveyor, and that I hold Certificate No. 6242920, in accordance with Title 58, Chapter 22, of the Professional Engineers and Surveyors Licensing Act, and I have made a survey of the above described property according to Section 17-23-17 and that the above plat correctly shows the true dimensions of the property surveyed.

Date 7-26-2010

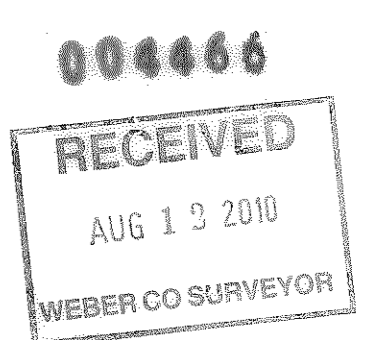

**GREAT BASIN ENGINEERING**  
 5746 SOUTH 1475 EAST OGDEN, UTAH 84403  
 MAIN (801)394-4515 S.L.C. (801)392-7544  
 WWW.GREATBASINENGINEERING.COM

**Property Survey**  
**Stearns Greenhill**  
 1350 North Maple Street,  
 Huntsville City, Weber County, Utah  
 A part of Section 4, T6N, R2E, SLB&M, U.S. Survey