

SCALE 1"=20'


- FOUND NAIL
- SET 1/2" REBAR
- SET NAIL IN CURB

JACK NEIL
 ALL OF LOT 14, FAIRWAY PARK NO. 1, HARRISVILLE CITY, WEBER COUNTY, UTAH ACCORDING TO THE OFFICIAL PLAT THEREOF.
 CONTAINS 7,800 SQ. FT.

I, Glenn Ravenberg, do hereby certify that I am a registered Land Surveyor, and that I hold Certificate No. 3835, as prescribed by the Laws of the State of Utah, and I have made a survey of the above described property. I further certify that the above plat correctly shows the true dimensions of the property surveyed.

9 JUNE 1987

Glenn Ravenberg
 Glenn Ravenberg

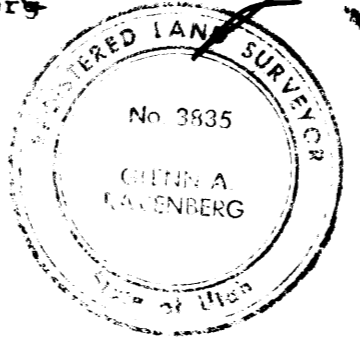

NARRATIVE:
 SURVEY WAS DONE AT THE REQUEST OF OWNER AS A REQUIREMENT FOR A BUILDING PERMIT.

RECEIVED
 JAN 08 1990

Webster County Surveyor
 PART OF S.E. 1/4 OF SEC. 31, T7N, R1W, S18EM.

INTERMOUNTAIN SURVEYING
 Layton, Utah 84041 (801) 544-1170

PROPERTY SURVEY
 FOR
 JACK NEIL

LOT 14, FAIRWAY PARK NO. 1
 JUNE 8, 1987 1"=20'