


**Narrative**  
 The purpose of this survey was to adjust and set the property corners of the parcels as shown and described herein. The survey was ordered by Narl Allen. The East Right of Way line of 7700 East was established by Existing Weber County Centerline Monuments. The West Right of Way line of State Highway 39 was established by using the published U.D.O.T. Right of Way drawings in conjunction with the physical Right of Way markers. The Huntsville Townsite Plat and the current Weber County Section Monumentation was used to establish the Lots located in Plat B, Block 2. The dimensions of the adjusted parcels were determined by the property owners. The basis of bearing is the East Line of the Northeast Quarter of Section 18, Township 6 North, Range 2 East, of the Salt Lake Base and Meridian.

STEPHEN MERRILL HADLEY  
 240190015

LEE K. BRINTON  
 240190002

**LEGEND**

- PROPERTY LINE
- CENTERLINE
- - - ORIGINAL LOT LINE
- - - CURRENT DEED LINE
- - - DITCH
- - - FENCE LINE
- - - EXISTING BUILDING
- SECTION CORNER
- STREET MONUMENT
- FOUND PROPERTY CORNER
- SET 5/8" REBAR W/ CAP

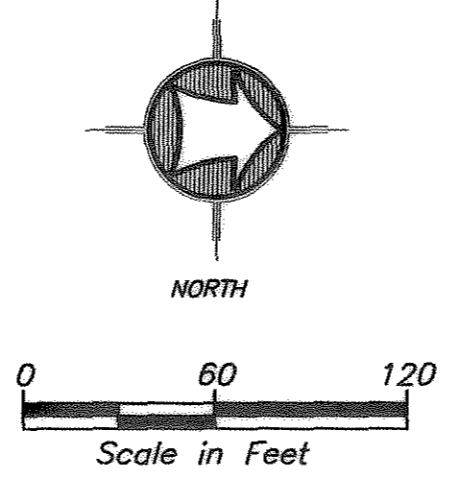

**PARCEL A**

A Part of the Northeast Quarter of Section 18, Township 6 North, Range 2 East of the Salt Lake Base and Meridian, Also a Part of Lot 4, Plat B, Huntsville Townsite Survey. Beginning at a Point on the East Right of Way Line of 7700 East Street (A Street by Record) Said Point Being Located South 00°22'09" West 1773.86 Feet Along the East Line of Said Northeast Quarter and South 90°00'00" West 1214.79 Feet From the Northeast Corner of Said Section (Said Point Described of Record as Being North 150.00 Feet From the Southwest Corner of said Lot 4); Running Thence North 88°49'16" East 409.49 Feet to the West Right of Way Line of State Highway 39; Thence Along Said Right of Way Line the Following Two (2) Courses: (1) South 02°41'55" East 25.52 Feet; (2) South 01°05'54" East 255.39 Feet to an Existing Agreed upon Fence Line (Said Point Being North 01°05'54" West 28.10 Feet of a Point Described of Record as Being South 142.00 Feet From the Intersection of the South Line of Said Lot 4 and the West Right of Way Line of State Highway 39); Thence Along Said Agreed upon Fence Line South 87°46'09" West 410.04 Feet to Said East Right of Way Line (Said Point Being Located North 01°10'44" West 3.56 Feet of a Point Described of Record as Being 142.00 Feet South of the Southwest Corner of Said Lot 4); Thence Along Said East Right of Way Line the Following Two (2) Courses: (1) North 01°10'44" West 165.61 Feet; (2) North 01°06'12" West 122.83 to the Point of Beginning. Containing 2.680 Acres.


**PARCEL B**

A Part of the Northeast Quarter of Section 18, Township 6 North, Range 2 East of the Salt Lake Base and Meridian, Also a Part of Lot 4, Plat B, Huntsville Townsite Survey. Beginning at a Point on the East Right of Way Line of 7700 East Street (A Street by Record) Said Point Being Located South 00°22'09" West 1773.86 Feet Along the East Line of Said Northeast Quarter and South 90°00'00" West 1214.79 Feet and North 01°06'12" West 137.03 Feet From the Northeast Corner of Said Section; Running Thence North 01°06'12" West 312.97 Feet; Thence North 88°49'16" East 217.80 Feet; Thence South 01°06'12" East 312.97 Feet; Thence South 88°49'16" West 217.80 Feet to the Point of Beginning. Containing 1.565 Acres.

**PARCEL C**

A Part of the Northeast Quarter of Section 18, Township 6 North, Range 2 East of the Salt Lake Base and Meridian, Also a Part of Lot 4, Plat B, Huntsville Townsite Survey. Beginning at the Northwest Corner of Said Lot 4 Said Point Being on the East Right of Way Line of 7700 East Street (A Street by Record) Said Point Being Located South 00°22'09" West 1112.44 Feet Along the East Line of Said Northeast Quarter and South 90°00'00" West 1229.42 Feet From the Northeast Corner of Said Section; Running Thence Along the North Line of Said Lot 4 South 88°47'51" East 389.46 Feet to the West Right of Way Line of State Highway 39; Thence Along Said West Right of Way Line South 02°41'55" East 645.52 Feet; Thence South 88°49'16" West 409.49 Feet to the East Right of Way Line of 7700 East Street (A Street by Record, Said Point Described of Record as Being North 150.00 Feet From the Southwest Corner of Said Lot 4); Thence Along Said East Right of Way Line North 01°06'12" West 137.03 Feet; Thence North 88°49'16" East 217.80 Feet; Thence North 01°06'12" West 312.97 Feet; Thence South 88°49'16" West 217.80 Feet to Said East Right of Way Line; Thence Along Said East Right of Way Line the Following Two (2) Courses: (1) North 01°06'12" West 54.77 Feet; (2) North 00°14'08" West 156.73 Feet to the Point of Beginning. Containing 4.435 Acres.

**HUNTSVILLE TOWN PLANNING COMMISSION APPROVAL**  
 THIS IS TO CERTIFY THAT THIS BOUNDARY ADJUSTMENT PLAT WAS DULY APPROVED BY THE HUNTSVILLE TOWN PLANNING COMMISSION ON THE \_\_\_\_\_ DAY OF \_\_\_\_\_ A.D., 2009

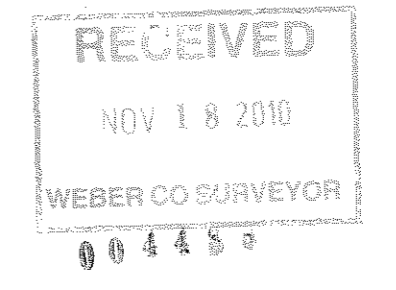

**HUNTSVILLE TOWN ACCEPTANCE**  
 THIS IS TO CERTIFY THAT THIS BOUNDARY ADJUSTMENT PLAT WAS DULY APPROVED BY THE CITY COUNCIL OF HUNTSVILLE TOWN, WEBER COUNTY, UTAH, ON THE \_\_\_\_\_ DAY OF \_\_\_\_\_ A.D., 2009

**SURVEY CERTIFICATE**  
 I, K. Greg Hansen, do hereby certify that I am a Registered Land Surveyor, and that I hold Certificate No. 167819 as prescribed by the Laws of the State of Utah, and that I have made and/or Supervised the survey of the property shown and described herein and that this plat is a true and correct representation of said survey to the best of my knowledge and belief.  
 K. GREG HANSEN  
 R.L.S. No. 167819  
 OCT. 25 2010 date

**BOUNDARY ADJUSTMENT PLAT FOR**  
**NARL ALLEN**  
 7700 EAST  
 HUNTSVILLE, WEBER COUNTY, UTAH  
 A PART OF THE NORTHEAST QUARTER OF SECTION 18,  
 TOWNSHIP 6 NORTH, RANGE 2 EAST, S.L.B. & M.

Drawn By: KEW Date: 5/26/09  
 Designed By: \_\_\_\_\_  
 Checked By: \_\_\_\_\_  
 Approved By: \_\_\_\_\_  
 Scale: 1" = 60'  
 Drawing File: PS09-3-61A.DWG  
 JOB NUMBER: 09-3-61

**HANSEN & ASSOCIATES, INC.**  
 Consulting Engineers and Land Surveyors  
 538 North Main  
 Brigham City  
 (435) 723-3491  
 (435) 723-7663  
 Ogden  
 (801) 599-4905  
 Logan  
 (435) 752-8272

BRIGHAM CITY, UTAH  
 84302

SHEET 1 OF 1 SHEETS