DRAWING NUMBER
000451

DRAWING NUMBER
000451

DRAWING NUMBER
000451

DRAWING NUMBER
000451

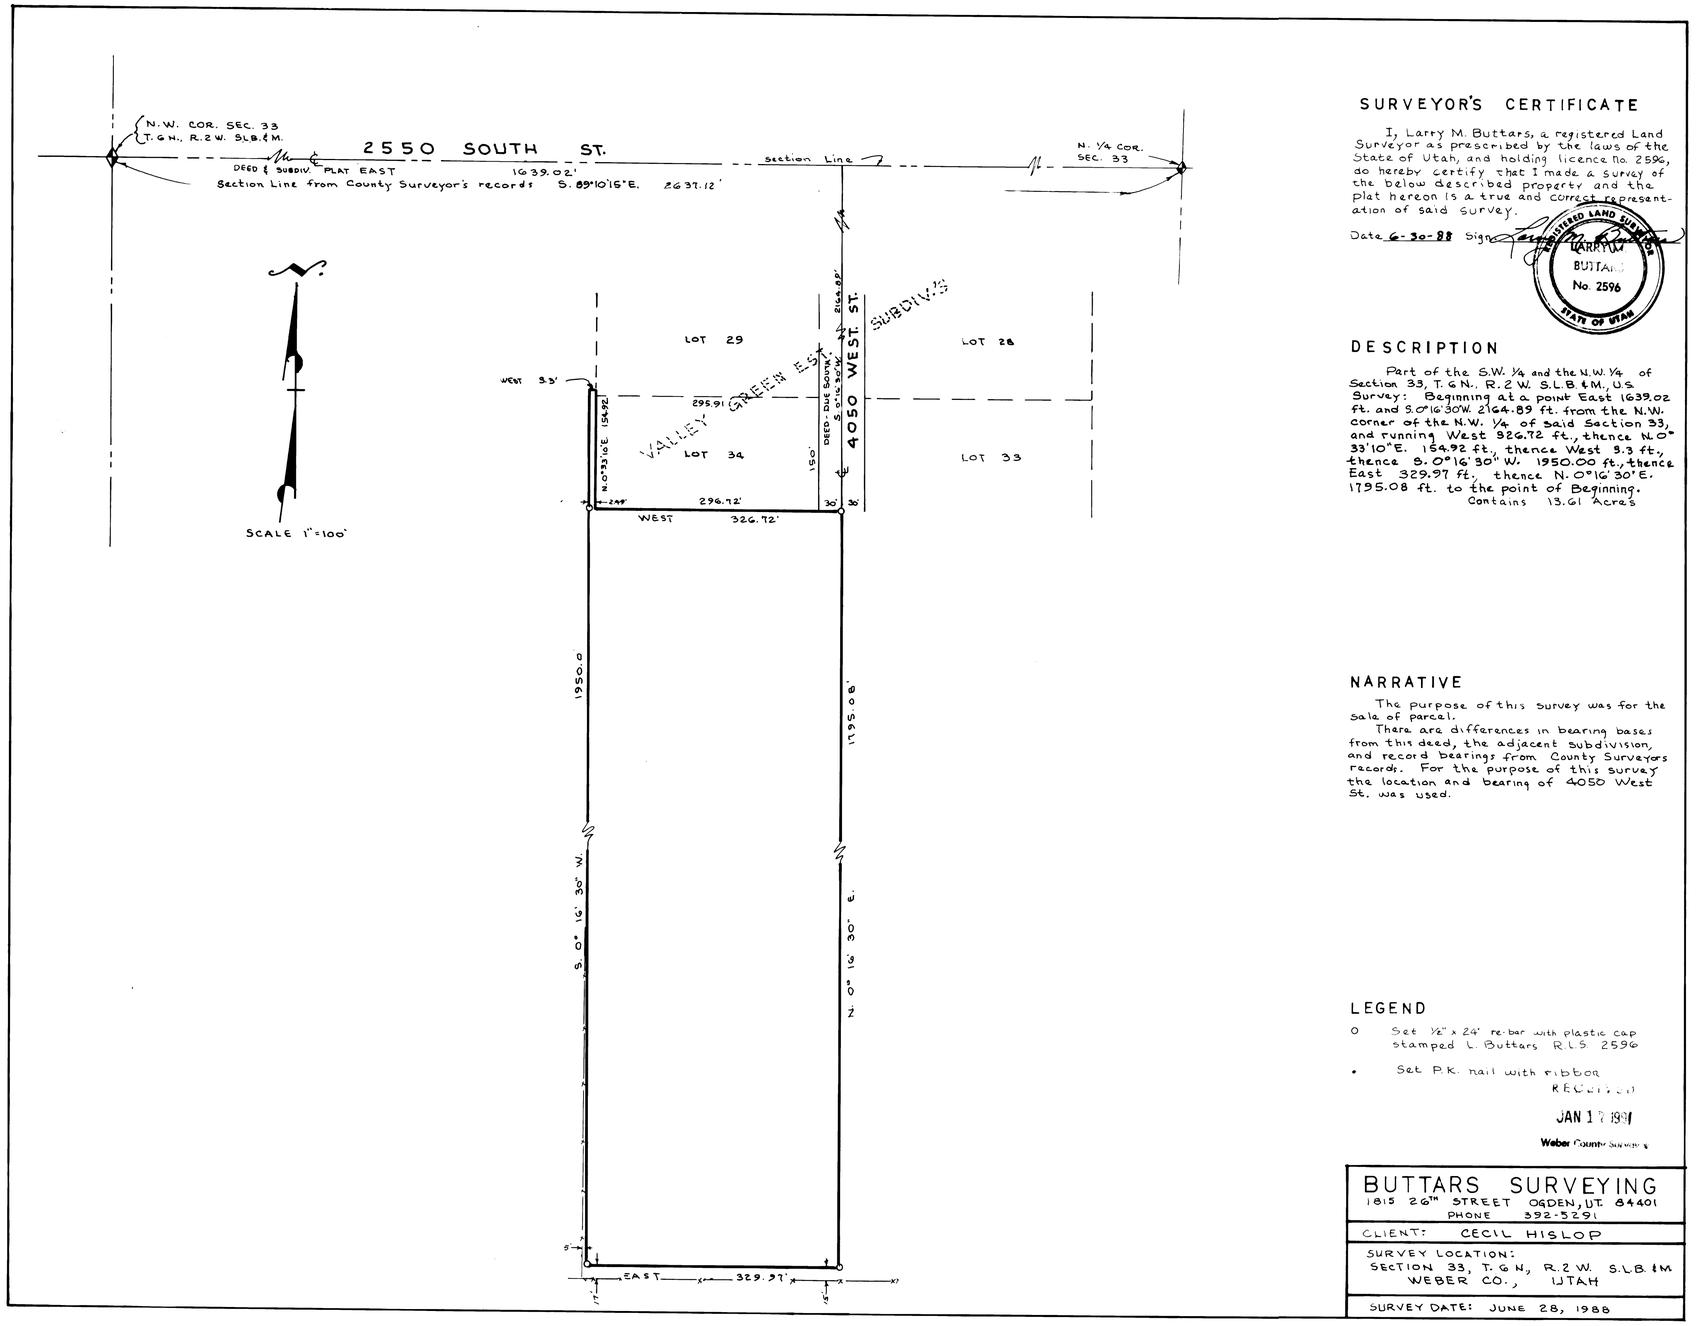

SURVEYOR'S CERTIFICATE

I, Larry M. Buttars, a registered Land Surveyor as prescribed by the laws of the State of Utah, and holding licence No. 2596, do hereby certify that I made a survey of the below described property and the plat hereon is a true and correct representation of said survey.

Date 6-30-88 Sign

REGISTERED LAND SURVEYOR
LARRY M. BUTTARS
No. 2596
STATE OF UTAH

DESCRIPTION

Part of the S.W. 1/4 and the N.W. 1/4 of Section 33, T. 6 N., R. 2 W. S.L.B.&M., U.S. Survey: Beginning at a point East 1639.02 ft. and S.0°16'30"W. 2164.89 ft. from the N.W. corner of the N.W. 1/4 of Said Section 33, and running West 326.72 ft., thence N.0° 33'10"E. 154.92 ft., thence West 3.3 ft., thence S.0°16'30" W. 1950.00 ft., thence East 329.97 ft., thence N.0°16'30"E. 1795.08 ft. to the point of Beginning.

Contains 13.61 Acres

NARRATIVE

The purpose of this survey was for the sale of parcel.

There are differences in bearing bases from this deed, the adjacent subdivision, and record bearings from County Surveyors records. For the purpose of this survey the location and bearing of 4050 West St. was used.

LEGEND

O Set 1/2" x 24" re-bar with plastic cap stamped L. Buttars R.L.S 2596

• Set P.K. nail with ribbon

RECEIVED
JAN 17 1991
Weber County Surveyor

BUTTARS SURVEYING 1815 26TH STREET OGDEN, UT. 84401 PHONE 392-5291
CLIENT: CECIL HISLOP
SURVEY LOCATION: SECTION 33, T. 6 N, R. 2 W. S.L.B.&M. WEBER CO., UTAH
SURVEY DATE: JUNE 28, 1988