


Note: 11-2-90 plat revised and stakes re-located to reflect bearing change on W. line of sec. 1 at 1/4 cor. Information from County records show West line of section 1 to be N. 0° 41' 12" E. Old records and previous surveys refer to an additional witness corner (now destroyed) places the West 1/4 corner S. 3 7/8 ft. and West 1.35 ft. from the location in W.C. Survey records dated 2-4-81.

SURVEYORS CEPTIFICATE

I, Larry M. Buttars, a registered Land Surveyor as prescribed by the laws of the State of Utah, and holding license No. 2596, do hereby certify that I made a survey of the herein described property and the Plat hereon is a true and correct representation of said survey.

Date: 10-17-90 Sign: *Larry M. Buttars*

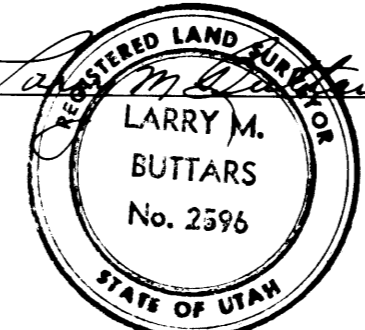

DESCRIPTION

A part of the N.W. 1/4 of Section 1, T. 6 N., R. 2 W., S.L.B. & M., U.S. Survey; Beginning at a point 885.17 ft. N. 0° 56' 40" E. along the Section line from the Southwest corner of said 1/4 section, and running thence S. 89° 12' 48" E. 261.17 ft., thence N. 0° 56' 40" E. 150.00 ft., thence N. 89° 12' 48" W. 261.17 ft., thence S. 0° 56' 40" W. 150.00 ft. to the point of beginning.

NARRATIVE

The purpose of this survey was to establish boundaries for fencing. Weber County Grid Bearings were used and dead bearings rotated.

NOTE: The description for Weber County frontage Road reads East 3.04 ft. East of the section line to a point 40 ft. from the West side of frqntage road.

LEGEND

- o Set 3/4" x 24" re-bar with plastic cap; stamp: L. Buttars, R.L.S., 2596.
- Set P.K. with white ribbon

RECEIVED

JAN 17 1991

Weber County Surveyor

BUTTARS SURVEYING	
1815 26 TH STREET	ORDEN, UT. 84401
PHONE 392-5291	
CLIENT: James Miller	
SURVEY LOCATION:	
N.W. 1/4 Sec. 1, T. 6 N., R. 2 W.	
WEBER CO., UTAH	
SURVEY DATE: 10-13-90	