RECORD OF SURVEY

PART OF LOT 5, BLOCK 5 AND LOTS 3 AND 4 BLOCK 6
PLAT "A" HOOPER CITY SURVEY

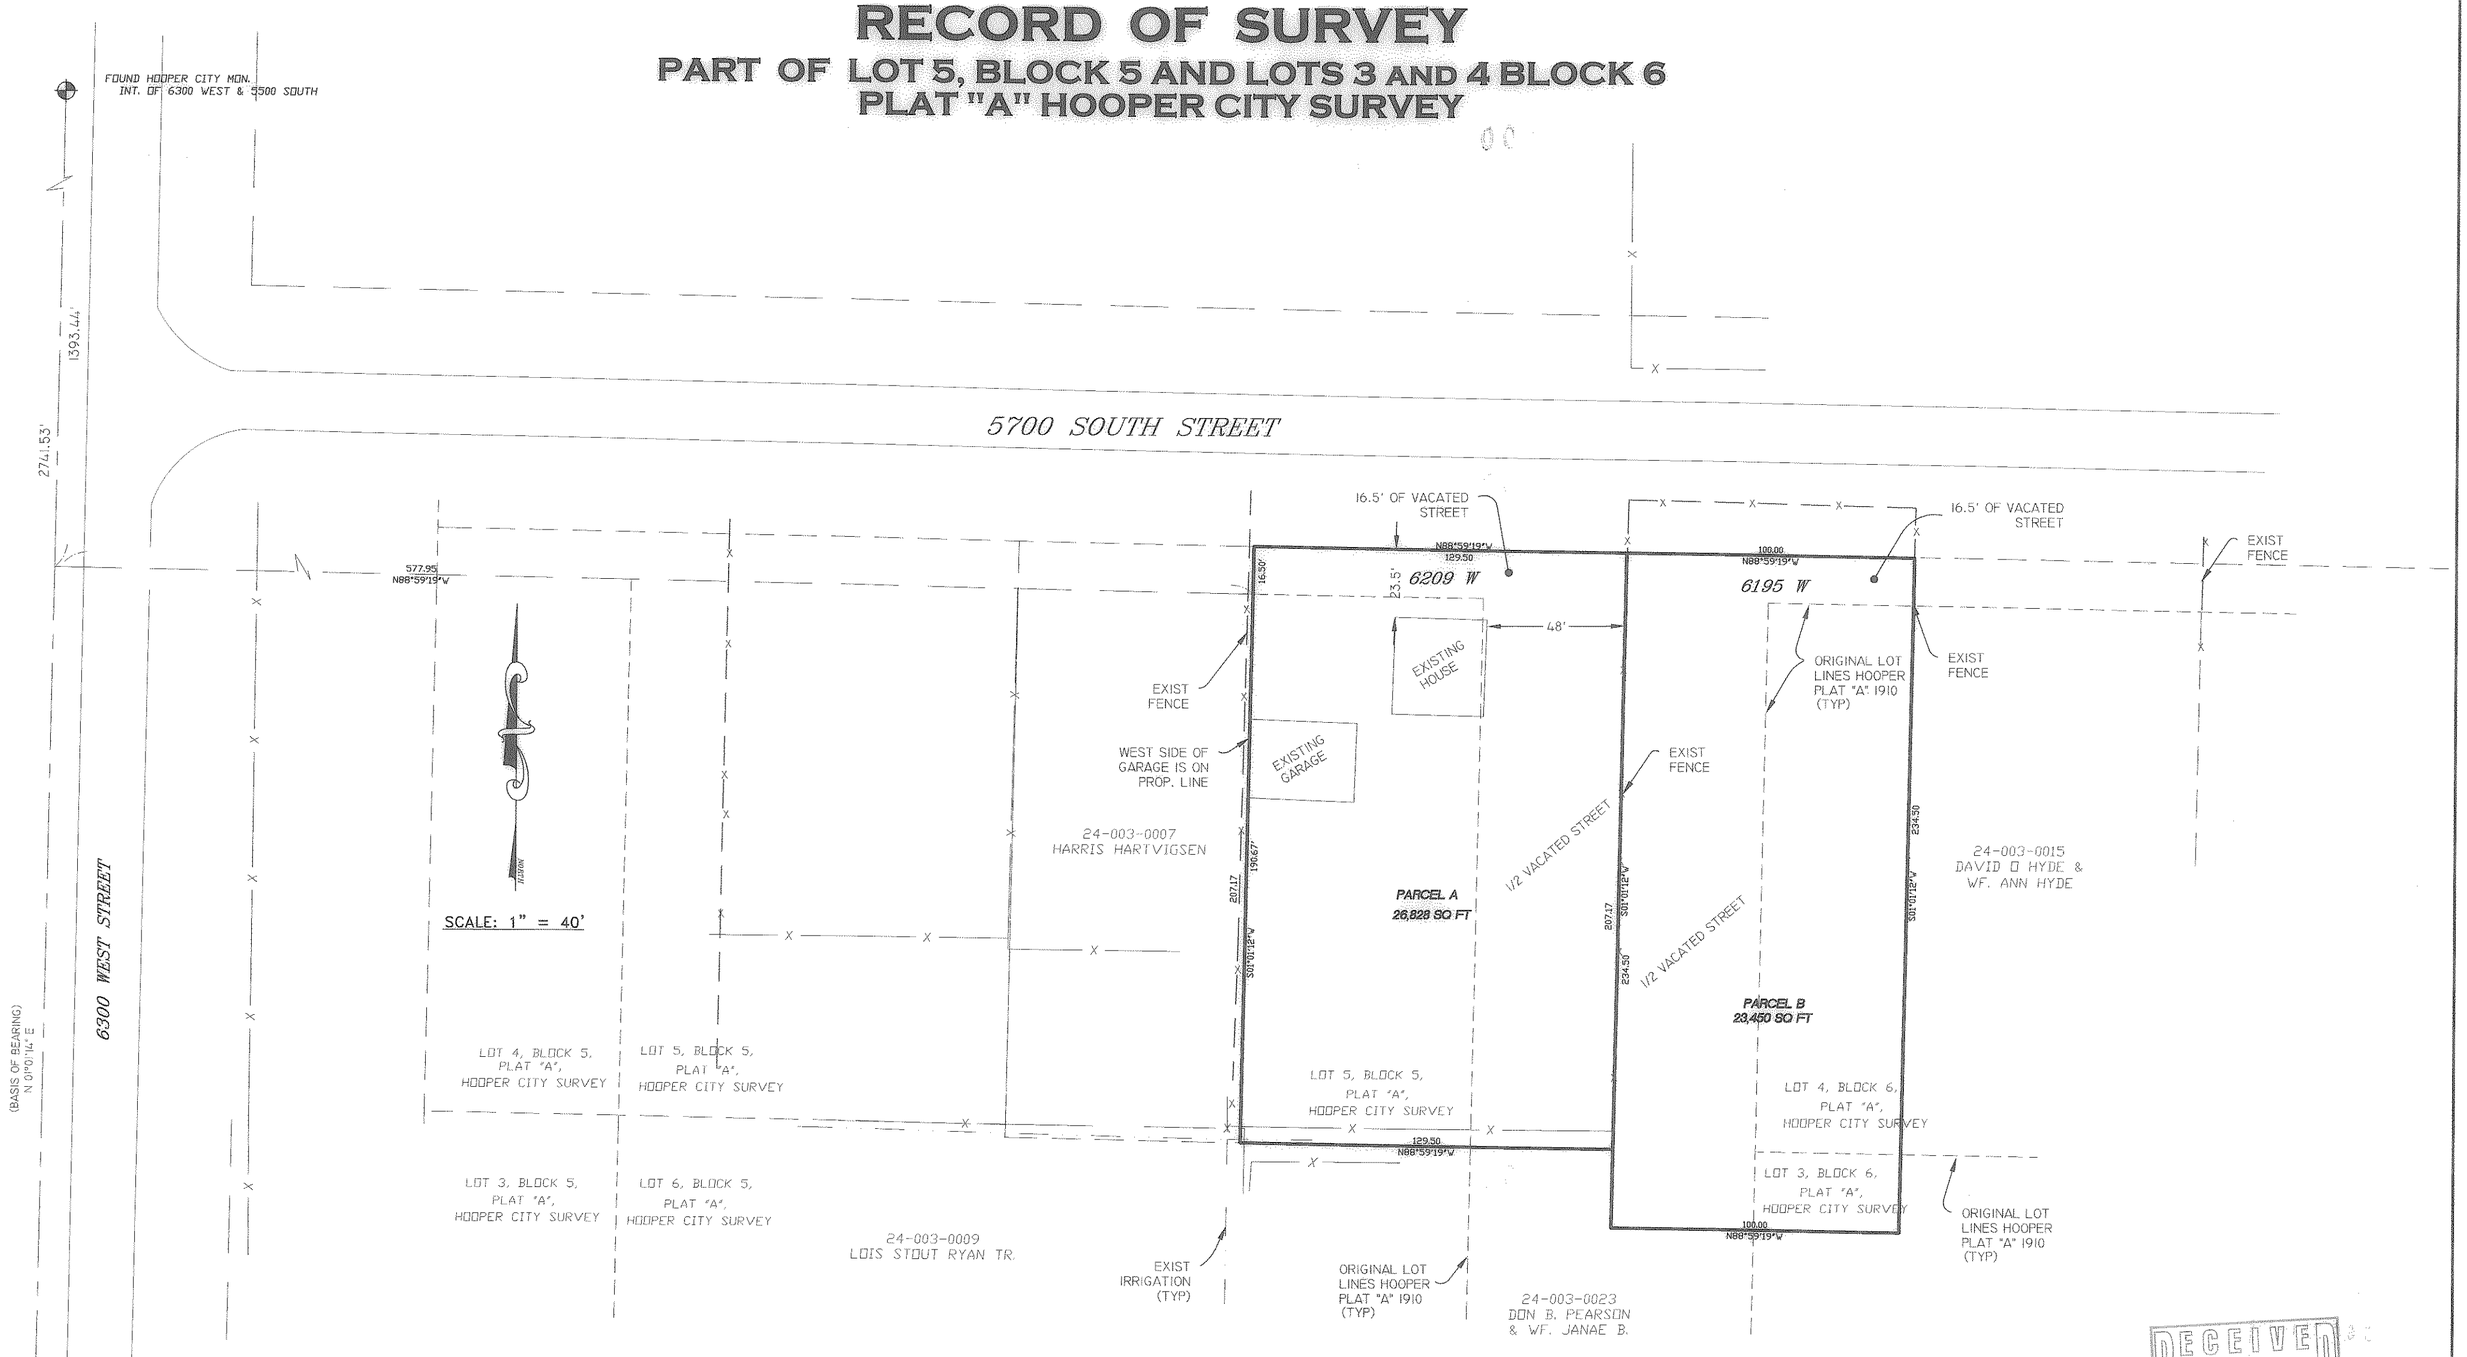

RECEIVED
FEB 10 2011
By 004522

PROPERTY DESCRIPTION

PARCEL A

THE EAST 80 FEET OF LOT 5, BLOCK 5, PLAT A HOOPER CITY SURVEY, WEBER COUNTY, UTAH TOGETHER WITH THE WEST 1/2 OF THE VACATED STREET ABUTTING SAID LOT ON THE EAST AND THE VACATED SOUTH 16.5 FEET OF THE STREET ABUTTING SAID PROPERTY ON THE NORTH.

PARCEL B

THE WEST 50.5 FEET OF LOT 4 AND THE WEST 50.5 FEET OF THE NORTH 27 1/3 FEET OF LOT 3, BLOCK 6, PLAT A HOOPER CITY SURVEY, WEBER COUNTY, UTAH TOGETHER WITH THE EAST 1/2 OF THE VACATED STREET ABUTTING SAID LOTS ON THE WEST AND THE VACATED SOUTH 16.5 FEET OF THE STREET ABUTTING SAID LOT ON THE NORTH..

SURVEYOR'S CERTIFICATE

I DOUG L GRAHAM, HOLDING LICENSE NUMBER 172757 IN ACCORDANCE WITH TITLE 58, CHAPTER 22, PROFESSIONAL ENGINEERS AND LAND SURVEYORS LICENSING ACT, HAVE COMPLETED A SURVEY OF THE PROPERTY DESCRIBED ON THE PLAT IN ACCORDANCE WITH SECTION 17-23-17 AND HAVE VERIFIED ALL MEASUREMENTS AND PLACED MONUMENTS AS REPRESENTED ON THE PLAT.

SIGNED THIS 11th DAY OF JANUARY 2011

P.L.S. # 172757 _____ SIGNATURE

REGISTERED LAND SURVEYOR DOUGLAS L. GRAHAM 01-11-11 172757 STATE OF UTAH

LANDMARK SURVEYING AND ENGINEERING, INC.
A COMPLETE LAND DEVELOPMENT SERVICE
4646 S. 3500 W. #A-3, WEST HAVEN, UTAH 84401
PHONE 801-731-4075

CLIENT: LLOYD McARTHUR
LOCATION: PART OF LOT 5, BLOCK 5 and PART OF LOTS 3 and 4 BLOCK 6 PLAT "A" HOOPER CITY SURVEY
SURVEYED: JUNE 2010

REVISIONS:		
06-16-10		DRAWN BY: DLG
		CHECKED BY: D.G.
		DATE: 06-03-10
		FILE: 3150RDS.DWG

WEBER COUNTY RECORDER
ENTRY #_____ FEE _____
FILED FOR RECORD & RECORDED
THIS ____ DAY OF _____ 20__
AT _____ IN BOOK _____ OF____
PAGE _____
WEBER COUNTY RECORDER
BY _____
DEPUTY