

25th Street

24th Street

Lincoln Avenue

Wall Avenue

ALLEY

DEPOT

PARCEL A
CONT. 26,440 SQ. FT.
0.607 ACRES

PARCEL B
CONT. 33,603 SQ. FT.
0.776 ACRES

PARCEL C
CONT. 65,406 SQ. FT.
1.302 ACRES

PARCEL D
CONT. 9,940 SQ. FT.
0.228 ACRES

PARCEL E
CONT. 32,634 SQ. FT.
0.749 ACRES

NOTES



REGISTERED LAND SURVEYOR

1989 REVISIONS - DUPLICATE PROPERTY INTO PARCELS A, B, C, & D AS SHOWN

JAMES W. STACY
A portion of Block 23, Plat 4,
Gorden City Survey, Open Utah

INTERMOUNTAIN SURVEYING
Bld. 318 (1170)
R. E. CLAY, D.D.
JAN 23 1989 41
Water County Surveyor


DATE: APRIL, 1988 **SCALE: 1" = 40'** **PG. 89 - 74**

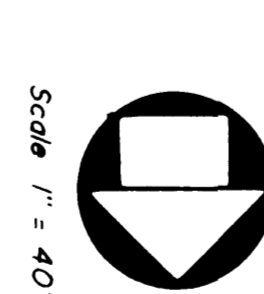

FIRST SECURITY BANK
BURTON WALKER LUMBER PROPERTY

A PART OF LOTS 3, 5, 6, 7, 8, 9, AND 10 BLOCK 23, PLAT A, GORDEN CITY SURVEY, GORDEN CITY, UTAH, BEGINNING AT A POINT WHICH IS NORTH AND RUNNING THENCE SOUTH 0°58'1" WEST 123.60 FT., THENCE SOUTH 89°07'59" EAST 34.14 FT. ALONG AN EXISTING BUILDING WALL TO A BUILDING CORNER, THENCE SOUTH 0°52'02" OF EAST 22.75 THENCE SOUTH 89°07'36" EAST 212.35 FT. ALONG SAID NORTH LINE TO THE NORTH EAST CORNER OF SAID LOT 8, THENCE SOUTH 0°58'1" WEST 325.53 FT. TO A CORNER OF SAID LOT 10, THENCE NORTH 89°04'48" WEST 419.00 FT. TO THE NORTH LINE OF SAID LOT 4, THENCE NORTH 89°04'48" WEST 419.00 FT. TO THE NORTH LINE OF SAID LOT 4, THENCE NORTH 89°06'12" WEST 29.45 FT. ALONG THE NORTH LINE OF SAID LOT 4, THENCE NORTH 0°58'1" EAST 54.50 FT., THENCE NORTH 89°06'12" WEST 115.45 FT. TO A POINT 54.50 FT. SOUTH OF THE POINT OF BEGINNING, THENCE SOUTH 89°09'1" THENCE SOUTH 89°09'1" EAST 3.20 FT. TO A POINT OF CURVE, THENCE EAST 158.82 FT. TO THE POINT OF CURVE, THENCE S 89°09'1" E 158.82 FT. TO THE POINT OF BEGINNING.

CONTAINS 3.62 ACRES

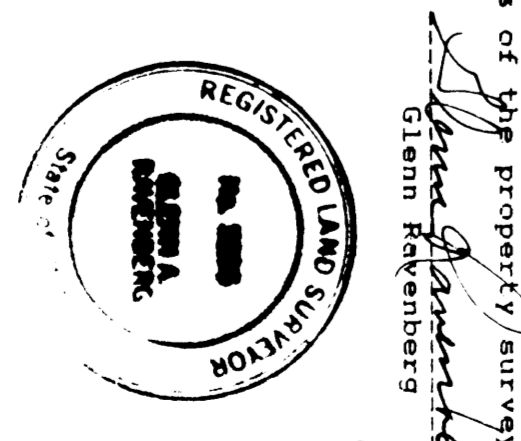

NOTES

1. G.S. - Great Basin Engineering

