

- LEGEND**
- ▲ Set Nail & Washer
 - ⊙ Set Rebar & Cap w/ Fencepost
 - ⊙ Set Hub & Tack
 - ⊙ Monument to be set
 - (Rad.) Radial Line
 - (N/R) Non-Radial Line

NARRATIVE

This Survey was requested by Mr. Brent Wheeler for the purpose of establishing the boundaries of these parcels. Witness Corners were found at the Northwest Corner of the North 1/4 Corner, the Center Corner and the West 1/4 Corner of the Northwest 1/4 Corner of Section 18, T5N, R2W, SLB&M. The Section Corner Locations were positioned using the information on the Tie Sheets from the Weber County Surveyors Office. A line bearing N 0°58'16" E between the Witness Corners for the Center Corner and the North 1/4 Corner was used as the Basis of Bearings. Property Corners were monumented as depicted on this plat.

BOUNDARY DESCRIPTION


- Parcel 1**
Part of the Northeast Quarter of Section 13, and part of the Northwest Quarter of Section 18, Township 5 North, Range 3 West, and Township 5 North, Range 2 West, respectively, Salt Lake Base and Meridian, U.S. Survey; beginning at a point South 1020.00 feet from the Northwest corner of said Section 18; said point also being 60.00 feet North of the North foundation wall of the existing church building, running thence West 48.75 feet to the East line of the County Road, known as 5900 West Street, thence North along said East line 100.00 feet, thence East 250.90 feet, thence South 100 feet, thence West 202.15 feet to the place of beginning.
- Parcel 2**
Part of the Northeast Quarter of Section 13, and part of the Northwest Quarter of Section 18, Township 5 North, Range 3 West, and Township 5 North, Range 2 West, respectively, Salt Lake Base and Meridian, U.S. Survey; beginning at a point South 1020 feet from the Northwest corner of said Section 18; and running thence West 48.75 feet to the East line of the County Road (5900 West Street), thence South along said East line 341.19 feet, thence East 250.90 feet, more or less, to an old fence, thence North along said fence 341.19 feet to an old fence, thence West along said fence 202.15 feet to the point of beginning. Containing 1.72 acres.
- Parcel 3**
Part of the Northwest Quarter of Section 18, Township 5 North, Range 2 West, Salt Lake Base and Meridian, U.S. Survey; beginning at a point 15.50 chains South and 2.71 chains East of the Northwest corner of said Quarter Section, and running thence South 10.50 chains, thence East 4.0 chains, thence North 10.50 chains, thence West 4 chains to the place of beginning. Containing 4 1/5 acres.
- Parcel 4**
Part of the Northwest Quarter of Section 18, Township 5 North, Range 2 West, Salt Lake Meridian, U.S. Survey; beginning at a point 15.15 (should read 15.50) chains South and 6.71 chains East from the Northwest corner of said Section 18; and running thence South 10.5 chains, thence East 73.36 feet, thence North 160 feet, thence East 150 feet, thence South 160 feet, thence East 35.64 feet, thence North 10.5 chains, thence West 4 chains to place of beginning. Containing 3.65 acres, m/l.
- Parcel 5**
Part of the Northeast quarter of Section 13, and part of the Northwest Quarter of Section 18, Township 5 North, Range 3 West, and Township 5 North, Range 2 West, respectively, Salt Lake Base and Meridian, U.S. Survey; beginning at a point South 920 feet from the Northwest corner of said Section 18; and running thence West 48.75 feet to the East line of State Road No. 137 (5900 West Street); thence North along said East line 62.00 feet, thence East 262.90 feet, thence South 165 feet, more or less, to an old fence line, thence West 12.00 feet, thence North 103.00 feet, thence West 202.15 feet to the point of beginning.
- Parcel 6**
Part of the Northwest quarter of Section 18, Township 5 North, Range 2 West, Salt Lake Base and Meridian, U.S. Survey; beginning at a point South 858 feet and East 214.15 feet from the Northwest corner of said Section 18; and running thence East 100 feet; thence South 165 feet, more or less, to an old fence; thence West 100 feet; thence North 165 feet, more or less, to the point of beginning.
- Parcel 4 (As-surveyed Description)**
A part of the Northwest Quarter of Section 18, Township 5 North, Range 2 West, Salt Lake Base and Meridian, U.S. Survey; Beginning at a point 1029.71 feet South 0°19'08" West and 466.75 feet South 89°35'46" West from the Northwest corner of said Section 18; and running thence South 0°19'08" West 693.39 feet, thence South 89°40'52" East 87.27 feet to an existing fence line; thence two (2) courses along said existing fence line as follows: North 0°27'50" East 166.96 feet to a fence corner and South 89°35'12" East 176.31 feet; thence North 0°19'08" West 526.33 feet thence North 89°35'46" West 264.00 feet to the point of beginning. Contains 3.53 Acres More or Less

RECEIVED
AUG 16 2011
004580

SURVEYOR'S CERTIFICATE

I, Andy Hubbard, do hereby certify that I am a Professional Land Surveyor, and that I hold Certificate No. 6242920, in accordance with Title 58, Chapter 22, of the Professional Engineers and Surveyors Licensing Act, and I have made a survey of the above described property according to Section 17-23-17 and that the above plat correctly shows the true dimensions of the property surveyed.

Date 6-28-2011

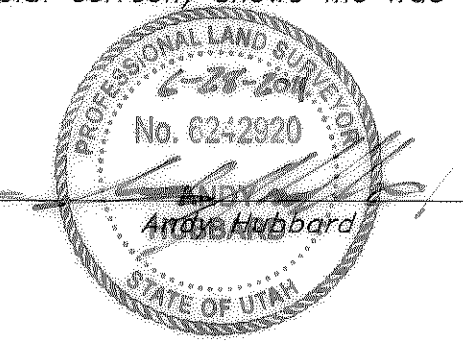

GREAT BASIN ENGINEERING
 5746 SOUTH 1475 EAST, GEDEN, UTAH 84403
 MAIN (801) 394-4515, S.L.L.C. (801) 392-7544
 WWW.GREATBASINENGINEERING.COM

Property Survey
 LDS Church Hooper (5900 West)
 5900 West 4700 South
 Hooper City, Weber County, Utah
 A part of Section 18, T5N, R2W, SLB&M, U.S. Survey

28 June, 2011
 SHEET NO.
C1
 10N709