

RECORD OF SURVEY

PART OF THE N.W. 1/4 OF SECTION 4 AND N.E. 1/4 OF SECTION 29, T. 7 N., R. 1 E., S. L. B. & M.

N.W. COR. SEC. 29,
T.7N., R.1E., S.L.B.&M.
POSITION PER RECORD

N. 1/4 COR. SEC. 29,
T.7N., R.1E., S.L.B.&M.
POSITION PER RECORD



SCALE: 1" = 100'


- = 5/8" DIA. LENGTH REBAR WITH CAP STAMPED 172757
- = FOUND STREET MONUMENT



SURVEYOR'S CERTIFICATE

I, DOUG L. GRAHAM, A PROFESSIONAL LICENSED LAND SURVEYOR AS PRESCRIBED BY THE LAWS OF THE STATE OF UTAH AND HOLDING LICENSE NUMBER 172757 DO HEREBY CERTIFY THAT A SURVEY OF THE BELLY DESCRIBED PROPERTY HAS BEEN MADE BY MYSELF OR UNDER MY DIRECTION AND THE PLAT HEREOF IS A TRUE AND CORRECT REPRESENTATION OF SAID SURVEY.

DATE: 10/04/11 SIGNED: _____

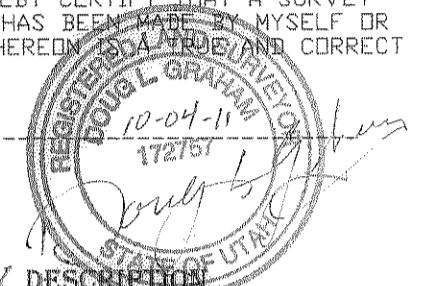

PARCEL 1 - BOUNDARY DESCRIPTION


A PART OF THE NORTHWEST QUARTER OF SECTION 29, TOWNSHIP 7 NORTH, RANGE 1 EAST, SALT LAKE BASE AND MERIDIAN, U.S. SURVEY, DESCRIBED AS FOLLOWS:
BEGINNING AT A POINT SOUTH 89°31'08" EAST ALONG THE QUARTER SECTION LINE 825.34 FEET FROM THE NORTHWEST CORNER OF SAID SECTION 29; RUNNING THENCE SOUTH 89°31'08" EAST 323.56 FEET; THENCE SOUTH 15°18'17" WEST 1305.45 TO THE CENTER OF ROAD; THENCE NORTH 83°23'08" WEST 361.01 FEET; THENCE NORTH 17°16'52" EAST 1277.98 FEET TO THE POINT OF BEGINNING. CONTAINS 9.891 ACRES.

PARCEL 2 - BOUNDARY DESCRIPTION

A PART OF THE NORTHWEST QUARTER OF SECTION 29, TOWNSHIP 7 NORTH, RANGE 1 EAST, SALT LAKE BASE AND MERIDIAN, U.S. SURVEY, DESCRIBED AS FOLLOWS:
BEGINNING AT A POINT SOUTH 89°31'08" EAST ALONG THE QUARTER SECTION LINE 1148.90 FEET; RUNNING THENCE SOUTH 89°31'08" EAST 304.38 FEET; THENCE SOUTH 12°36'25" WEST 1330.26 FEET TO CENTER OF ROAD; THENCE NORTH 83°23'08" WEST 361.01 FEET; THENCE NORTH 15°18'17" EAST 1305.45 FEET TO THE POINT OF BEGINNING. CONTAINS 9.891 ACRES.


PARCEL 3 - BOUNDARY DESCRIPTION

A PART OF THE NORTHWEST QUARTER OF SECTION 29, TOWNSHIP 7 NORTH, RANGE 1 EAST, SALT LAKE BASE AND MERIDIAN, U.S. SURVEY, DESCRIBED AS FOLLOWS:
BEGINNING AT A POINT SOUTH 89°31'08" EAST ALONG THE QUARTER SECTION LINE 1453.28 FEET; RUNNING THENCE SOUTH 89°31'08" EAST 17.79 FEET; THENCE NORTH 00°28'52" EAST 71.88 FEET; THENCE S17°47'43" EAST 57.82 FEET; THENCE SOUTH 65°28'37" EAST 54.04 FEET; THENCE SOUTH 58°45'01" EAST 60.46 FEET; THENCE SOUTH 56°46'55" EAST 37.07 FEET; THENCE SOUTH 47°55'37" EAST 87.22 FEET; THENCE SOUTH 51°49'51" EAST 3.27 FEET; THENCE SOUTH 09°17'41" WEST 793.94 FEET; THENCE SOUTH 09°17'41" WEST 318.48 FEET; THENCE SOUTH 08°39'20" WEST 161.93 FEET TO CENTER OF ROAD; THENCE NORTH 83°23'08" WEST 361.01 FEET; THENCE NORTH 12°36'25" EAST 1330.26 FEET TO THE POINT OF BEGINNING. CONTAINS 9.893 ACRES.

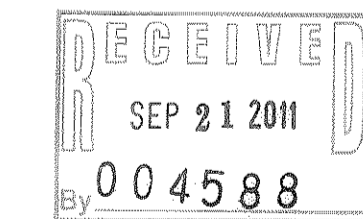

SURVEYOR'S NARRATIVE

THE PURPOSE OF THIS SURVEY WAS TO DIVIDE THE PARENT PARCEL FOR THE PURPOSE OF SETTLING AN ESTATE, ADJOINING DEEDS AND SURVEYS WERE USED TO ESTABLISH THE BOUNDARY OF THE PARCEL AND THE SEPARATE PARCELS WERE CREATED AT THE OWNERS DIRECTION.

 LANDMARK SURVEYING, INC. A COMPLETE LANDSURVEYING SERVICE 4646 S. 3500 W. #A-3, WEST HAVEN, UTAH 84401 PHONE 801-731-4075 FAX 801-731-8506	
CLIENT: TAMMY PETIGREW	
LOCATION: PART OF THE N.W. 1/4 OF SEC. 29 T.7N., R.1E., S.L.B.&M.	
SURVEYED: AUGUST 2010	
REVISIONS:	DRAWN BY: DLG
	CHECKED BY: DLG
	DATE: 08-26-10
	FILE: 3168RDS

WEST 1/4 COR. SEC. 29,
T.7N., R.1E., S.L.B.&M.
WEBER COUNTY BRASS
CAP

EAST 1/4 COR. SEC. 29,
T.7N., R.1E., S.L.B.&M.
WEBER COUNTY BRASS
CAP

S.E. 1/4 COR. SEC. 29,
T.7N., R.1E., S.L.B.&M.
WEBER COUNTY BRASS
CAP