


**ABSTRACT**  
This survey was done at the request of Mr. Frank Noel in order to establish the East boundary of Lot 5, Spring Mountain Ranchettes, Weber County, Utah. The basis of bearings North 18°05'39" West was established along a line through a number of points found along the East boundary of said Subdivision. Both East corners of Lot 5 were staked using #4 rebar 24" in length with an orange Great Basin cap on the top. A green metal fence post was also driven along side. No Government Monuments were tied into.

**DESCRIPTION**  
All of Lot 5 Spring Mountain Ranchettes, Weber County, Utah according to the official plat thereof.


Date: 9-22-87  

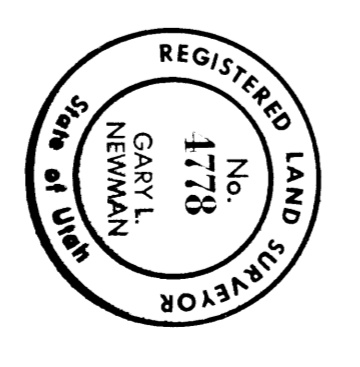

RECEIVED  
JUN 22 1987  
Weber County Auditor

**GREAT BASIN ENGINEERING, INC.**  
CONSULTING ENGINEERS & SURVEYORS  
ODDSEN & SALT LAKE CITY, UTAH

PROPERTY SURVEY  
FRANK NOEL  
LEBETH, WEBER COUNTY, UTAH  
1/2\"