

SURVEYOR'S CERTIFICATE

I, **ROBERT D. KUNZ**, DO HEREBY CERTIFY THAT I AM A REGISTERED PROFESSIONAL LAND SURVEYOR IN THE STATE OF UTAH IN ACCORDANCE WITH TITLE 58, CHAPTER 22, PROFESSIONAL ENGINEERS AND LAND SURVEYORS ACT; AND THAT I HAVE COMPLETED A SURVEY OF THE PROPERTY DESCRIBED ON THIS PLAT IN ACCORDANCE WITH SECTION 17-23-17 AND HAVE VERIFIED ALL MEASUREMENTS, AND HAVE PLACED MONUMENTS AS REPRESENTED ON THIS PLAT. I FURTHER CERTIFY THAT THIS PLAT IS A CORRECT REPRESENTATION OF THE LAND SURVEYED AND HAS BEEN PREPARED IN CONFORMITY WITH THE MINIMUM STANDARDS AND REQUIREMENTS OF THE LAW.

SIGNED THIS 21st DAY OF November, 2011

150228-2201
UTAH LICENSE NUMBER



Robert D. Kunz
ROBERT D. KUNZ

BASIS OF BEARINGS

THE BASIS OF BEARINGS FOR THIS PLAT IS THE SECTION LINE BETWEEN THE NORTH QUARTER CORNER AND THE NORTHWEST CORNER OF SECTION 33, T.7N., R.1E., SALT LAKE BASE AND MERIDIAN, U.S. SURVEY. SHOWN HEREON AS N89°15'44\"/>

NARRATIVE

THE PROPOSE OF THIS SURVEY IS TO LOCATE THE FOLLOWING PROPERTIES IDENTIFIED AS WEBER COUNTY PARCELS 22-040-0020, 22-040-0001, 22-040-0013, 22-040-0019, 22-040-0012, 22-040-0008, 22-040-0004 AND 22-040-0005. THESE PROPERTIES ARE IN SECTION 33, T.7N., R.1E., AND SECTION 4, T.6N., R.1W., SALT LAKE BASE AND MERIDIAN, THE RECORD MONUMENTS AT THE SOUTHEAST, SOUTH QUARTER, SOUTHWEST, NORTHWEST, NORTH QUARTER, AND NORTHEAST CORNERS WERE LOCATED. THE QUARTER SECTION LINES WERE ESTABLISHED BY LOCATING REBAR ALONG THE COMMON BOUNDARY AND ROTATING THE DESCRIPTION TO THE COMMON BASIS OF BEARING AND FOUND MONUMENTS. ALL CORNERS WERE EITHER FOUND GOVERNMENT MONUMENTS, FOUND REBAR SET BY OTHERS, OR SET WITH 3/8\"/>

BOUNDARY DESCRIPTION

A PART OF THE NW QUARTER OF SECTION 33 TOWNSHIP 7 NORTH, RANGE 1 EAST, SALT LAKE BASE AND MERIDIAN, U.S. SURVEY;



BEGINNING AT A POINT ON THE QUARTER SECTION LINE WHICH LIES N00°13'41\"/>

LEGEND

- ◆ = SECTION CORNER
- ⊕ = FOUND REBAR MARKED "REEVE"
- = FOUND REBAR MARKED "GARDNER"
- = SET REBAR MARKED "REEVE"
- × = FOUND NAIL
- = BOUNDARY LINE
- - - = SECTION TIE LINE
- - - - - = EXISTING FENCE LINE
- ▨ = WET LANDS AS DETERMINED BY OTHERS

CURVE TABLE

CURVE	RADIUS	LENGTH	CHD LTH	CHORD DIR	DELTA
CT	504.11'	157.84'	157.20'	S53°02'17\"/>	17°56'23\"/>

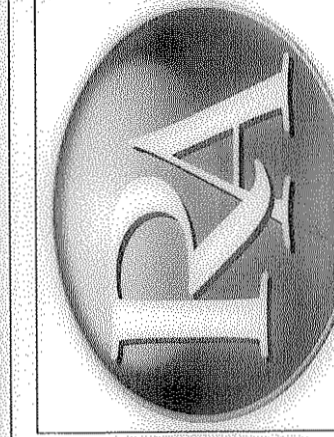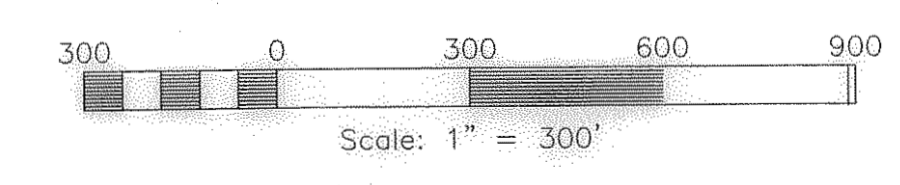

REVISIONS	DESCRIPTION

RECORD OF SURVEY

SKYLINE MOUNTAIN PROPERTIES PARTNERS

Project Info.
Surveyor: R. KUNZ
Designer: N. ANDERSON
Begin Date: 01-06-09
Name: SKYLINE MOUNTAIN PROPERTIES PARTNER
Scale: 1"=300'
Checked:
Number: 5989-01

Sheet	1
1	Sheets