

**CERTIFICATE**

I, VON R. HILL, A PROFESSIONAL LAND SURVEYOR ACCORDING TO THE LAWS OF THE STATE OF UTAH, DO CERTIFY THAT I HAVE SURVEYED THE PARCEL OF GROUND SHOWN HEREON ACCORDING TO UTAH STATE CODE 17-23-17.



**DESCRIPTION**

ALL OF LOT 26 THE POINTS AT STONE MOUNTAIN PHASE 3, SUBDIVISION BEING PART OF THE NORTH HALF OF SECTION 15, TOWNSHIP 5 NORTH, RANGE 1 WEST, SALT LAKE BASE AND MERIDIAN, OGDEN CITY, WEBER COUNTY, UTAH.

CONTAINING 0.669 ACRES


SUBDIVISION WAS RECORDED FEBRUARY 17, 2000 IN BOOK 51, PAGE 54 OF OFFICIAL RECORDS, ENTRY #1690540.

**NARRATIVE**

THE PURPOSE OF THE SURVEY WAS TO MARK THE PROPERTY CORNERS. THIS WAS DONE BASED ON THE MONUMENTS SHOWN, THE FOUND NAILS AND FOUND REBAR AND CAP (EXCEPT FOR THE ONE AT THE NORTHEAST CORNER OF SUBJECT PROPERTY) THE FOUND REBAR AND CAP, FOUND NAILS AND MONUMENT IN THE CUL-DE-SAC ARE CONSISTENT WITH EACH OTHER. THE FOUND MONUMENT IN LAKEVIEW WAY DID NOT MATCH THE OTHER POINTS. BASIS OF BEARING IS AS SHOWN.

**LEGEND**

- PROPERTY LINE \_\_\_\_\_
- FENCE LINE - - - - -
- ROAD CENTERLINE \_\_\_\_\_
- TIE TO MONUMENT \_\_\_\_\_
- CURB, GUTTER, SIDEWALK - - - - -

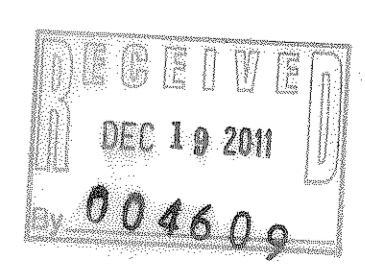

SURVEY REQUESTED BY  
**JERRY BERENSEN**

LOT 26 THE POINTS AT STONE MOUNTAIN PHASE 3  
 LOCATED IN THE NORTH HALF OF SECTION 15, T5N, R1W, SLB&M  
 OGDEN CITY, WEBER COUNTY, UTAH

DRAWN SHM	DATE 9/13/11
APPROVED VRH	DATE 9/13/11
REVISED SHM	DATE 9/19/11
SHM	LINE POINTS SET 10/24/11
SHEET 1 OF 1	
SHEET NAME Boundary	
DRAWING NAME Boundary	
PROJECT NO. 05-462	