


NORTH QUARTER CORNER SECTION 35, T6N, R2W, SLB&M, FOUND WEBER COUNTY BRASS CAP MONUMENT

NE CORNER SECTION 35, T6N, R2W, SLB&M, FOUND WEBER COUNTY BRASS CAP MONUMENT

BASIS OF BEARING S89°36'10"E 2636.93 (RECORD AND MEASURED) 1318.44

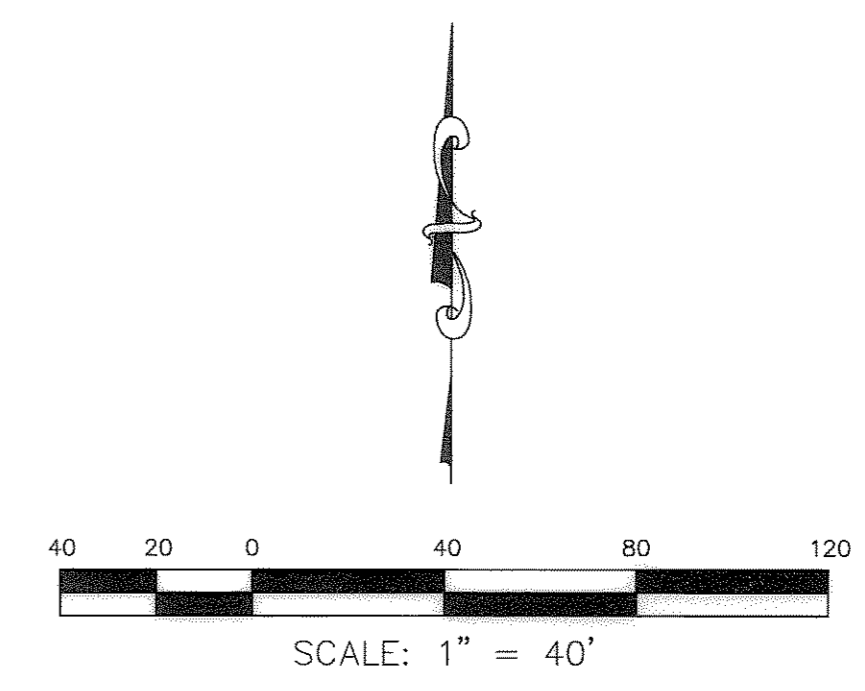

CERTIFICATE

I, VON R. HILL, A PROFESSIONAL LAND SURVEYOR ACCORDING TO THE LAWS OF THE STATE OF UTAH, DO CERTIFY THAT I HAVE SURVEYED THE PARCEL OF GROUND SHOWN HEREON ACCORDING TO UTAH STATE CODE 17-23-17.



DEED DESCRIPTION PARCEL A


ENTRY #1569413, BOOK 1951, PAGE 1147, WEBER COUNTY RECORDER'S OFFICE

A PART OF THE NORTHWEST QUARTER OF NORTHEAST QUARTER OF SECTION 35, TOWNSHIP 6 NORTH, RANGE 2 WEST, OF THE SALT LAKE MERIDIAN, UNITED STATES SURVEY:

BEGINNING ON THE SOUTH LINE OF ROAD, 33 FEET SOUTH OF THE NORTHWEST CORNER OF THE NORTHWEST QUARTER OF THE NORTHEAST QUARTER OF THE NORTHEAST QUARTER OF SAID SECTION 35, THENCE EAST ALONG ROAD 317 FEET, THENCE SOUTH 785 FEET, THENCE WEST 317 FEET, THENCE NORTH 785 FEET TO THE PLACE OF BEGINNING.

NARRATIVE

THE PURPOSE OF THE SURVEY WAS TO MARK THE PROPERTY CORNERS. THIS WAS DONE BASED ON THE MONUMENTS SHOWN. BASIS OF BEARING IS AS SHOWN. THEE 16TH LINE WAS DETERMINED FROM WEBER COUNTY INFORMATION AND OTHER SURVEYS IN THIS AREA.

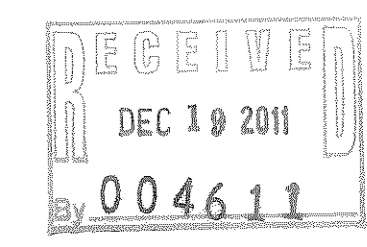

HILL & ARGYLE, Inc.
 Engineering and Surveying
 181 North 200 West, Suite #4, Bountiful, Utah 84010
 (801) 298-2236 Phone, (801) 298-5983 Fax

BONNIE AND DELL ADAMS

LOCATED IN THE NE QUARTER OF SECTION 35, T6N, R2W, SLB&M WEST HAVEN CITY, WEBER COUNTY, UTAH

DRAWN/SHM DATE 9/7/11	APPROVED/RH DATE 9/7/11
REVISIONS	DATE
SHEET 1 OF 1	
SHEET NAME Boundary	
DRAWING NAME Boundary	
PROJECT NO. 11-237	