


SURVEYORS CERTIFICATE

I, Larry M. Buttars, a registered Land Surveyor as prescribed by the laws of the State of Utah, and holding licence No. 2596 do hereby certify that I made a survey of the below described property and the Plat hereon is a true and correct representation of said survey.

Date: 11-10-90 Sign: *Larry M. Buttars*

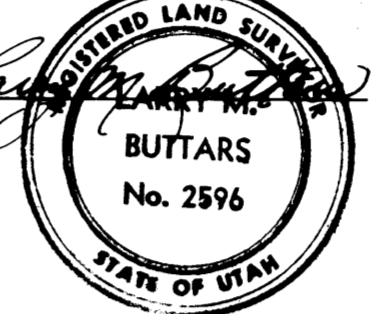

DESCRIPTION

A part of the Northwest Quarter of the Northwest Quarter of Section 35, T.6N., R.1W., S.L.B. & M., U.S. Survey: Beginning at a point S. 0° 23' 39" W. along the section line 394.92 ft. from the Northwest corner of said Section 35, and running thence S. 0° 23' 39" W. 186.17 ft. to the Southeast corner of lot 4, Block 3, Oak Hills, Sub-division to Ogden City, thence S. 89° 02' E. 75.72 ft., thence N. 0° 23' 39" E. 186.17 ft., thence N. 89° 02' W. 75.72 ft. to the point of beginning. Cont. 14,091 sq. ft.

NARRATIVE

The purpose of this survey was for the purchase of property and set the boundary for fencing.  
Basis of bearings: Ogden City Engineering date of record.

LEGEND

- Set 3/4" x 24" re-bar with plastic cap stamped L. Buttars R.L.S. 2596
- Set P.K. nail with ribbon

RECEIVED

JAN 17 1991

Weber County Surveyor

<b>BUTTARS SURVEYING</b>	
1815 26 <sup>TH</sup> STREET	OGDEN, UT. 84401
PHONE	392-5291
CLIENT: DIANA S. ELLIS	
SURVEY LOCATION:	
PART OF N.W. 1/4 OF N.W. 1/4 SEC. 35, T.6N., R.1W. (EAST OGDEN CITY LIMITS AT 26 <sup>TH</sup> ST.)	
SURVEY DATE: 11-10-90	