

Boundary Description

The East 1/2 of Lots 1, 2, and 3, Block 28, Lake View Addition, South Ogden City, Weber County, Utah and the East 46 ft. of Lots 4, 5, and the East 46 ft. of the North 1/2 of Lot 6, Block 28, Lake View Addition, South Ogden City, Weber County, Utah.

Location

Part of Block 28 of Lake View Addition in South Ogden City, Weber County, Utah in the Southeast Quarter of Section 5, T. 5 N., R. 1 W., S.L.B.&M.

Narrative

PURPOSE OF SURVEY
To locate the property for the owner with intent to improve.

BASIS OF ESTABLISHMENT
Our instrument was set on the Spike at the intersection of 37th Street and Kiesel Avenue, and the Monument at Washington Boulevard and 37th Street was sighted as our basis of bearing. From this point the corners were radially set.


FOUND MONUMENTS
Found monuments include the Spike at 37th and Kiesel, The 3\"/>

Surveyor's Certificate

I, David K. Balling, do hereby certify that I am a Professional Land Surveyor holding Certificate No. 175114 as prescribed under the laws of the State of Utah and that I have made a survey of the property shown and described in Warranty Deed as Entry No. 2496890 of the Weber County Records and that this survey is correct.

June 22, 2011
Date

David K. Balling
Utah Surveyor No. 175114

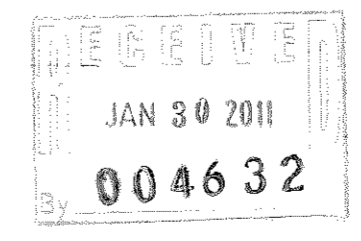

142.77' = Measured Distance = Plotted Distance

Balling Engineering
Civil Engineering * Surveying * Planning
Phone: (801) 295-7237
Fax: (801) 299-0419
323 E. Pages Lane
Centerville, Utah 84014

Yamamoto Property
Survey of 357 E 37th Street
For: Roy Yamamoto 1684 Country Hills Dr.
Ogden, Utah
Phone: 510-9595

Revisions	Date	Description	By

Received
JUN 27 2011