

DRAWING NUMBER

000467

PLAN HOLD CORPORATION • IRVINE, CALIFORNIA
REORDER BY NUMBER 075AR
POSITION EDGE OF PRINT ON THIS LINE

DRAWING NUMBER

000467

PLAN HOLD CORPORATION • IRVINE, CALIFORNIA
REORDER BY NUMBER 075AR
POSITION EDGE OF PRINT ON THIS LINE

DRAWING NUMBER

000467

PLAN HOLD CORPORATION • IRVINE, CALIFORNIA
REORDER BY NUMBER 075AR
POSITION EDGE OF PRINT ON THIS LINE

DRAWING NUMBER

000467

PLAN HOLD CORPORATION • IRVINE, CALIFORNIA
REORDER BY NUMBER 075AR
POSITION EDGE OF PRINT ON THIS LINE




All of Lot 66, Woodland Estates Subdivision III, Weber County, Utah according to the official plat hereof. Together with the following described part of Lot 65 in said Subdivision; beginning at the most Northerly corner of said Lot 65 and running thence South 57°28'35" East 50.00 feet, South 32°31'25" West 315.00 feet, thence North 74°10'32" West 52.20 feet to point which bears South 32°31'25" West 330.00 feet from the point of beginning; thence North 32°31'25" East 330.00 feet to the point of beginning.

Contains 1.674 Acres

CLIENT NEEDED A BOUNDARY SURVEY PRIOR TO CONSTRUCTION OF HOME. THE BRASS MONUMENT AND RAIL ROAD SPIKE WERE USED FOR CONTROL AND THEY WERE VERIFIED BY THE REBARS THAT WERE FOUND.

I, Glenn Ravenberg, do hereby certify that I am a registered Land Surveyor, and that I hold certificate No. 3835, as prescribed by the Laws of the State of Utah, and I have made a survey of the above described property. I further certify that above plat correctly shows the true dimensions of the property surveyed.

Glenn Ravenberg

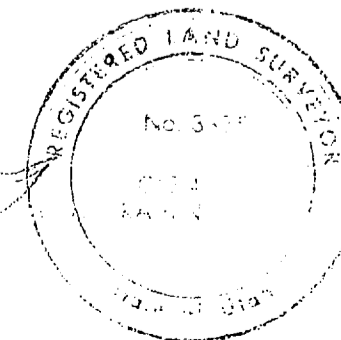

PART OF N.E. 1/4 OF SEC. 23, T5N, R1W, S1B&M

INTERMOUNTAIN SURVEYING
Layton, Utah 84041 (801) 544-1170

PROPERTY SURVEY
FOR
JOE STRINGER

PT. OF LOT 65 & ALL OF LOT 66 WOODLAND
ESTATES PS-89-25
APRIL 10, 1989

RECEIVED
JAN 25 1989
Weber County Surveyor