DRAWING NUMBER

000468

PLAN HOLD CORPORATION • IRVINE, CALIFORNIA REDROER BY NUMBER 075AR חמטיזיסא בסמב סב הצואר הא דעור נואנ

DRAWING NUMBER

PLAN HOLD CORPORATION . IRVINE, CALIFORNIA

REORDER BY NUMBER 075AR

000468

000468

REDROER BY NUMBER 075AR


PLAN HOLD CORPORATION • IRVINE, CALIFORNIA

DRAWING NUMBER

DRAWING NUMBER

000468

FLAN HOLD CORPORATION . IRVINE, CALIFORNIA REORDER BY NUMBER 075AP

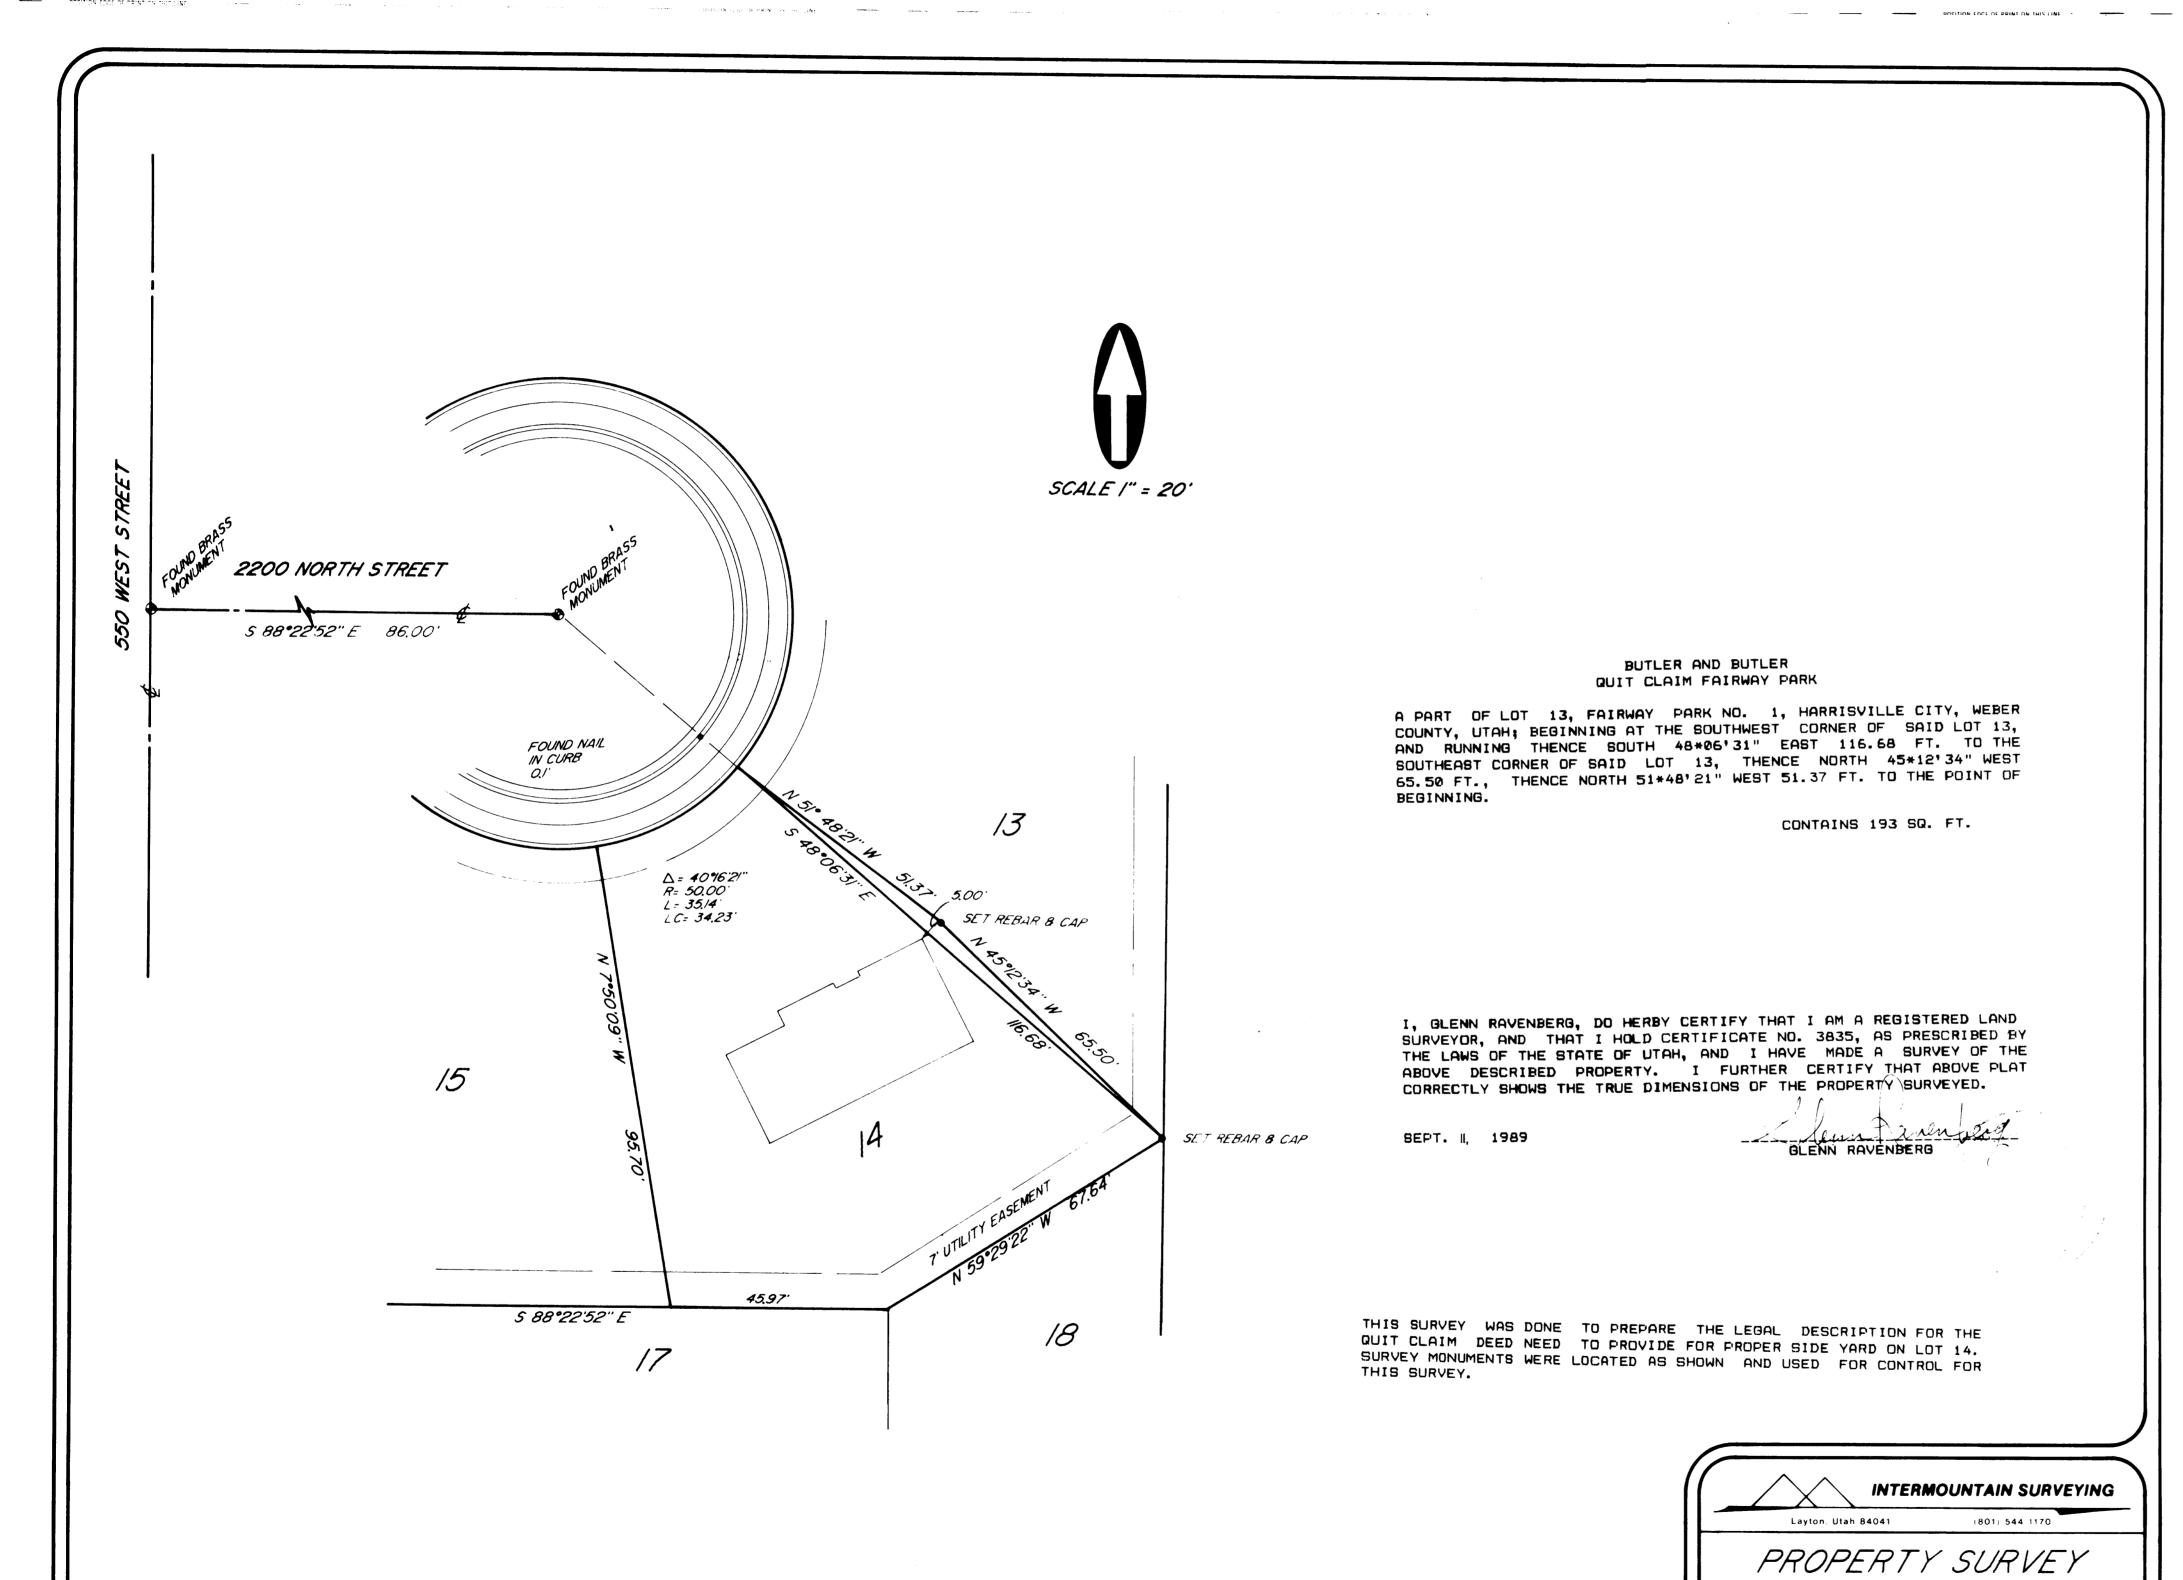

000468.

FOR
BUTLER & BUTLER
PART OF LOT 13, FAIRWAY PARK NO, 1 SUBD.

SEPT. II, 1989

RECEIVED

JAN 2 5 199091

Weber County Surveyor