

# RECORD OF SURVEY


FOR MIDTOWN COMMUNITY HEALTH CENTER

PART OF LOT 3, 4, AND 5 OF BLOCK 41, PLAT A, OGDEN CITY SURVEY OGDEN CITY, WEBER COUNTY, UTAH SEPTEMBER, 2012

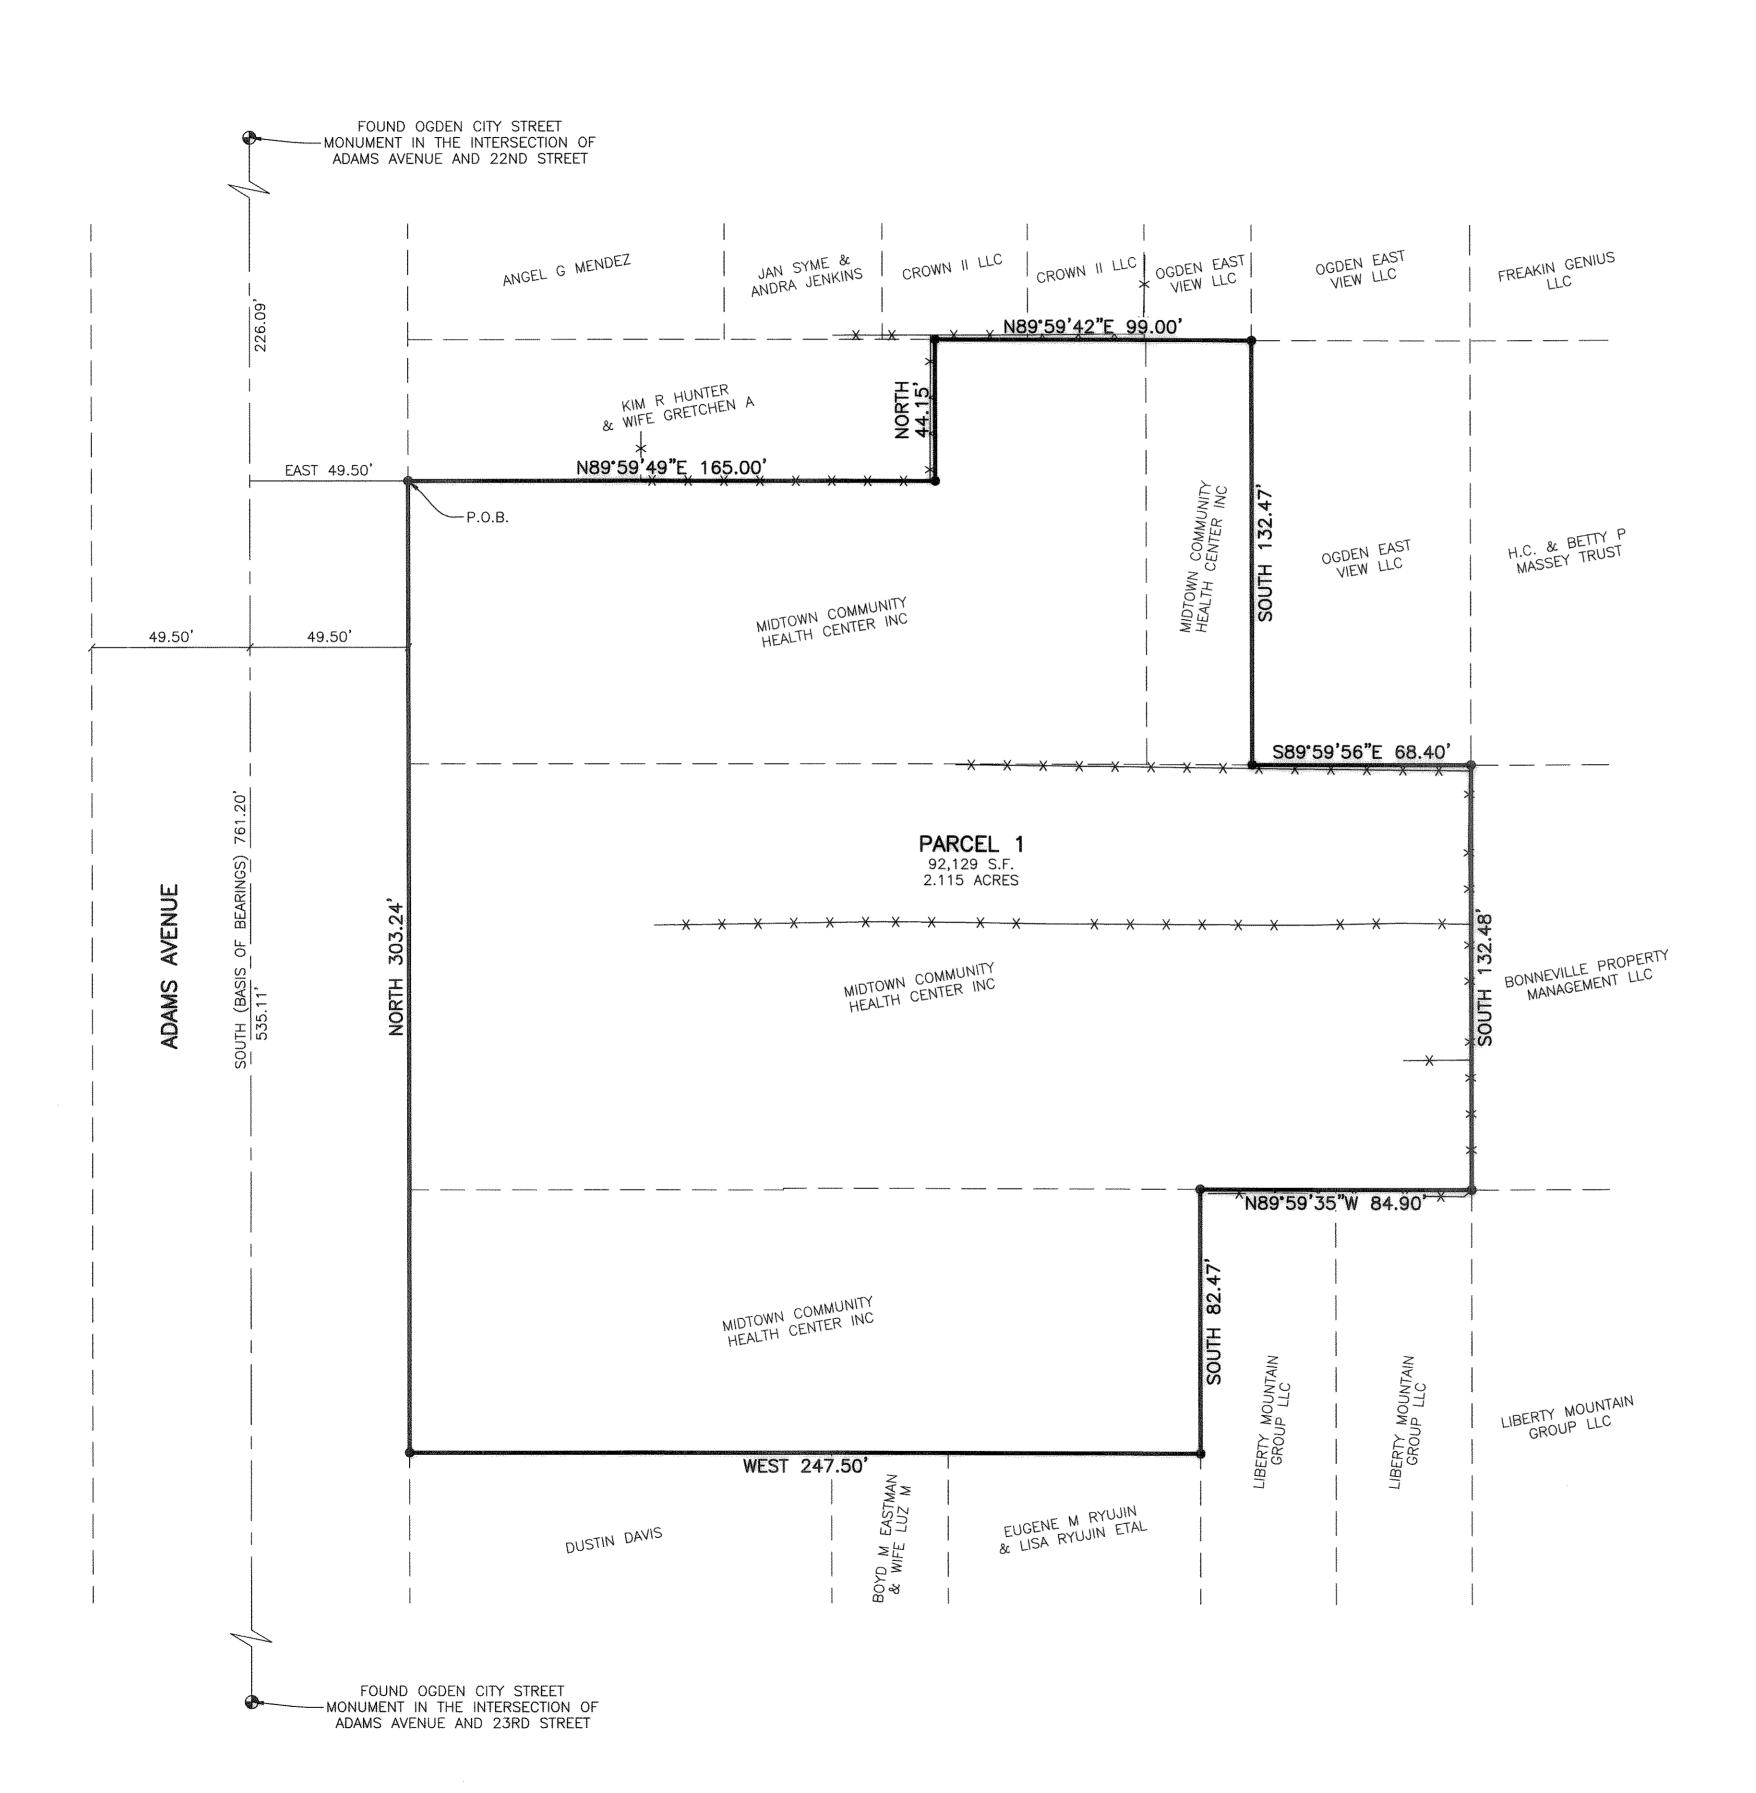

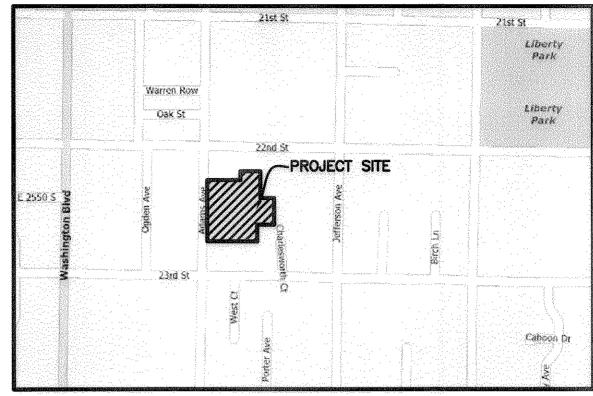

**VICINITY MAP** NO SCALE

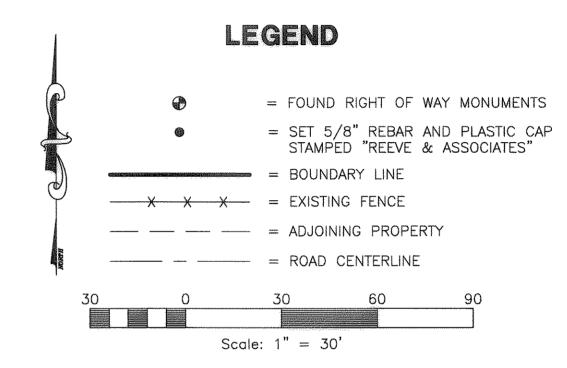

### **BASIS OF BEARINGS**

THE BASIS OF BEARINGS FOR THIS PLAT IS THE OGDEN CITY MONUMENT LINE IN ADAMS AVENUE BETWEEN 22ND AND 23RD STREETS SHOWN HEREON AS SOUTH.

## NARRATIVE

THE PURPOSE OF THIS PLAT IS TO DETERMINE THE BOUNDARY OF THE BELOW DESCRIBED PROPERTY. ALL CORNERS WERE SET WITH A %" REBAR AND PLASTIC CAP STAMPED "REEVE & ASSOCIATES".

#### **BOUNDARY DESCRIPTION**

PART OF LOT 3, 4, AND 5 OF BLOCK 41, PLAT A, OGDEN CITY SURVEY, DESCRIBED AS FOLLOWS:

BEGINNING AT A POINT ON THE EAST RIGHT OF WAY LINE OF ADAMS AVENUE, SAID POINT BEING SOUTH 226.09 FEET AND EAST 49.50 FEET FROM A FOUND OGDEN CITY STREET MONUMENT IN THE INTERSECTION OF ADAMS AVENUE AND 22ND STREET; THENCE N89°59'49"E 165.00 FEET; THENCE NORTH 44.15 FEET; THENCE N89°59'42"E 99.00 FEET; THENCE SOUTH 132.47 FEET; THENCE S89°59'56"E 68.40 FEET; THENCE SOUTH 132.48 FEET; THENCE N89°59'35"W 84.90 FEET; THENCE SOUTH 82.47 FEET; THENCE WEST 247.50 FEET; THENCE NORTH 303.24 FEET TO THE POINT OF BEGINNING.

CONTAINING 92,129 SQUARE FEET AND 2.115 ACRES

## SURVEYOR'S CERTIFICATE

ROBERT D. KUNZ , DO HEREBY CERTIFY THAT I AM A REGISTERED PROFESSIONAL LAND SURVEYOR IN THE STATE OF UTAH IN ACCORDANCE WITH TITLE 58, CHAPTER 22, PROFESSIONAL ENGINEERS AND LAND SURVEYORS ACT; AND THAT I HAVE COMPLETED A SURVEY OF THE PROPERTY DESCRIBED ON THIS PLAT IN ACCORDANCE WITH SECTION 17-23-17 AND HAVE VERIFIED ALL MEASUREMENTS, AND HAVE PLACED MONUMENTS AS REPRESENTED ON THIS PLAT. I FURTHER CERTIFY THAT THIS PLAT IS A CORRECT REPRESENTATION OF THE LAND SURVEYED AND HAS BEEN PREPARED IN CONFORMITY WITH THE MINIMUM STANDARDS AND REQUIREMENTS OF THE LAW.

150228-2201 UTAH LICENSE NUMBER

Reeve & Associates, Inc. - Solutions You Can Build On

ROBERT D. KUNZ

004733

BLOCK WEBER ORD SOF 

Project Info. Surveyor: R. KUNZ

Checked:

Designer: N. ANDERSON Begin Date:

09-27-12 Name: MIDTOWN RECORD OF SURVEY 1"=30' Scale: \_

Number: 4987-01