


REVISIONS	DESCRIPTION
DATE	

DELORA FOWERS BOUNDARY SURVEY
 WEBER COUNTY, UTAH
PARCELS 100-023-0015 AND 0014

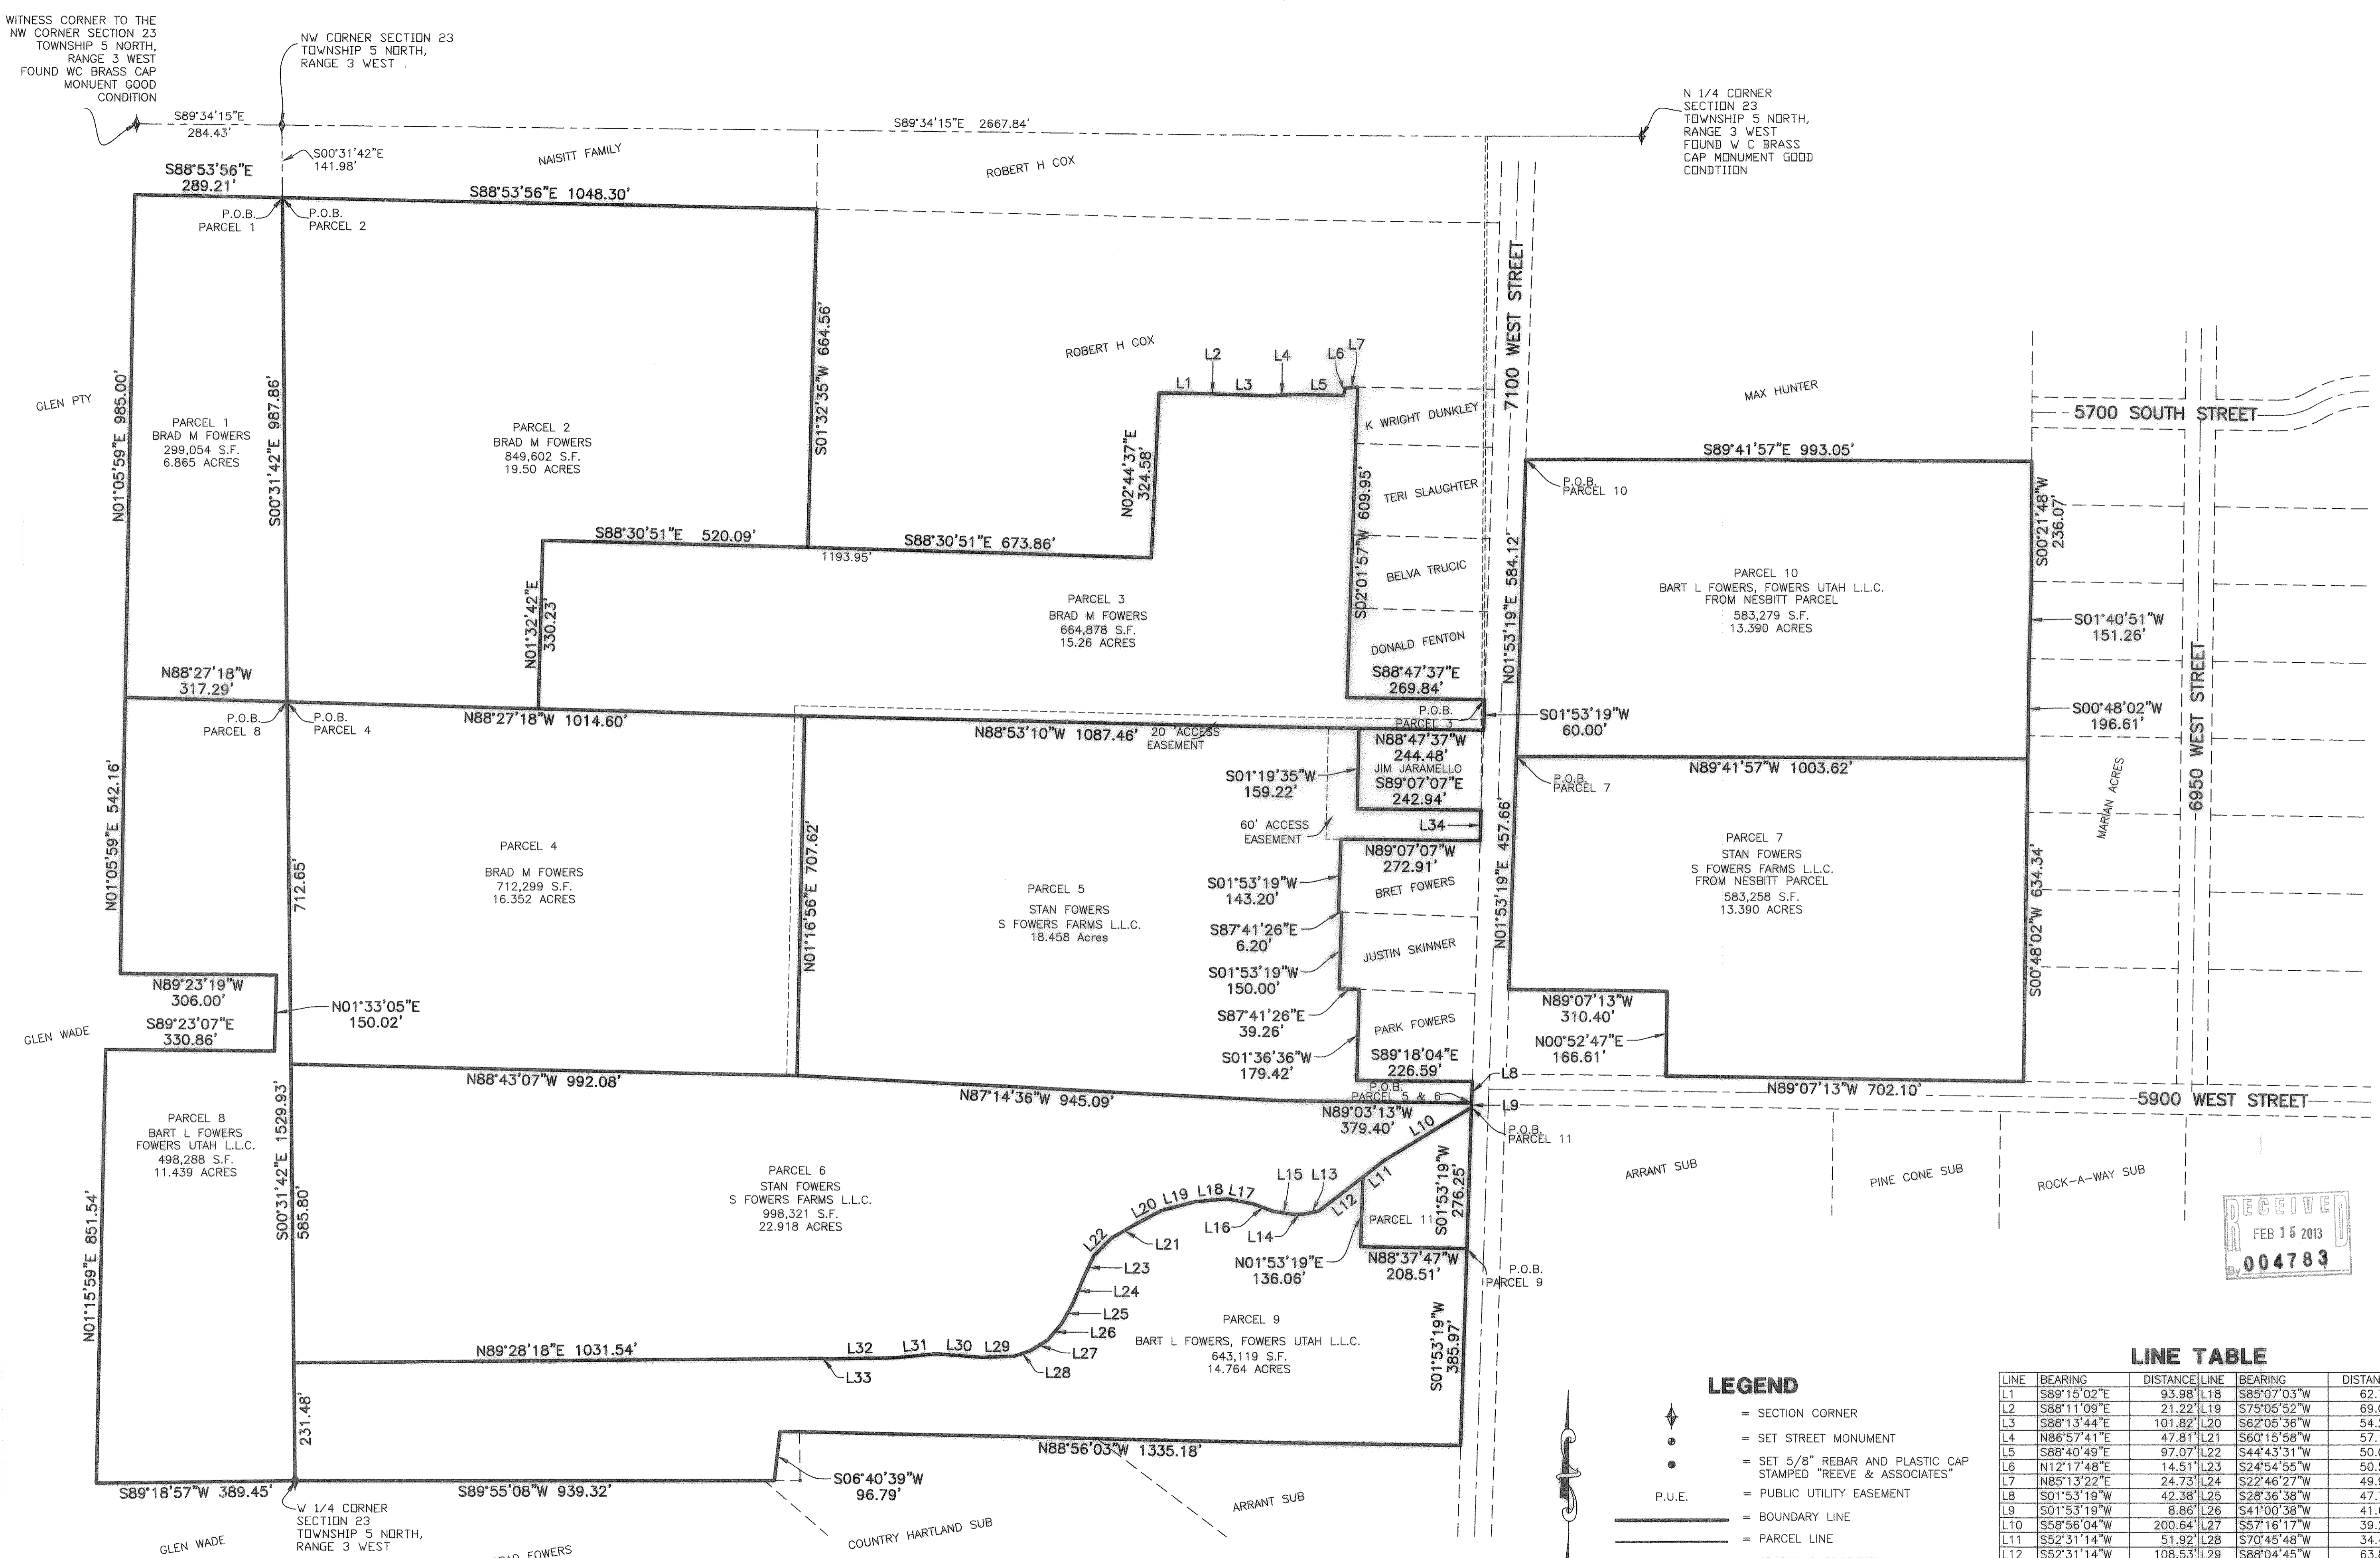


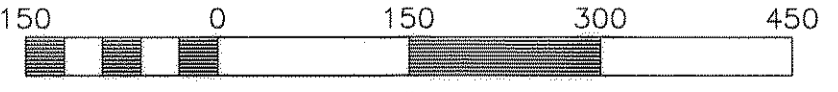
RECEIVED
 FEB 15 2013
 004783

LINE TABLE

LINE	BEARING	DISTANCE	LINE	BEARING	DISTANCE
L1	S89°15'02"E	93.98'	L18	S85°07'03"W	62.77'
L2	S88°11'09"E	21.22'	L19	S75°05'52"W	69.05'
L3	S88°13'44"E	101.82'	L20	S62°05'36"W	54.25'
L4	N88°57'41"E	47.81'	L21	S60°15'58"W	57.13'
L5	S88°40'49"E	97.07'	L22	S44°43'31"W	50.01'
L6	N12°17'48"E	14.51'	L23	S24°54'55"W	50.55'
L7	N85°13'22"E	24.73'	L24	S22°46'27"W	49.99'
L8	S01°53'19"W	42.38'	L25	S28°36'38"W	47.77'
L9	S01°53'19"W	8.86'	L26	S41°00'38"W	41.61'
L10	S88°56'04"W	200.64'	L27	S57°16'17"W	39.28'
L11	S52°31'14"W	51.92'	L28	S70°45'48"W	34.45'
L12	S52°31'14"W	108.53'	L29	S88°04'45"W	63.87'
L13	S77°30'52"W	27.80'	L30	N85°41'06"W	90.01'
L14	S87°45'38"W	21.94'	L31	S84°02'35"W	80.46'
L15	N81°47'08"W	40.60'	L32	S88°52'29"W	135.03'
L16	N69°25'16"W	43.00'	L33	N85°54'17"W	12.17'
L17	N79°26'54"W	50.97'	L34	S01°53'19"W	60.01'

LEGEND

- ◆ = SECTION CORNER
- = SET STREET MONUMENT
- = SET 5/8" REBAR AND PLASTIC CAP STAMPED "REEVE & ASSOCIATES"
- P.U.E. = PUBLIC UTILITY EASEMENT
- = BOUNDARY LINE
- = PARCEL LINE
- = ADJOINING PROPERTY

Scale: 1" = 150'

Project Info.
 Surveyor: R KUNZ
 Designer: N. ANDERSON
 Begin Date: 4/12/2012
 Name: FOWERS BOUNDARY SURVEY
 Scale: 1"=100'
 Checked:
 Number: 5212-03