

**NORTH OGDEN IRRIGATION COMPANY
NOTICE OF INTEREST OF CANAL PROPERTY EASEMENT**

PLEASE TAKE NOTICE that the North Ogden Irrigation Company, a Utah corporation (the "Company"), claims prescriptive easement rights to certain real property in Weber County, Utah, for ownership, use, operation and maintenance of a canal, roadway and related water delivery facilities. Said canal property has been in use for the delivery of water for far in excess of the 20-year prescriptive use period. Said canal has been continuously operated and maintained in its present location since the year 1875. The description of said canal is as follows:

SEE DESCRIPTIONS

In certain areas the Company has acquired fee title to the North Ogden Canal property or acquired easements by deed or grant. Along the remainder of said canal alignment, the Company claims prescriptive easement rights that were acquired by continuous uninterrupted adverse use. The prescriptive easement for the North Ogden Canal and adjacent roadway encompasses the entire easement as described.

The Company claims through prescriptive use the exclusive right to the unobstructed use and occupation of the described easement. FENCES ARE NOT PERMITTED WITHIN THE NORTH OGDEN CANAL PROPERTY. Permanent or temporary structures (other than fences) that encroach within the prescriptive easement property may be permitted by written agreement with the Company where the same will not unreasonably interfere with the safe use, operation and maintenance of the North Ogden Canal.

Dated this 24th Day of June, 2012

NORTH OGDEN IRRIGATION COMPANY

By 
Terel H. Grimley, President

Description A:

A part of the Southeast Quarter of Section 16, Township 6 North, Range 1 West, Salt Lake Base and Meridian, and being described as follows:

This description describes the centerline of the existing canal. The typical minimum necessary distance to maintain and operate the canal is 7 feet easterly from the easterly top of the canal bank and 20 feet westerly from the westerly top of the canal bank.

Beginning at a point being S 01°04'35" W 561.11 feet along the East line of said Section 16 and N 88°55'25" W 2189.97 feet from the East Quarter Corner of said Section 16; thence following the center line of the North Ogden Canal the following 24 courses:

S 08°32'04" W 313.64 feet; thence
S 15°56'43" W 161.54 feet; thence
S 38°45'41" W 176.78 feet; thence
S 35°38'02" W 87.56 feet; thence
S 03°57'17" W 199.12 feet; thence
S 13°33'27" W 55.10 feet; thence
S 29°07'13" W 84.79 feet; thence
S 21°30'58" W 53.06 feet; thence
S 09°44'38" W 123.96 feet; thence
S 09°47'22" E 42.92 feet; thence
S 45°32'08" E 28.90 feet; thence
S 56°27'18" E 83.36 feet; thence
S 48°35'51" E 110.89 feet; thence
S 43°32'45" E 92.18 feet; thence
S 34°07'53" E 141.65 feet; thence
S 38°02'58" E 116.17 feet; thence
S 24°13'11" E 43.05 feet; thence
S 06°12'43" W 142.49 feet; thence
S 12°13'08" E 41.95 feet; thence
S 25°50'03" E 71.08 feet; thence
S 00°10'11" E 53.66 feet; thence
S 18°28'56" E 67.78 feet; thence
S 13°50'35" E 65.38 feet.

Description B:

A part of the Northeast Quarter of Section 21, Township 6 North, Range 1 West, Salt Lake Base and Meridian, and being described as follows:

This description describes the centerline of the existing canal. The typical minimum necessary distance to maintain and operate the canal is 7 feet easterly from the easterly top of the canal bank and 20 feet westerly from the westerly top of the canal bank.

Beginning at a point being N 89°14'55" W 2037.06 feet from the Ogden City Street monument located at the intersection of Harrison Boulevard and 900 South Street; thence following the center line of the North Ogden Canal the following 29 courses:

S 13°50'35" E 14.67 feet; thence
S 02°49'15" E 52.41 feet; thence
S 22°03'44" E 38.11 feet; thence
S 33°20'12" E 116.25 feet; thence
S 40°28'20" E 37.68 feet; thence
S 36°03'35" E 218.58 feet; thence
S 32°38'04" E 74.07 feet; thence
S 49°04'21" E 172.33 feet; thence
S 55°32'48" E 55.17 feet; thence
S 44°13'20" E 54.02 feet; thence
S 32°42'29" E 44.09 feet; thence
S 23°13'43" E 53.25 feet; thence
S 26°40'15" E 76.03 feet; thence
S 27°03'01" E 306.24 feet; thence
S 45°04'16" E 49.69 feet; thence
S 62°29'25" E 54.38 feet; thence
N 85°35'25" E 131.67 feet; thence
N 48°03'45" E 51.44 feet; thence
N 74°50'02" E 90.80 feet; thence
S 85°33'35" E 33.90 feet; thence
S 76°14'57" E 123.51 feet; thence
S 85°05'29" E 141.39 feet; thence
N 86°35'48" E 52.43 feet; thence
S 87°41'57" E 97.87 feet; thence
S 77°46'47" E 118.41 feet; thence
S 72°32'28" E 293.95 feet; thence
S 76°14'58" E 53.65 feet; thence
S 87°15'39" E 40.32 feet; thence
N 69°51'12" E 31.77 feet to the East line of said Section 21.

Description C:

A part of the Northwest Quarter of Section 22, Township 6 North, Range 1 West, Salt Lake Base and Meridian, and being described as follows:

This description describes the centerline of the existing canal. The typical minimum necessary distance to maintain and operate the canal is 7 feet easterly from the easterly top of the canal bank and 20 feet westerly from the westerly top of the canal bank.

Beginning at a point being N 01°09'11" W 1203.67 feet from the Ogden City Street monument located at the intersection of 900 South Street and Harrison Boulevard; thence following the center line of the North Ogden Canal the following 12 courses:

N 69°51'12" E 17.67 feet; thence
N 84°26'21" E 69.09 feet; thence
S 63°04'11" E 49.85 feet; thence
S 78°14'20" E 26.74 feet; thence
N 73°24'58" E 53.55 feet; thence
N 84°42'51" E 57.99 feet; thence
N 79°09'11" E 150.57 feet; thence
S 81°09'38" E 80.57 feet; thence
S 55°52'48" E 55.17 feet; thence
S 62°53'32" E 13.56 feet; thence
S 63°13'57" E 28.56 feet; thence
S 64°14'57" E 54.05 feet; thence
S 62°55'58" E 66.05 feet.

Description D:

A part Section 22, Township 6 North, Range 1 West, Salt Lake Base and Meridian, and being described as follows:

This description describes the centerline of the existing canal. The typical minimum necessary distance to maintain and operate the canal is 7 feet easterly from the easterly top of the canal bank and 20 feet westerly from the westerly top of the canal bank.

Beginning at a point being N 90°00'00" E 1263.46 feet and S 00°00'00" E 89.16 feet from the Ogden City Street monument located at Mountain Road and Canyon Road; thence following the center line of the North Ogden Canal the following 18 courses:

S 84°27'01" W 164.78 feet along the southerly boundary of El Monte Vista subdivision Unit Three; thence
N 74°53'48" W 83.22 feet along the southerly boundary of El Monte Vista subdivision Unit Three; thence N 55°16'38" W 40.80 feet along the southerly boundary of El Monte Vista subdivision Unit Three; thence
N 16°06'45" W 186.97 feet along the westerly boundary of El Monte Vista subdivision Unit Three; thence
N 67°39'50" W 76.24 feet along the southerly boundary of El Monte Vista subdivision Unit One; thence
N 55°10'30" W 67.67 feet along the southerly boundary of El Monte Vista subdivision Unit One; thence N 70°10'16" W 90.52 feet along the southerly boundary of El Monte Vista subdivision Unit One; thence
N 40°02'38" W 30.31 feet; thence
N 28°34'00" W 24.47 feet; thence
N 49°56'29" W 30.52 feet; thence
N 72°36'27" W 10.30 feet; thence
N 86°21'05" W 50.80 feet; thence
N 61°27'13" W 23.74 feet; thence
N 26°27'56" W 110.35 feet to and along the northerly boundary of Calver subdivision; thence
N 37°33'56" W 71.70 feet along the northerly boundary of Calver subdivision; thence
N 42°15'56" W 89.18 feet along the northerly boundary of Calver subdivision; thence
N 62°41'56" W 70.72 feet along the northerly boundary of Calver subdivision; thence
N 61°14'56" W 98.10 feet along the northerly boundary of Calver subdivision; thence
N 55°32'56" W 76.20 feet along the northerly boundary of Calver subdivision; thence
N 88°01'03" W 47.45 feet along the northerly boundary of Calver subdivision; thence
N 80°53'44" W 91.64 feet; thence
N 53°20'43" W 71.38 feet; thence
N 38°32'44" W 41.80 feet; thence
N 26°49'30" W 58.58 feet; thence
N 24°27'03" W 65.30 feet; thence
N 59°27'00" W 177.97 feet to and along the southerly boundary of Laurelwood subdivision; thence

N 50°58'00" W 101.30 feet along the southerly boundary of Laurelwood subdivision; thence

N 66°18'00" W 77.50 feet along the southerly boundary of Laurelwood subdivision; thence


N 43°57'30" W 115.23 feet along the southerly boundary of Laurelwood subdivision; thence

N 54°01'29" W 165.17 feet; thence

N 68°00'22" W 41.48 feet.

SURVEYOR'S CERTIFICATE

I, David D. Strong, do hereby certify that I am a Professional Land Surveyor and that I hold License No. 5331568 in accordance with Title 58, Chapter 22 of the Professional Engineers and Land Surveyors Licensing Act, have completed a survey of the property shown and described herein and in accordance with Section 17-23-17. No survey was performed on adjoining parcels they are shown for reference only.

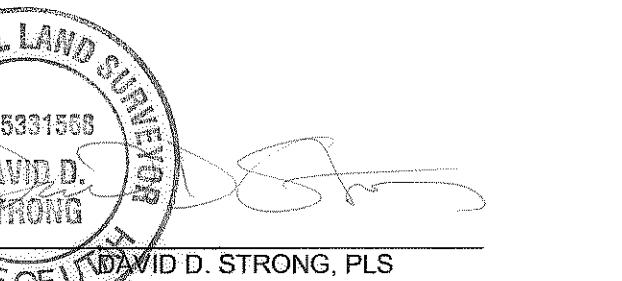

6/20/2012
Date

J-U-B ENGINEERS, INC.

466 North 900 West
Kaysville, Utah 84037


Phone: 801-547-0393
Fax: 801-547-0397
www.jub.com

REUSE OF DRAWINGS
THIS DOCUMENT, AND THE INSTRUMENTS SERVICE IS THE
PROPERTY OF J-U-B ENGINEERS, INC. AND IS NOT TO BE USED IN
WHOLE OR PART FOR ANY OTHER PROJECT WITHOUT THE EXPRESS
WRITTEN AUTHORIZATION OF J-U-B ENGINEERS, INC.

NO.	DESCRIPTION	BY APRIL DATE

NORTH OGDEN CANAL
NORTH OGDEN IRRIGATION COMPANY

PHASE 4
RIGHT-OF-WAY PLAT

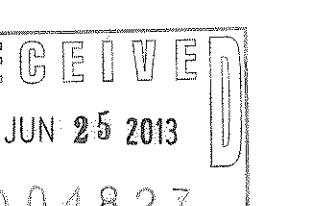

WEBER COUNTY RECORDER

ENTRY NO. _____ FEE PAID _____
FILED FOR RECORD AND RECORDED _____
20_____, AT _____ IN BOOK _____ PAGE _____ OF
OFFICIAL RECORDS.

FILE: NORTH OGDEN CANAL PHASE 4
JUB PROJ. #: 55-07-060

DRAWN BY: DDS/JDM

DESIGN BY: DDS

CHECKED BY: DDS

ONE INCH -

AT FULL SIZE, IF NOT ONE
INCH SCALE ACCORDINGLY



LAST UPDATED: 5/22/2013


SHEET NUMBER:

0

Narrative:

Basis of bearing is based on the Weber County bearing sheets, section corners found for this survey are West Quarter, and the Southwest Corner of Section 24, Township 7 North, Range 2 West and the South Quarter, and the Northeast Corner of Section 30, Township 7 North, Range 1 West. This survey was requested by the North Ogden Canal Company to locate and map their canal, all other parcels are shown for reference only.

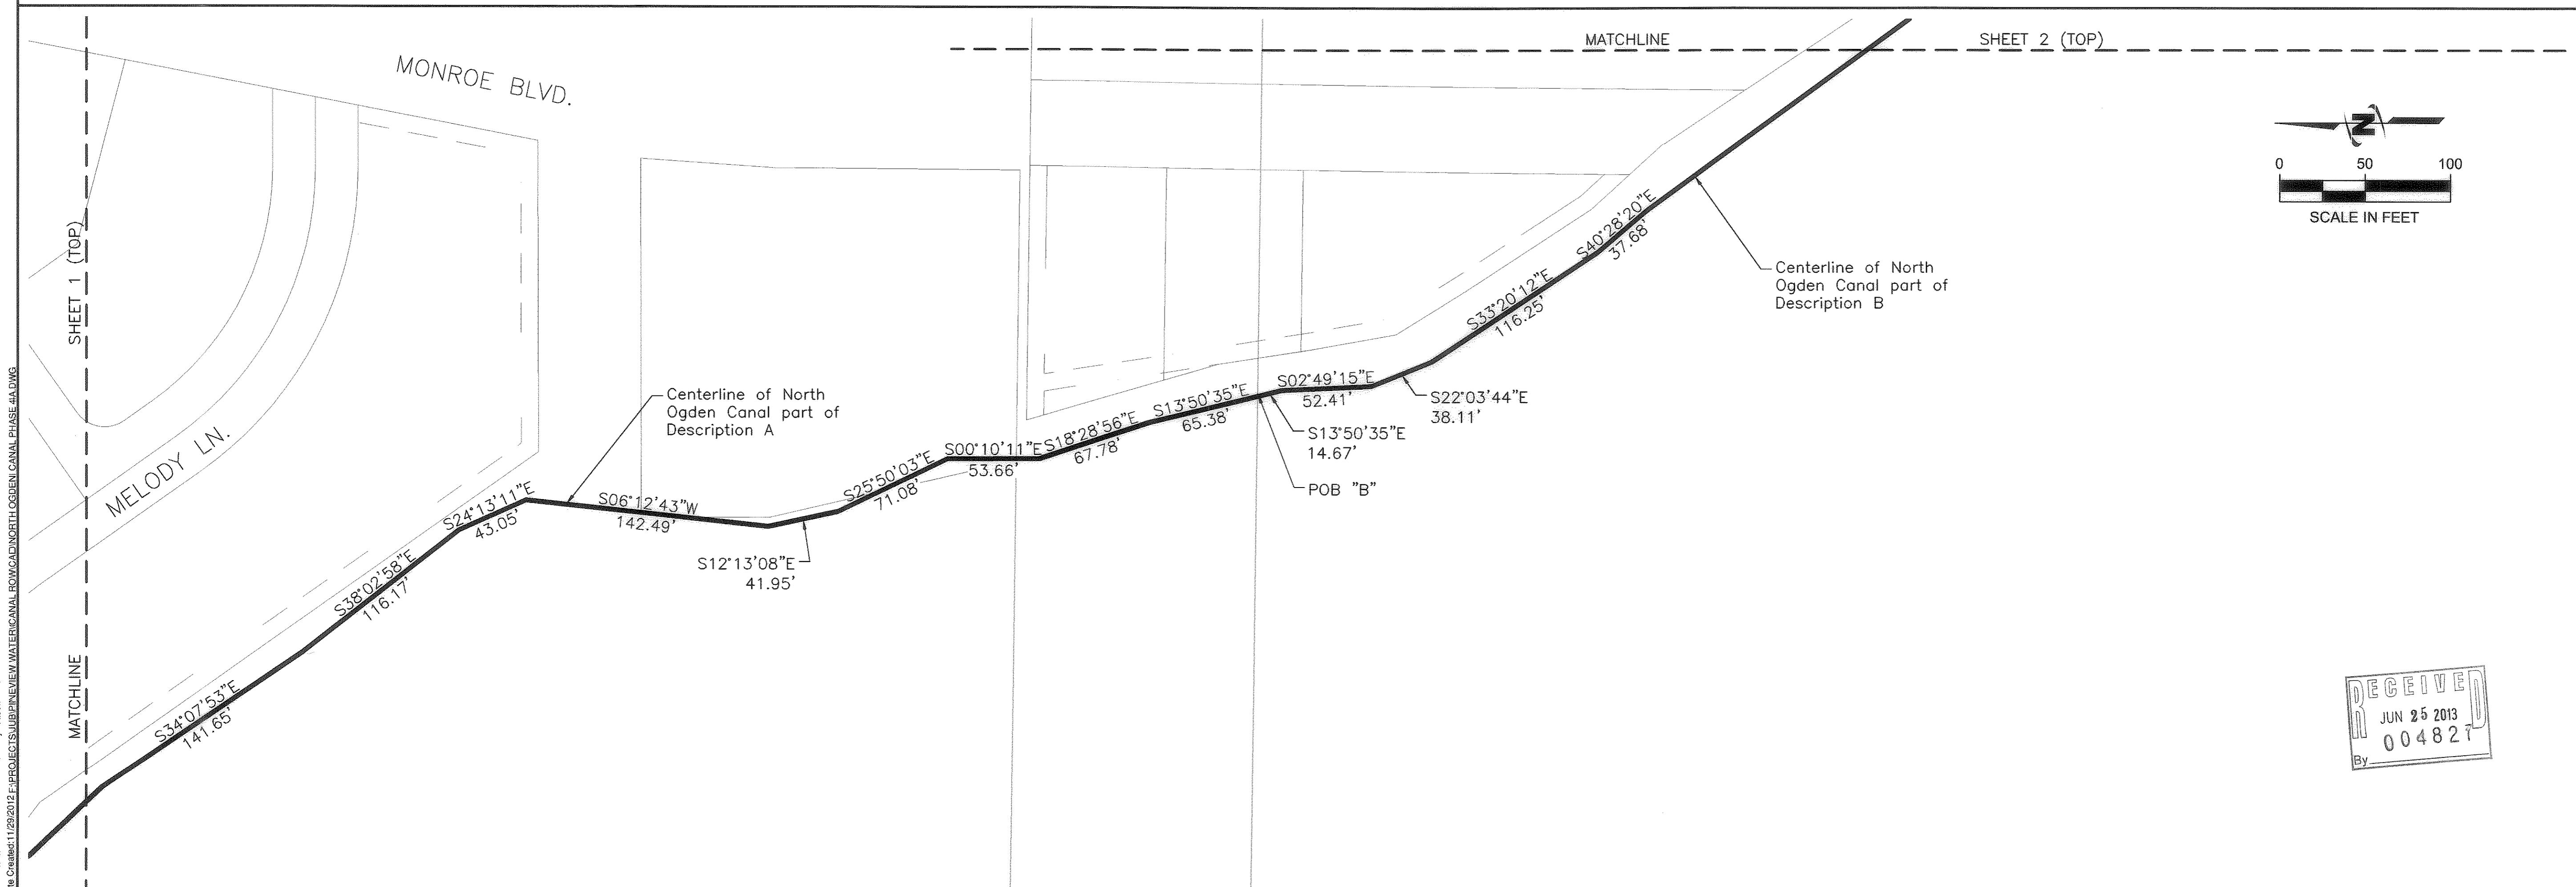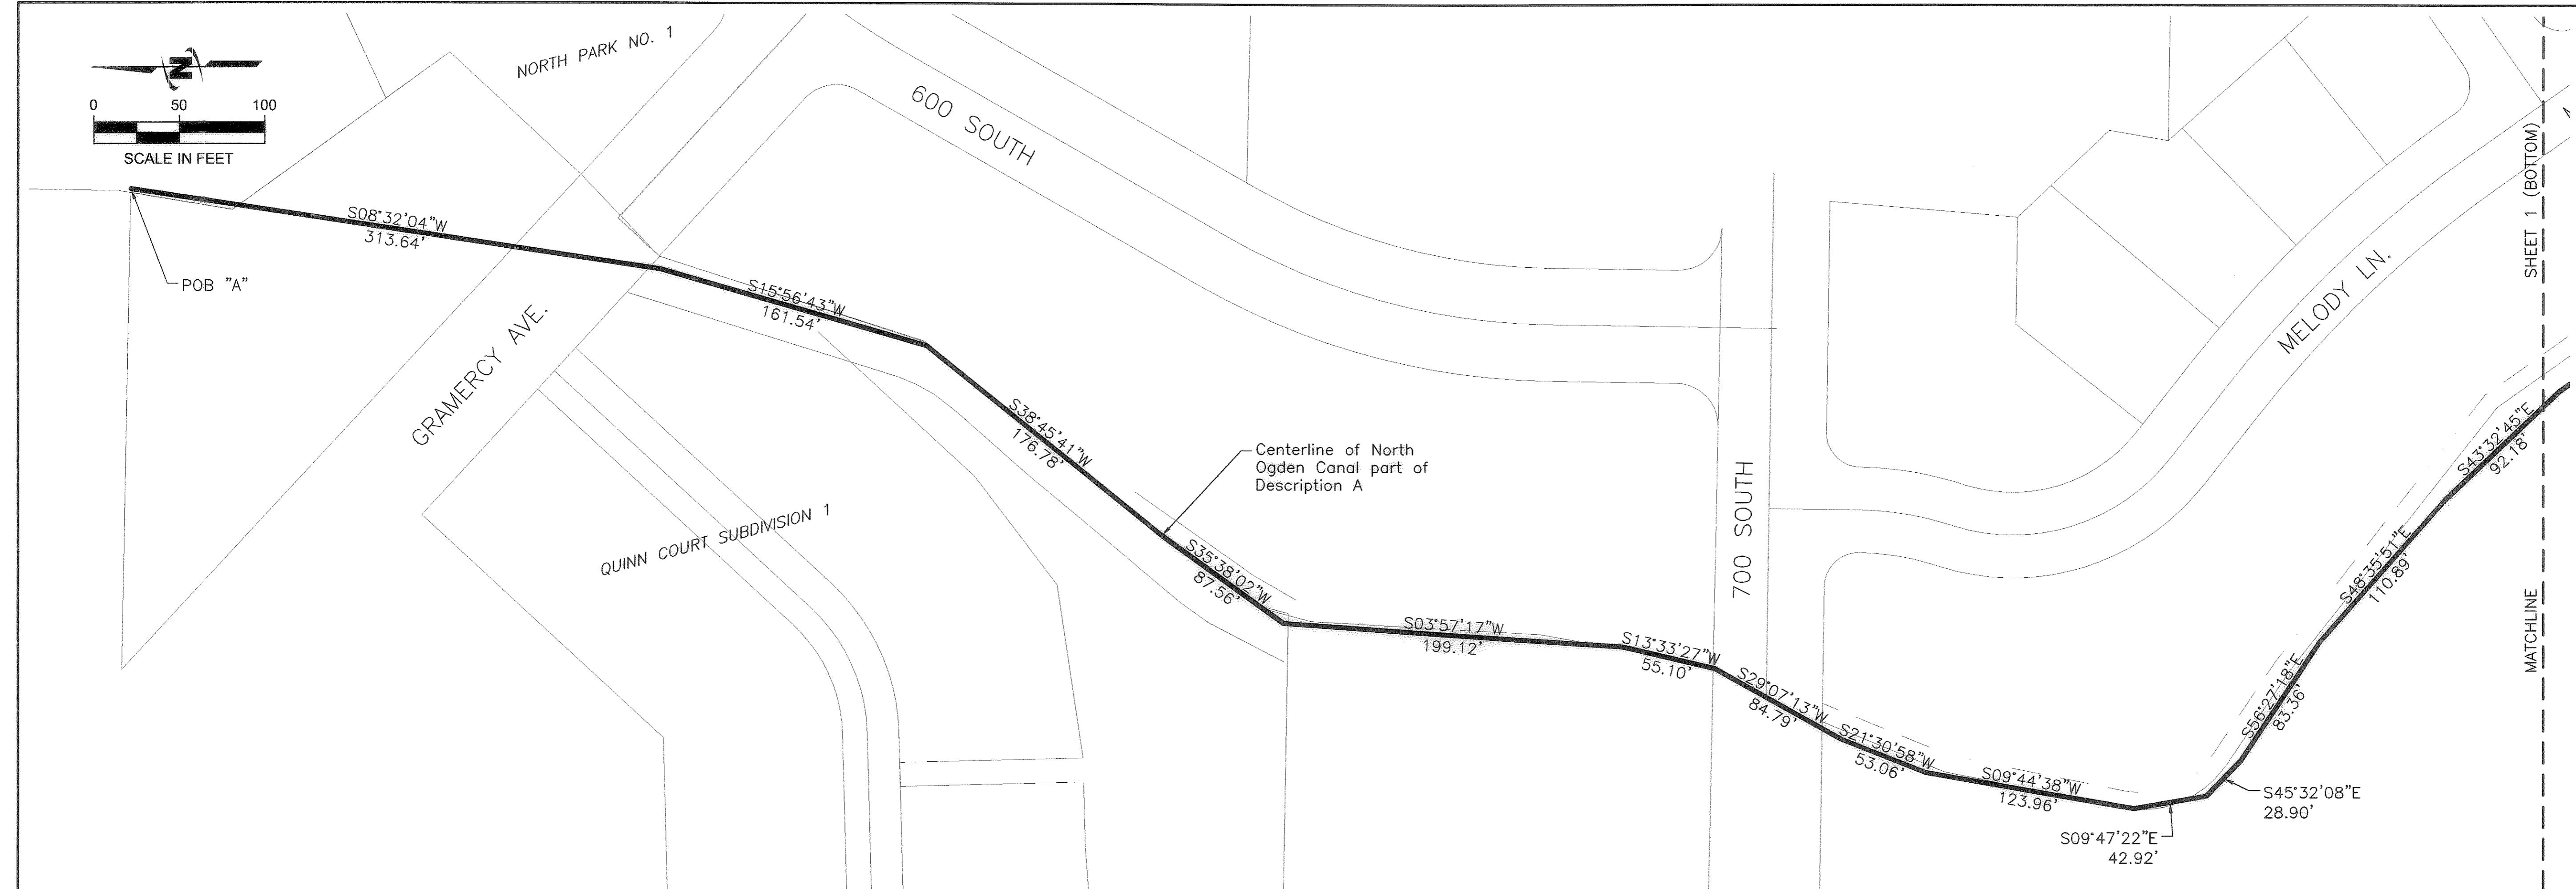


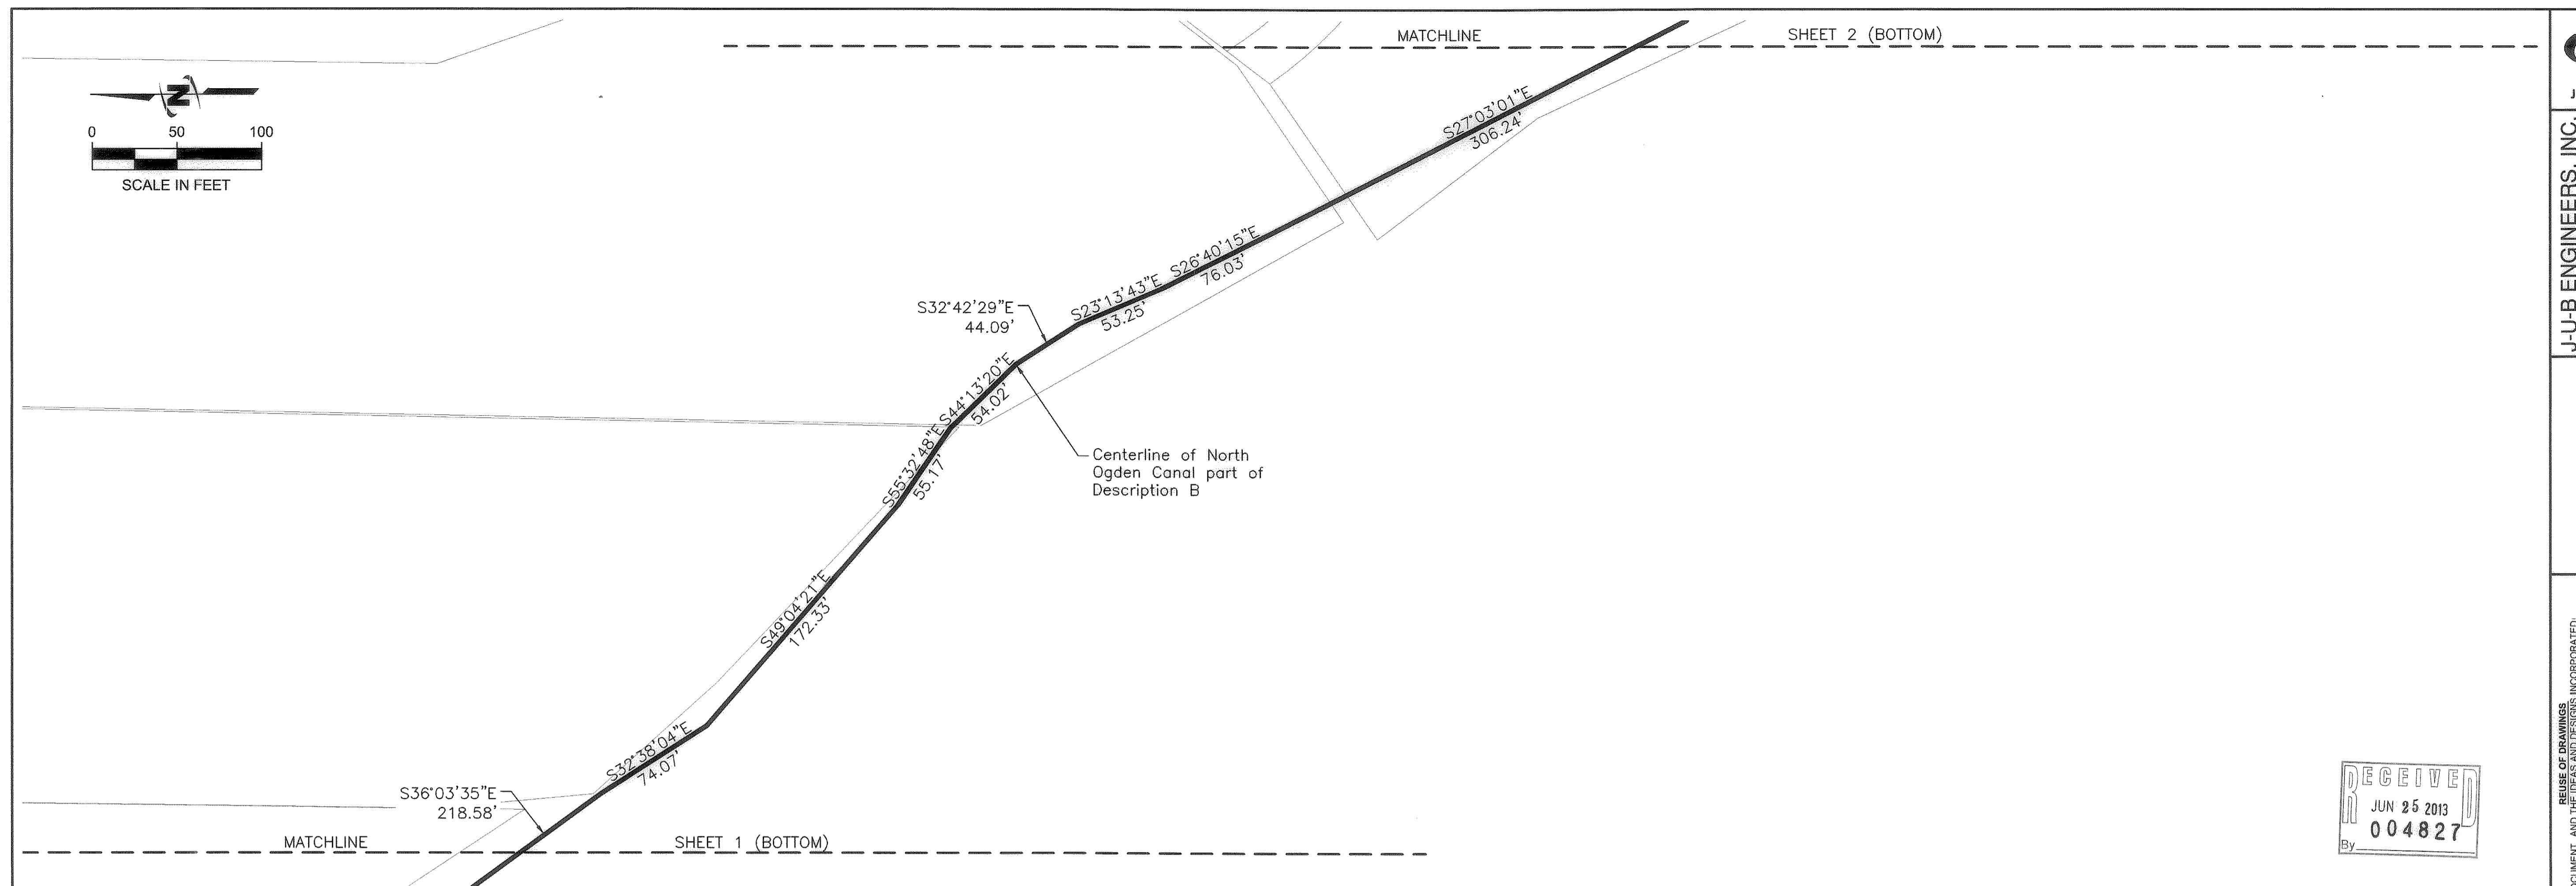

HARRISON BLVD.

SHEET 2 (TOP)

MATCHLINE

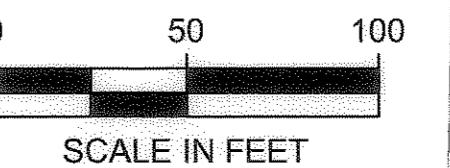

SCALE IN FEET

PEACH DR.

HENDERSON DR.

CUSTER AVE.

Centerline of North
Ogden Canal part of
Description C

S63°04'11"E
49.85'
N73°24'58"E N84°42'51"E
53.55' 57.99'
S78°14'20"E
26.74'

N79°09'11"E
150.57'
S81°09'38"E
80.57'
S62°53'32"E
13.56'
S64°14'57"E S62°55'58"E
54.05' 66.05'


41.48'
N68°00'22"W
165.17'
N54°01'29"W
115.23'
N43°37'30"W

Centerline of North
Ogden Canal part of
Description DLAURELWOOD
SUBDIVISION


MOUNTAIN RD.

MATCHLINE

SHEET 4 (TOP)

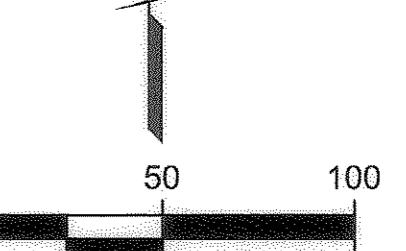

SCALE IN FEET

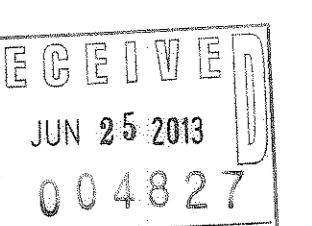
**NORTH OGDEN CANAL
NORTH OGDEN IRRIGATION COMPANY**
**PHASE 4
RIGHT-OF-WAY PLAT**

 RELEASE OF DRAWINGS
 THIS DOCUMENT, AND PICTURES AND DESIGNS INCORPORATED
 HEREIN AS AN INSTRUMENT OF PROFESSIONAL SERVICE, IS THE
 PROPERTY OF J-U-B ENGINEERS, INC. AND IS NOT TO BE USED
 WITHOUT AUTHORIZATION OF J-U-B ENGINEERS, INC.

REVISION

A/PPL DATE

NO. DESCRIPTION

FILE NUMBER

DRAWN BY

DESIGN BY

CHECKED BY

ONE INCH

AT FULL SIZE, IF NOT ONE
INCH, SCALE ACCORDINGLY

LAST UPDATED: 5/22/2013

SHEET NUMBER:

3

**NORTH OGDEN CANAL
NORTH OGDEN IRRIGATION COMPANY**

PHASE 4
RIGHT-OF-WAY PLAT

FILE : NORTH OGDEN CANAL-PHASE 4A.DWG
JUB PROJ. #: 55-07-060
DRAWN BY: DDS/JDM
DESIGN BY:
CHECKED BY: DDS
ONE INCH
AT FULL SIZE, IF NOT ONE
INCH SCALE ACCORDINGLY
LAST UPDATED: 5/22/2013
SHEET NUMBER:


4

REUSE OF DRAWINGS
THIS DOCUMENT AND THE IDEAS AND DESIGNS INCORPORATED
HEREIN AS AN INSTRUMENT OF PROFESSIONAL SERVICE IS THE
PROPERTY OF J-U-B ENGINEERS, INC. AND IS NOT TO BE USED IN
WHOLE OR PART FOR ANY OTHER PURPOSE WITHOUT THE EXPRESS
WRITTEN AUTHORIZATION OF J-U-B ENGINEERS, INC.
REVISION



J-U-B ENGINEERS, INC.
466 North 900 West
Kaysville, Utah 84037
Phone: 801.547.0393
Fax: 801.547.0397
www.jub.com

MATCHLINE SHEET 3 (BOTTOM)

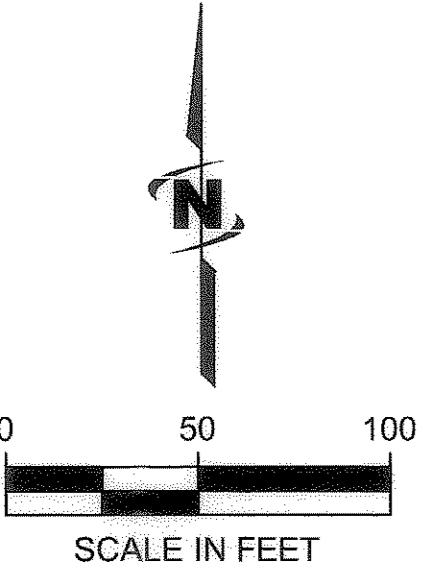

MOUNTAIN ROAD

WILD ROSE WAY


CALVERT
SUBDIVISION

TAYLOR AVE.

1350 S.

MATCHLINE SHEET 4 (BOTTOM)


MATCHLINE SHEET 4 (TOP)

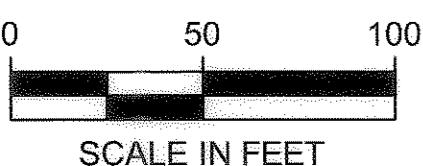N28°34'00"W
24.47'N40°02'38"W
30.31'N70°10'16"W
90.52'N55°10'30"W
67.67'N87°39'50"W
76.24'EL MONTE VISTA
SUBDIVISION UNIT ONECenterline of North
Ogden Canal part of
Description D

1375 S.

FILMORE
AVE.EL MONTE VISTA
SUBDIVISION UNIT
THREE

POB "D"

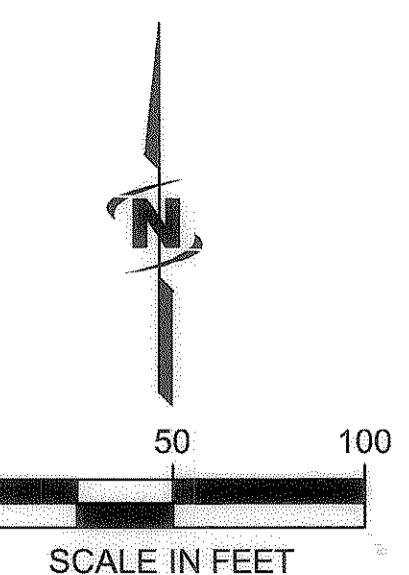
 Centerline of North
 Ogden Canal part of
 Description E

POB "E"

S74°02'48"E
452.64'N67°11'17"E
17.59'
 N52°31'04"E
127.38'
S77°37'34"E
176.83'
N68°31'50"E
30.16'S82°59'27"E
110.82'S60°14'24"E
222.58'S38°14'02"E
121.91'
 L=80.01'
 Δ =30°33'48"
 R=150.00'
 CB=S50°32'11"E
 CL=79.07'



MATCHLINE

SHEET 5 (BOTTOM)

RELEASER OF DRAWINGS
 THIS DOCUMENT AND THE STANDARDS, DESIGN, INCORPORATED
 HEREIN AS AN INSTRUMENT OF PROFESSIONAL SERVICE, IS THE
 PROPERTY OF J-U-B ENGINEERS, INC., AND IS NOT TO BE USED IN
 WHOLE OR PART, FOR ANY OTHER PROJECT WITHOUT THE EXPRESS
 WRITTEN AUTHORIZATION OF J-U-B ENGINEERS, INC.

REVISION	

 NORTH OGDEN CANAL
 NORTH OGDEN IRRIGATION COMPANY

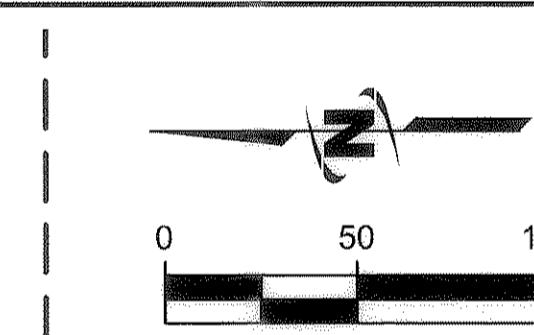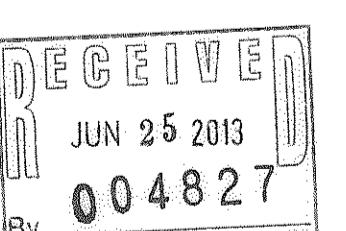 FILE: NORTH OGDEN CANAL PHASE 4A
 JUB PROJ. #: 55-07-060
 DRAWN BY: DDS/JDM
 DESIGN BY:
 CHECKED BY: DDS
 ONE INCH
 AT FULL SIZE; IF NOT ONE
 INCH SCALE ACCORDINGLY
 LAST UPDATED: 5/22/2013
 SHEET NUMBER:
5


SHEET 5 (TOP)

MATCHLINE

Centerline of North
 Ogden Canal part of
 Description ES35°15'17"E
75.27'S42°23'09"E
92.93'S47°10'44"E
112.83'
 S17°47'36"E
227.71'
S09°35'54"E
94.17'
S20°45'18"W
33.20'

 PHASE 4
 RIGHT-OF-WAY PLAT