

RECORDED  
 JUL 08 2013  
 004834

**LEGEND**


	Subject Property Line
	Property Line
	Adjoining Property Line
	Centerline
	Ditch
	Fence Line
	Section Corner
	Street Monument
	Found Survey Point
	Set 5/8"x24" Rebar With Cap

**SURVEYOR'S CERTIFICATE**

I, K. Greg Hansen, do hereby certify that I am a Registered Professional Land Surveyor in the State of Utah in accordance with Title 58, Chapter 22, Professional Engineers and Land Surveyors Act; and by the Authority of the Owners, I have Completed a Survey of the Property Described and shown Hereon this Plat in Accordance with Section 17-23-17 and have Verified all Measurements, and that the same has been Surveyed and Monuments have been Located and/or Placed on the Ground as Represented on the plat Hereon.

Signed this 26<sup>th</sup> day of April, 2013.

K. Greg Hansen PLS  
 Utah Land Surveyor License No. 167819

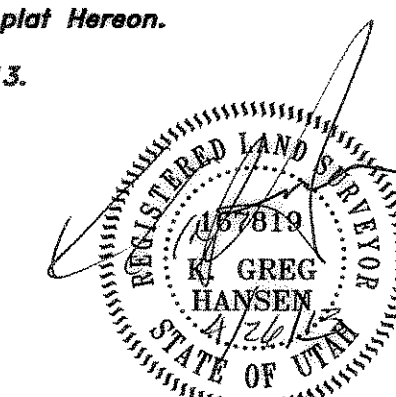

**Narrative**


The purpose of this survey was to establish and set the property corners of Lots 17R, 20R and 22R of "The Summit at Ski Lake No. 4" Subdivision as shown and described hereon. The survey was ordered by Mary Smith. The control used to establish the property corners was the existing Weber County Survey Monumentation surrounding Section 24, T6N, R1E, SLB&M. The basis of bearing is the North line of the Northwest Quarter of said Section which bears South 89°26'57" East per said subdivision plat, (South 89°36'46" East Weber County Grid Bearing) Utah North, State Plane, Calculated N.A.D.83 Bearing.

Drawn By: Keith	Date: 04/25/13
Designed By:	
Checked By:	
Approved By:	
Scale: 1" = 60'	
Drawing File: 13-3-58v12.dwg	
JOB NUMBER: 13-3-3-56	

Property Survey for  
**Marsha Smith**  
 6679 East, 6711 East and 6739 East Via Cortina Dr.  
 Huntsville, Weber County, Utah  
 A Part of the North Half of Section 24,  
 Township 6 North, Range 1 East, S.L.B.&M.

Sheet	1
of	1
Sheets	

**HANSEN & ASSOCIATES, INC.**  
 Consulting Engineers and Land Surveyors  
 538 North Main Street, Brigham, Utah 84302  
 Visit us at [www.hansen.net](http://www.hansen.net)  
 Ogden  
 Brigham City  
 (435) 389-4905 (801) 389-3461 (435) 732-8272

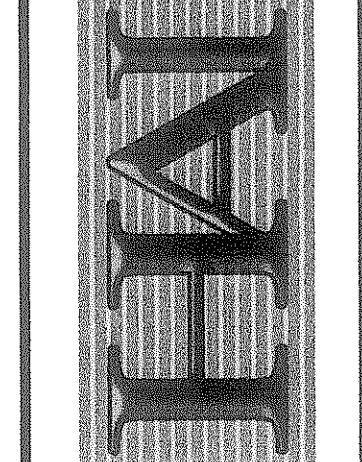

No.	Date	By	Revision