


OWNERSHIP OF DOCUMENTS: This document, and the ideas and designs incorporated herein, as a instrument of professional service, is the property of Ensign Engineering and Land Surveying, Inc. and is not to be used, in whole or in part, for any other project without the written authorization of Ensign Engineering and Land Surveying, Inc.

This drawing is the property of Ensign Engineering and Land Surveying, Inc. All rights to the design shown in the drawing including the right to protection thereof by patent or otherwise, are reserved by Ensign Engineering and Land Surveying, Inc. The drawing may not be copied or its contents made known or available to third parties without the prior written consent of Ensign Engineering and Land Surveying, Inc. It must be promptly returned to Ensign Engineering and Land Surveying, Inc. on request.

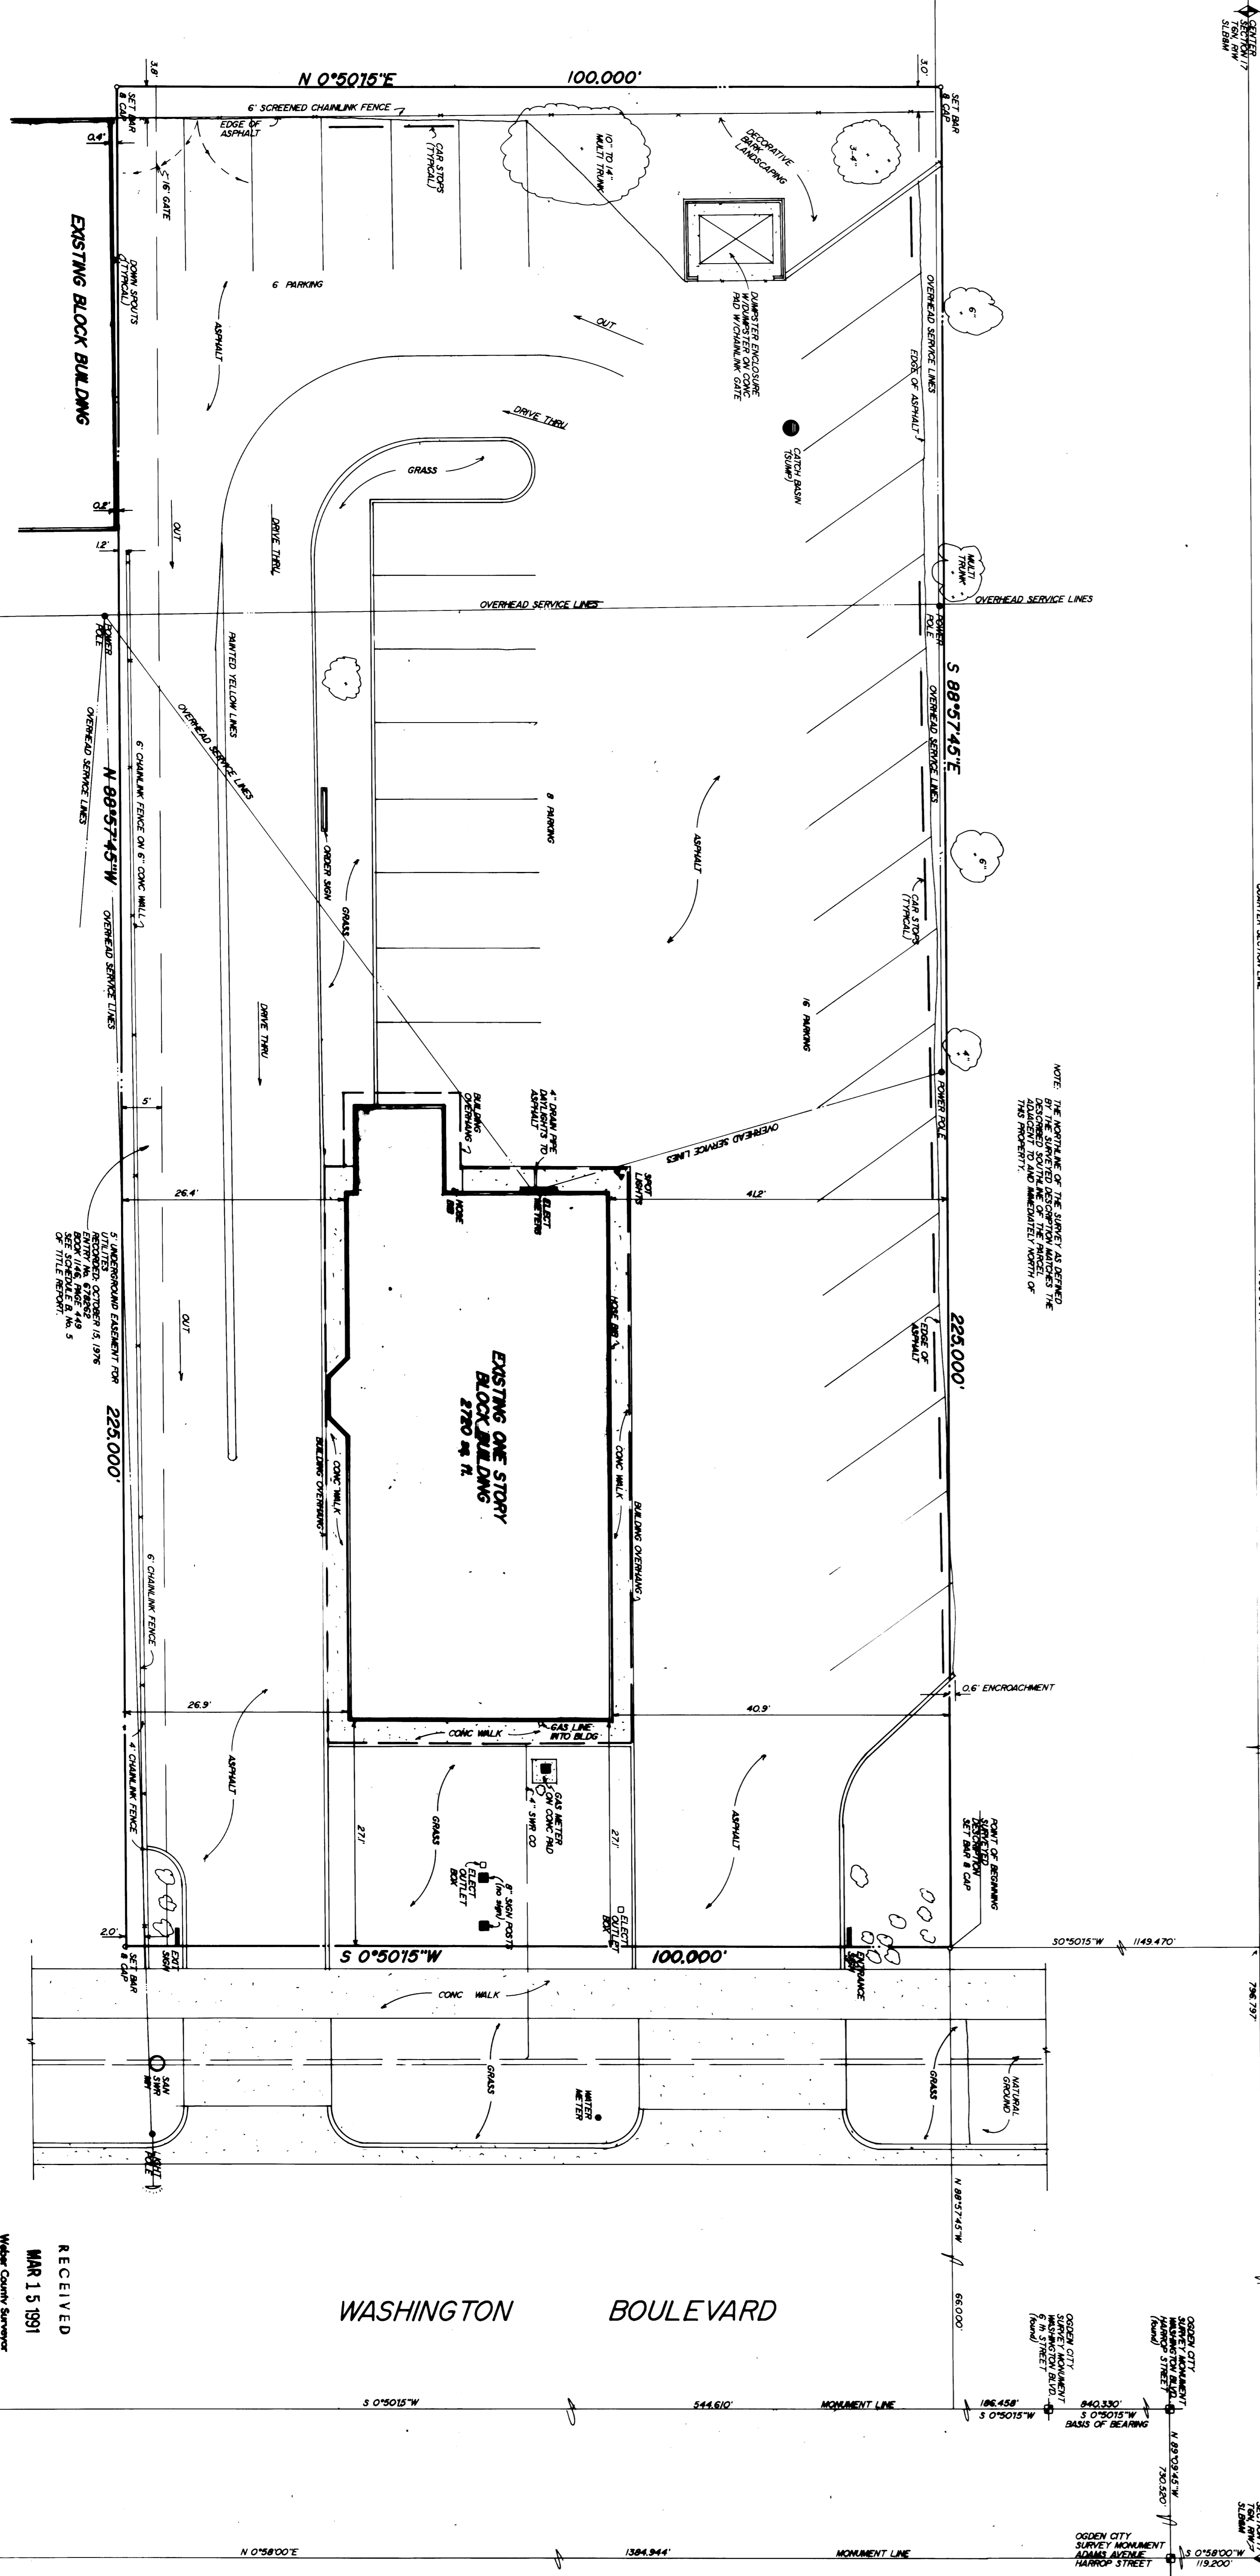

DEED DESCRIPTION

Part of the southeast Quarter of Section 17, Township 6 North, Range 1 West, Salt Lake Meridian, U.S. Survey; the Northeast corner of said quarter section and fronting thence WEST 225 feet, thence SOUTH 100 feet, thence EAST 225 feet, thence NORTH 100 feet to the place of beginning.

SHORVEED DESCRIPTION



Dec 13 / 1988

KEITH R. RUSSELL
REGISTERED LAND SURVEYOR
NO. 6260
STATE OF UTAH

NOTE: For conditions of record not shown herein as well as specific references to items in the title report please refer to the title report supplied by Landmark Title Company of Salt Lake City, Utah, under file No. 7020 and dated effective November 14, 1988.

SCALE: 1\"/>


LOCATED IN THE
SOUTHWEST QUARTER
SECTION 17
TOWNSHIP 6 NORTH, RANGE 1 WEST
SALT LAKE BASE & MERIDIAN

RECEIVED
MAR 15 1991

| | | | |
|--------------------|-------------------|----------|----|
| DESIGN | CHECK | | |
| DRAWN: VR CAMPBELL | CHECK: KR RUSSELL | | |
| SCALE: NOTED | JOB NO: 88-117 | | |
| NO. | DATE | REVISION | BY |
| | | | |

TITLE
ALTA/ACSM LAND TITLE SURVEY
H OBO JOE'S RESTAURANT PROPERTY
633 WASHINGTON AVENUE
OGDEN, UTAH
FOR
F.C. STANGL III

**ENSIGN ENGINEERING
AND
LAND SURVEYING**
4455 SOUTH 700 EAST SUITE 202 (801) 263-2455
MURRAY, UTAH 84107

SHEET
1
OF
1