


SURVEYORS CERTIFICATE

I, Larry M. Buttars, a registered Land Surveyor as prescribed by the laws of the State of Utah, and holding licence No. 2596, do hereby certify that I made a survey of the herein described property and the Plat hereon is a true and correct representation of said survey.

Date: 3-13-91 Sign: _____

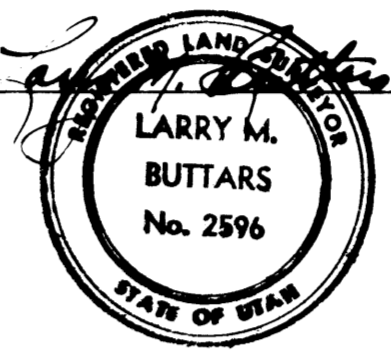

DESCRIPTION

Part of Lot 10, Block 1, Plat B, Huntsville Survey. Beginning at a point 121.20 ft. $S. 88^{\circ} 39' W.$ along the North line from the Northeast corner of said lot 10, and running thence $S. 88^{\circ} 39' W.$ along the South line of 600 South St. 146.17 ft., to a point 305.58 ft. East of the N.W. corner of said lot 10, thence $S. 3^{\circ} 01' E.$ 264.00 ft., thence $N. 88^{\circ} 39' E.$ 146.17 ft., thence $N. 3^{\circ} 01' W.$ 264.00 ft. to the point of beginning.

NARRATIVE

The purpose of this survey was to establish property corners for sale of property. Basis of bearings is East line of S.E. 1/4 of Section 18 as shown on the Huntsville Town-site map (N. $0^{\circ} 14' 29'' W.$). The N.E. cor. of lot 10 was located by using the official map of Huntsville R.L. survey of 1889, copied June 1910, revised and adopted Nov. 2, 1925. This survey was established from the S.E. corner of section 18 using bearings and distances as shown.

LEGEND

- Set $3/4" \times 24"$ re-bar with plastic cap stamped L. Buttars R.L.S. 2596
- Set P.K. nail with ribbon

RECEIVED

APR 2 1991

Weber County Surveyor

BUTTARS SURVEYING	
1815 26th STREET	OGDEN, UT. 84401
PHONE 392-5291	
CLIENT: BARLOW REALTY	
SURVEY LOCATION:	
PLAT 'B' HUNTSVILLE SURVEY	WEBER COUNTY, UTAH
SURVEY DATE: 3-9-91	