
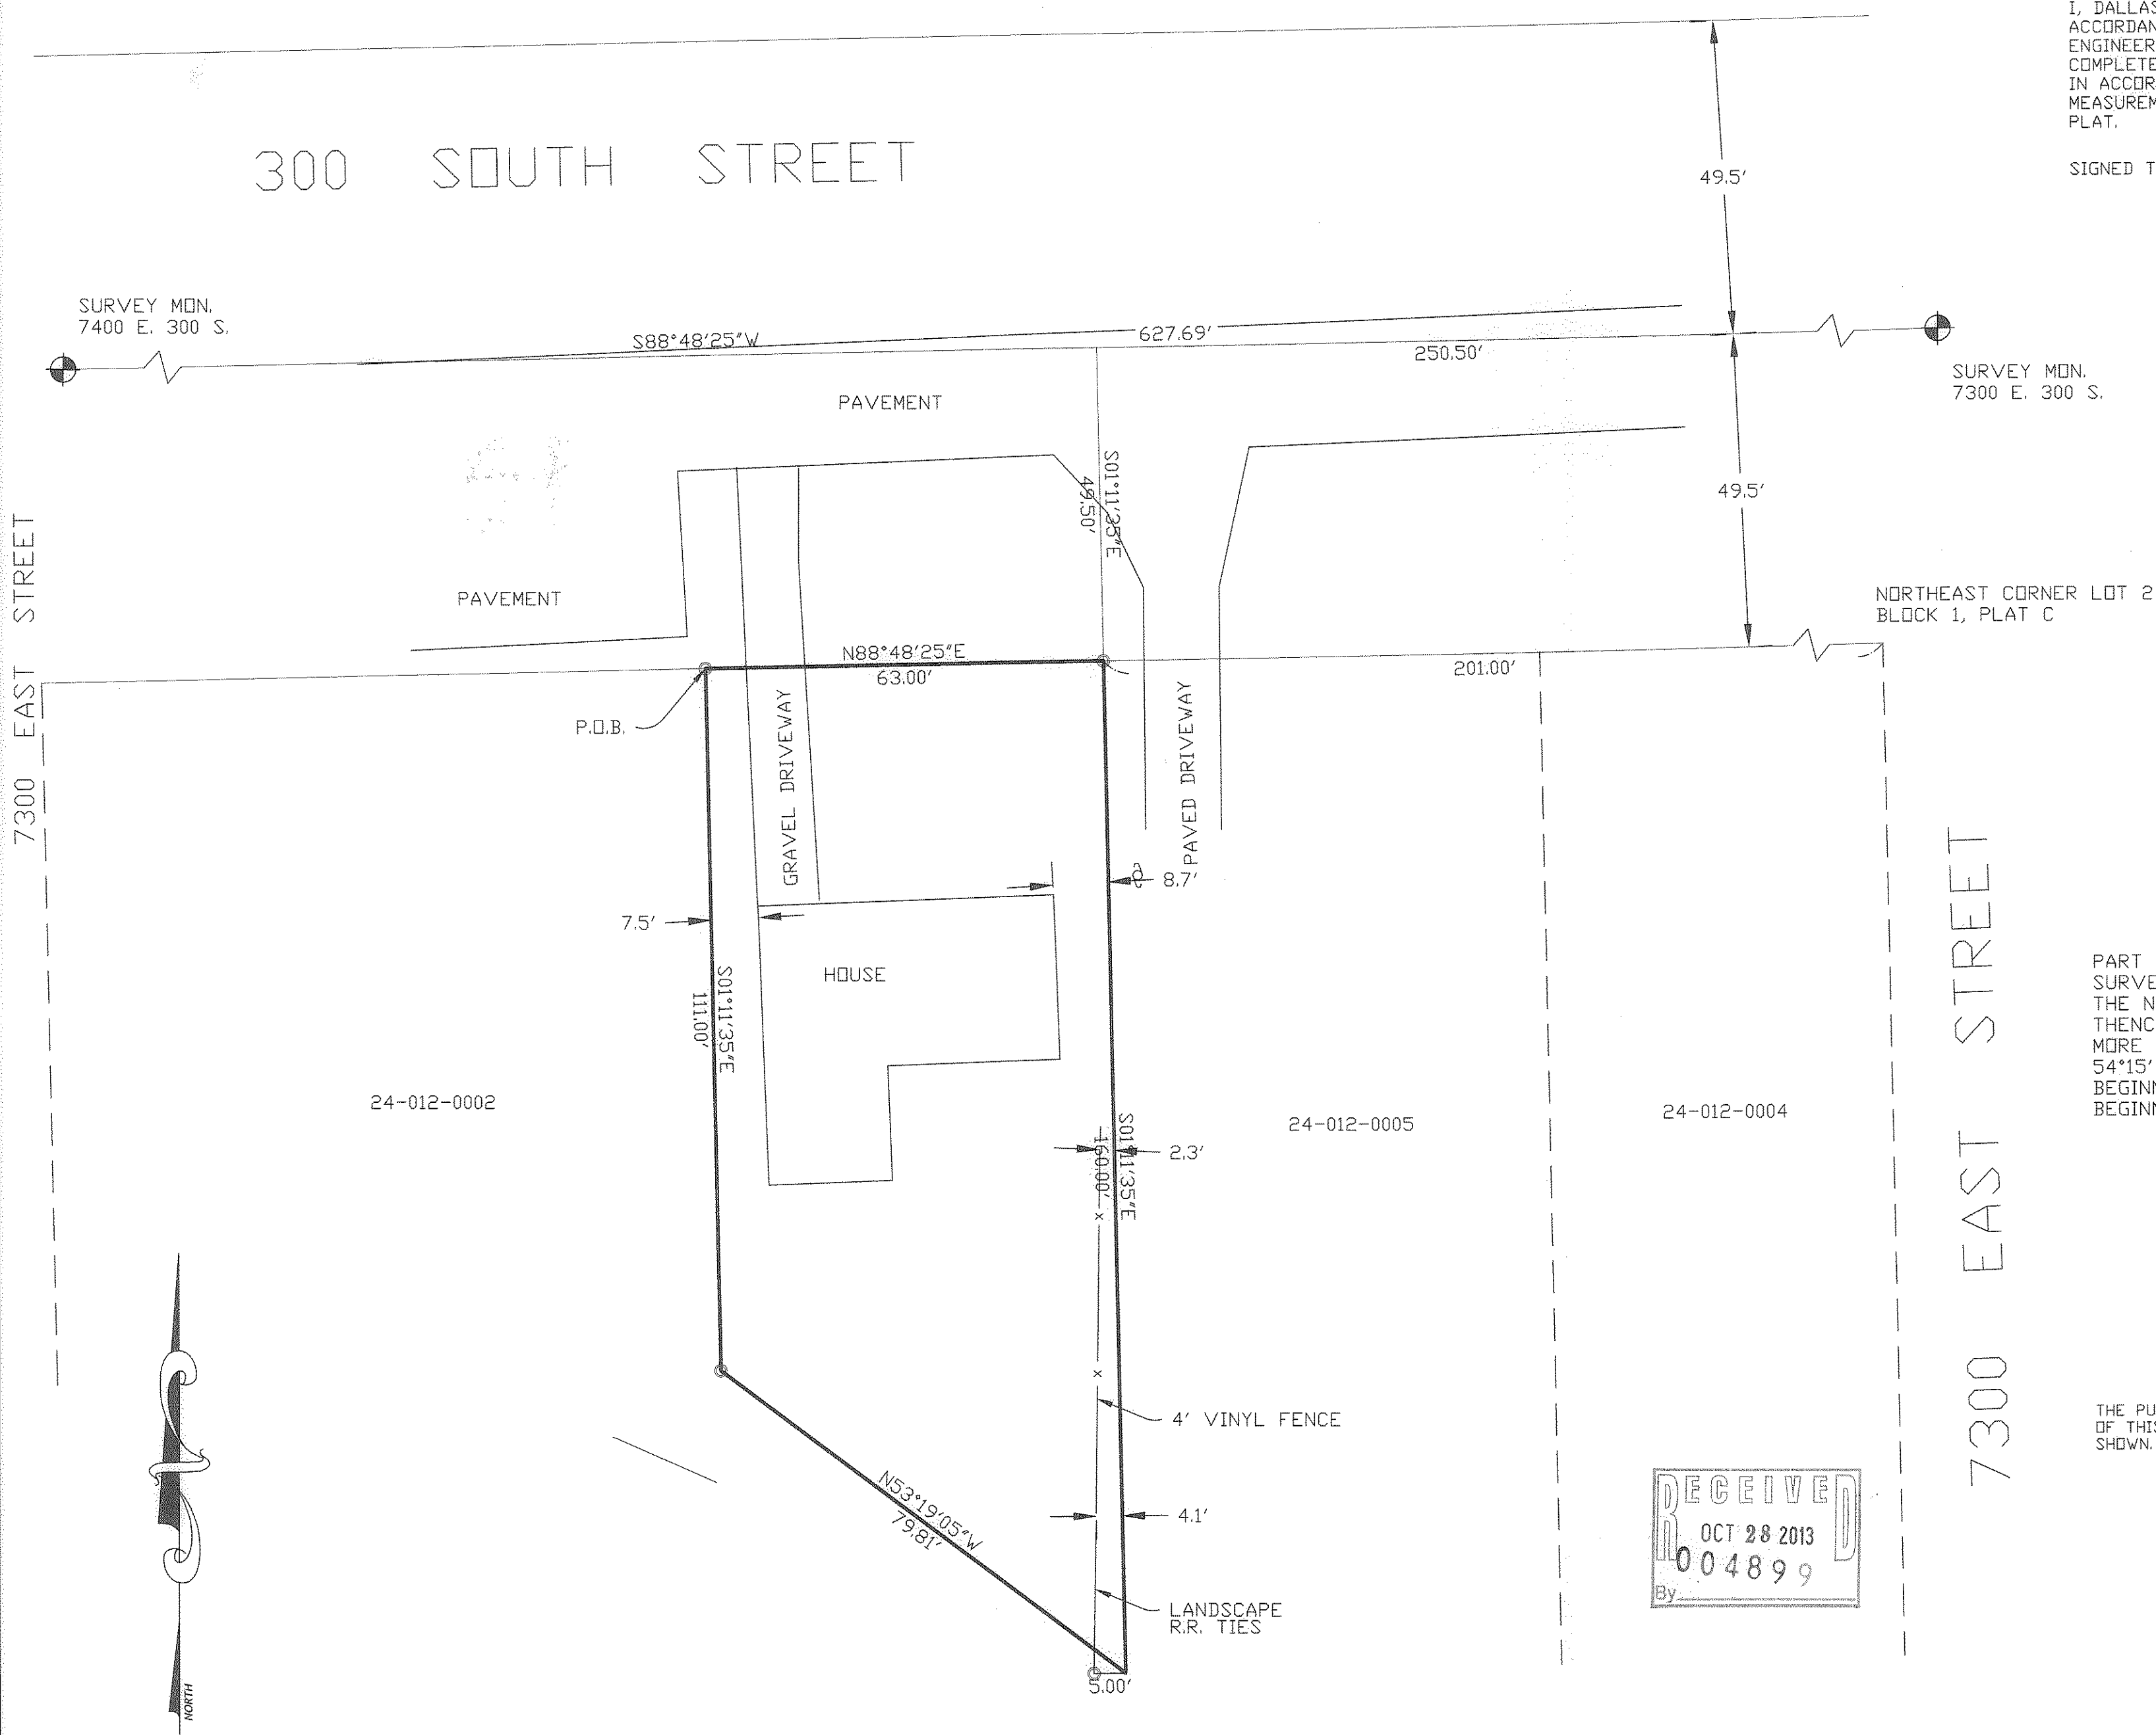


SURVEYOR'S CERTIFICATE

I, DALLAS K. BUTTARS, HOLDING LICENSE NUMBER 167594 IN ACCORDANCE WITH TITLE 58, CHAPTER 22, PROFESSIONAL ENGINEERS AND LAND SURVEYORS LICENSING ACT, HAVE COMPLETED A SURVEY OF THE PROPERTY DESCRIBED ON THE PLAT IN ACCORDANCE WITH SECTION 17-23-17 AND HAVE VERIFIED ALL MEASUREMENTS AND PLACED MONUMENTS AS REPRESENTED ON THE PLAT.

SIGNED THIS 16th DAY OF April 2012

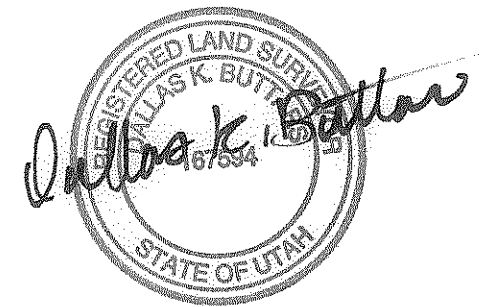

BOUNDARY DESCRIPTION

BOUNDARY DESCRIPTION

PART OF LOT 2, BLOCK 1 PLAT C, HUNTSVILLE SURVEY; BEGINNING AT A POINT 16 RODS WEST OF THE NORTHEAST CORNER OF SAID LOT 2; RUNNING THENCE EAST 63 FEET, THENCE SOUTH 160 FEET, MORE OR LESS, TO LAND OF U.S.A.; THENCE NORTH 54°15' WEST 75 FEET TO A POINT 111 FEET SOUTH OF BEGINNING; THENCE NORTH 111 FEET TO THE PLACE OF BEGINNING.

NARRATIVE

THE PURPOSE OF THIS SURVEY WAS TO ESTABLISH THE BOUNDARY OF THIS PARCEL, THE HUNTSVILLE TOWN MONUMENTS WERE USED AS SHOWN.



SCALE: 1" = 20'

○ = 5/8" x 24" LENGTH REBAR WITH CAP STAMPED 167594

U.S.A. 24-012-0003

**LANDMARK SURVEYING, INC.**  
 A COMPLETE LAND SURVEYING SERVICE  
 4646 S. 3500 W. #-3, WEST HAVEN, UTAH 84401  
 PHONE 801-731-4075

CLIENT: TOMMY CHRISTIE  
 LOCATION: LOT 2, BLOCK 1, PLAT C  
 HUNTSVILLE SURVEY  
 SURVEYED: 4-16-12

REVISIONS:	DRAWN BY: D.B.
	CHECKED BY: D.B.
	DATE: 4-16-12
	FILE: 3258RDFS