


SURVEYORS CERTIFICATE

I, Larry M. Buttars, a registered Land Surveyor as prescribed by the laws of the State of Utah, and holding License No. 2596, do hereby certify that I made a survey of the block described property in this plat in accordance with the conditions and representation of said survey.

Date 10-8-90 Sign: *Larry M. Buttars*

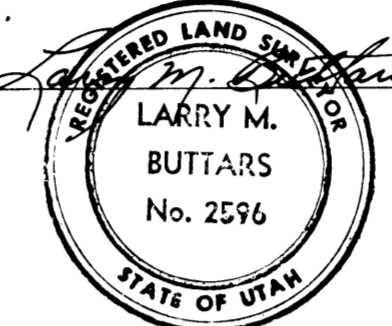

DESCRIPTION

All of Lots 1 thru 6, inclusive, Block G, Brummitts Addition to Ogden City, Weber County, Utah.

NARRATIVE

The purpose of this survey was to establish the North Property line for fencing.

Ogden City Engineering records were used for basis of bearings and Monumented Block dimensions.

LEGEND

- Set 3/4" x 24" re-bar with plastic cap, stamped L. Buttars R.L.S. 2596
- 5/8" P.K. nail with ribbon
- O.C.S. - Ogden City Survey records

BUTTARS SURVEYING	
1815 26 TH STREET	OGDEN, UT. 84401
PHONE 392-5291	
CLIENT: CHARLES G. GIBSON	
SURVEY LOCATION: BLK. G, BRUMMITTS ADD'N. OGDEN CITY	
SURVEY DATE: 10-6-90	

RECEIVED
APR 2 1991
Weber County Surveyor