

MURRAY FLAG LOT SUBDIVISION

A PART OF THE S. E. 1/4 OF SEC. 22 T. 6 N., R. 3W., S.L.B. & M.

WEBER COUNTY, UTAH

RECORD OF SURVEY

SURVEYORS CERTIFICATE

I DALLAS K. BUTTARS, HOLDING LICENSE NUMBER 167594 IN ACCORDANCE WITH TITLE 58, CHAPTER 22, PROFESSIONAL ENGINEERS AND LAND SURVEYORS LICENSING ACT, HAVE COMPLETED A SURVEY OF THE PROPERTY DESCRIBED ON THE PLAT IN ACCORDANCE WITH SECTION 17-23-17 AND HAVE VERIFIED ALL MEASUREMENTS AND PLACED MONUMENTS AS REPRESENTED ON THE PLAT.

I DO ALSO HEREBY CERTIFY THAT THIS PLAT OF MURRAY FLAG LOT SUBDIVISION IN WEBER COUNTY, UTAH, HAS BEEN CORRECTLY DRAWN TO SCALE AND IS A TRUE AND CORRECT REPRESENTATION OF THE FOLLOWING DESCRIPTION OF LANDS INCLUDED IN SAID SUBDIVISION, BASED ON DATA COMPILED FROM RECORDS IN THE WEBER COUNTY RECORDERS OFFICE, WEBER COUNTY SURVEYORS OFFICE AND OF A SURVEY MADE ON THE GROUND, AND I FURTHER CERTIFY THAT ALL LOTS MEET CURRENT LOT WIDTH AND AREA REQUIREMENTS FOR WEBER COUNTY ZONING.

P.L.S. # 167594 *Dallas K. Buttars* SIGNATURE DATE 01-30-14
 167604
 STATE OF UTAH

OWNERS DEDICATION

WE THE UNDERSIGNED OWNERS OF THE HEREIN DESCRIBED TRACT OF LAND, DO HEREBY SET APART AND SUBDIVIDE THE SAME INTO LOTS AND STREETS AS SHOWN HEREON AND NAME SAID TRACT MURRAY FLAG LOT SUBDIVISION. WE ALSO GRANT AND DEDICATE A PERPETUAL RIGHT AND EASEMENT OVER, UPON AND UNDER THE LANDS DESIGNATED HEREON AS PUBLIC UTILITY, STORM WATER DETENTION POND, DRAINAGE EASEMENTS, THE SAME TO BE USED FOR THE INSTALLATION, MAINTENANCE AND OPERATION OF PUBLIC UTILITY SERVICE LINE, STORM DRAINAGE FACILITIES OR FOR THE PERPETUAL PRESERVATION OF WATER CHANNELS IN THEIR NATURAL STATE WHICHEVER IS APPLICABLE AS MAY BE AUTHORIZED BY THE GOVERNING AUTHORITY, WITH NO BUILDINGS OR STRUCTURES BEING ERRECTED WITHIN SUCH EASEMENTS.

SIGNED THIS _____ DAY OF _____ 20__

KEVIN MURRAY



ACKNOWLEDGMENT

STATE OF UTAH COUNTY OF WEBER)
 ON THIS _____ DAY OF _____ 20__, PERSONALLY APPEARED BEFORE ME, THE UNDERSIGNED NOTARY PUBLIC, THE SIGNERS OF THE ABOVE OWNERS DEDICATION, IN NUMBER, WHO DULY ACKNOWLEDGED TO ME THAT THEY SIGNED IT FREELY AND VOLUNTARILY AND FOR THE PURPOSES THEREIN MENTIONED.

COMMISSION EXPIRES _____ NOTARY PUBLIC

BOUNDARY DESCRIPTION

PART OF THE SOUTHEAST QUARTER OF SECTION 22, TOWNSHIP 6 NORTH, RANGE 3 WEST, SALT LAKE BASE & MERIDIAN, U.S. SURVEY, DESCRIBED AS FOLLOWS:
 BEGINNING AT A POINT WHICH LIES SOUTH 0°42'22" WEST ALONG THE SECTION LINE 1182.36 FEET FROM THE EAST QUARTER CORNER OF SAID SECTION 22, AND RUNNING THENCE SOUTH 0°42'22" WEST ALONG THE SECTION LINE 30.00 FEET; THENCE NORTH 89°17'38" WEST 995.71 FEET; THENCE NORTH 0°42'22" EAST 549.79 FEET TO AN EXISTING FENCE LINE; THENCE ALONG SAID FENCE LINE SOUTH 89°17'38" EAST 206.58 FEET; THENCE SOUTH 0°42'22" WEST 159.56 FEET; THENCE SOUTH 88°25'09" EAST 165.81 FEET; THENCE ALONG SAID SUBDIVISION THE FOLLOWING TWO COURSES: SOUTH 0°42'22" WEST 357.70 FEET AND NORTH 89°17'38" WEST 623.34 FEET TO THE POINT OF BEGINNING.
 CONTAINS 196,762 S.F. OR 4.517 ACRES

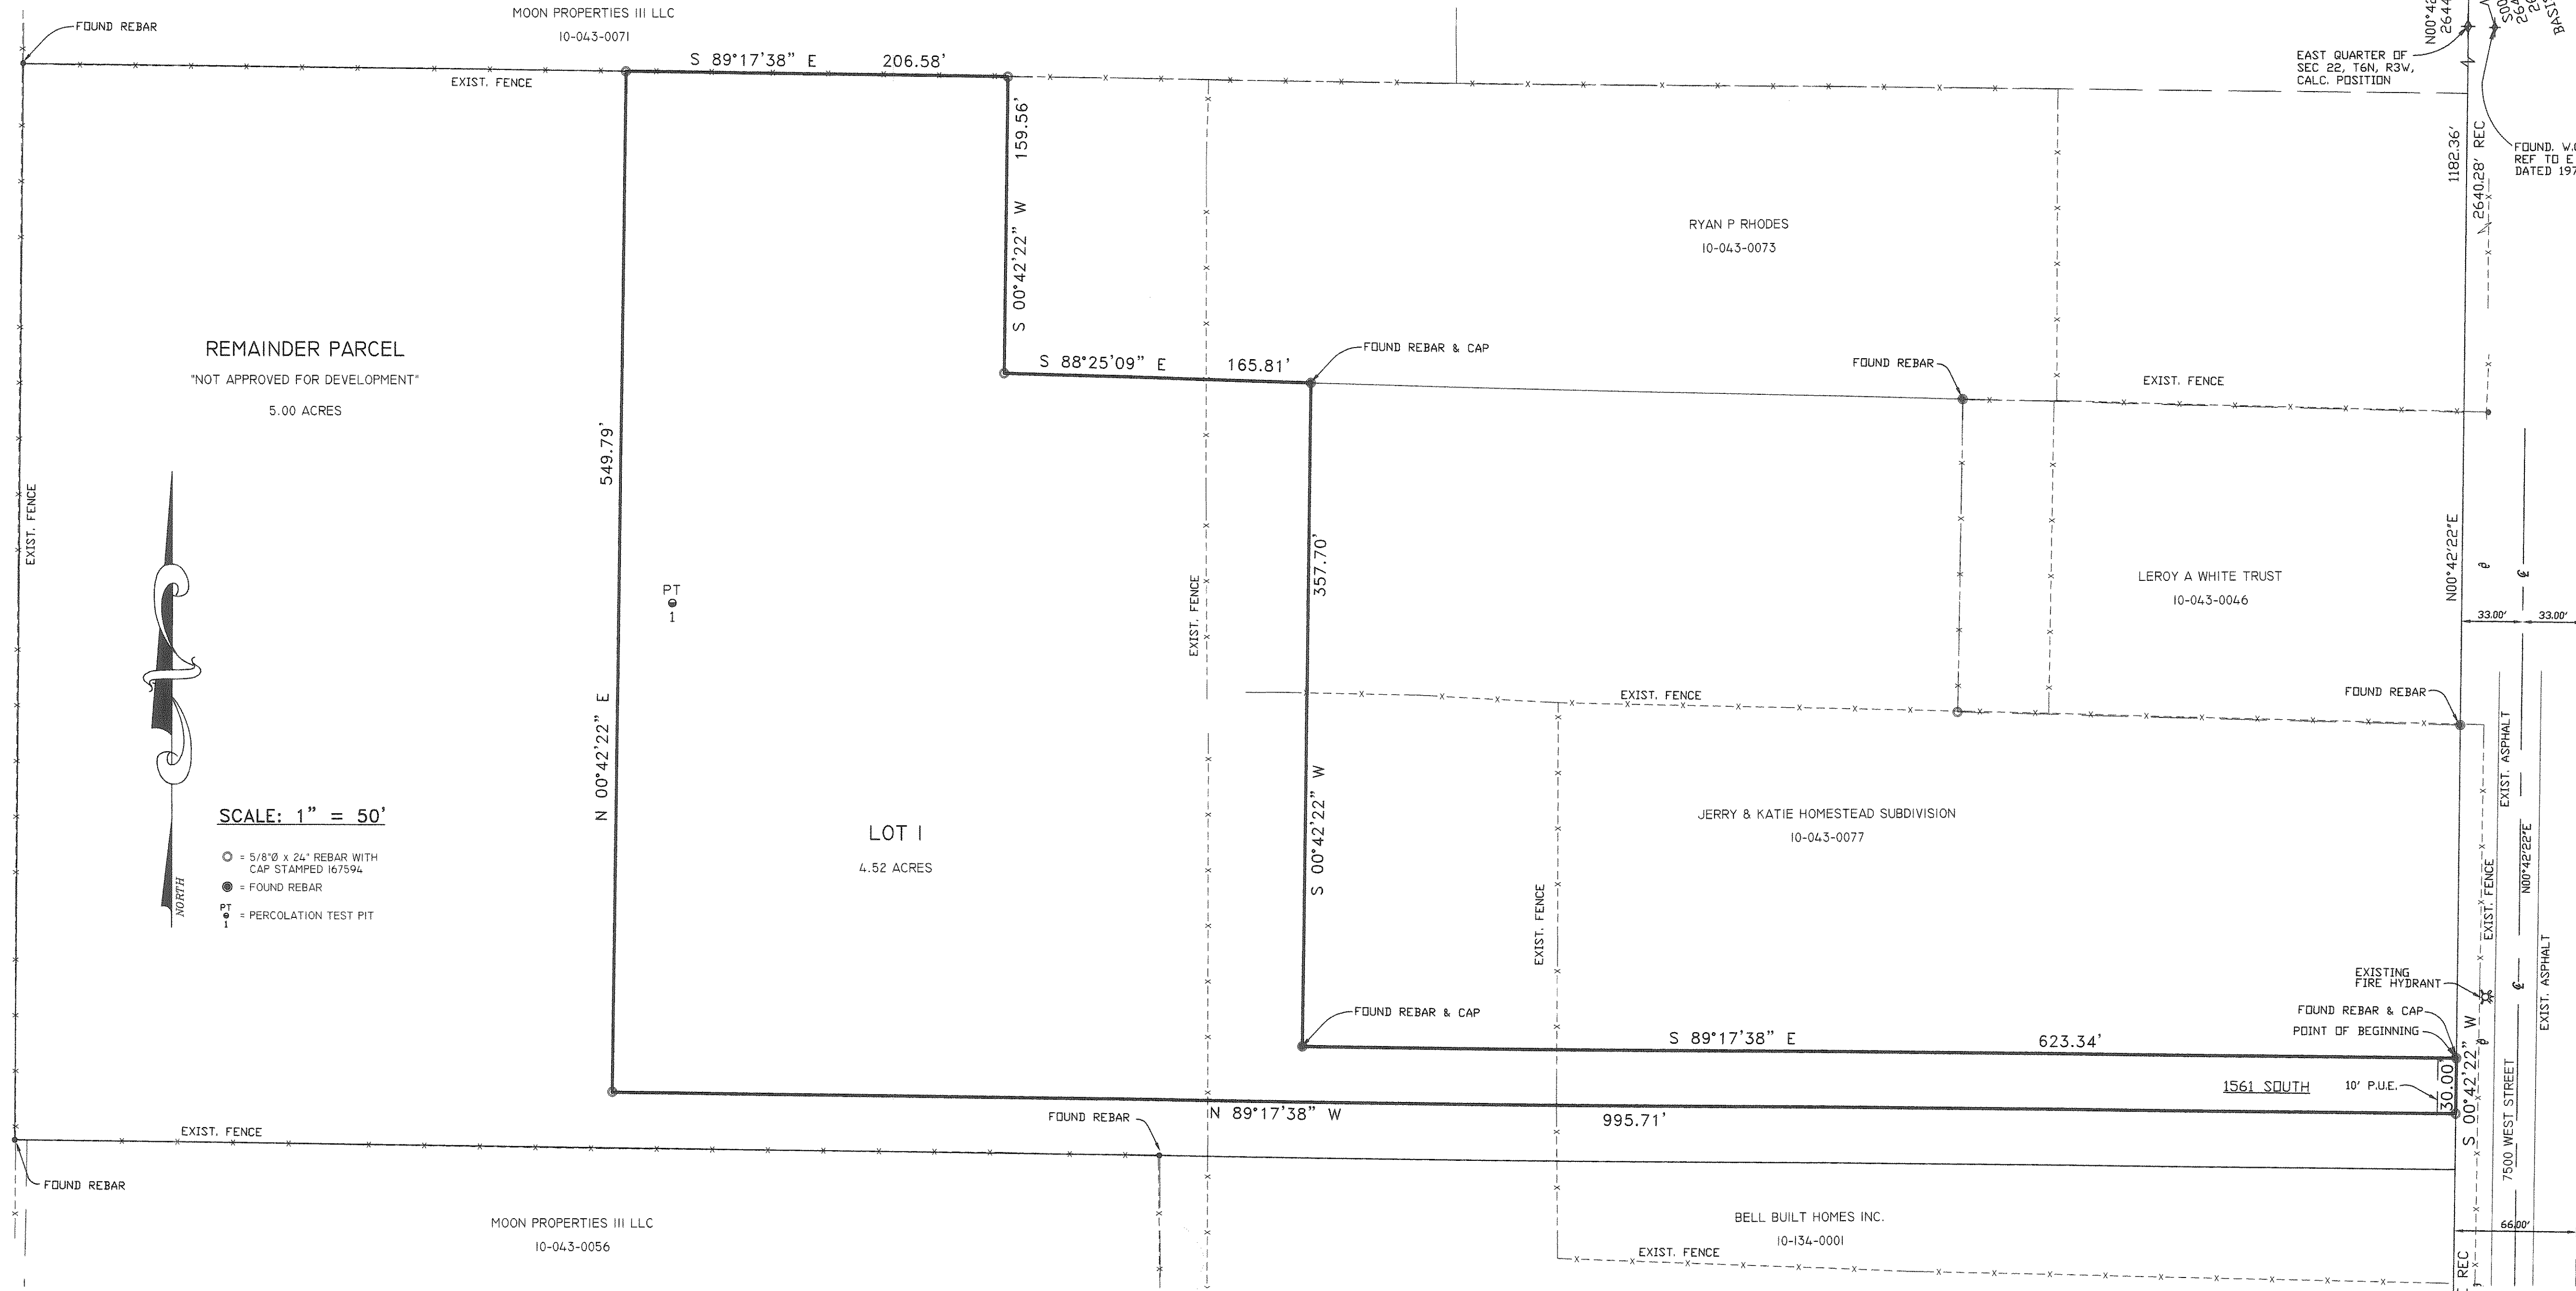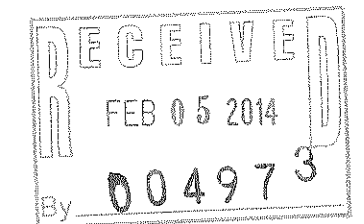

SCALE: 1" = 50'

- = 5/8" x 24" REBAR WITH CAP STAMPED 167594
- = FOUND REBAR
- PT 1 = PERCOLATION TEST PIT

NARRATIVE

THE PURPOSE OF THIS SURVEY WAS TO CREATE AN APPROVED WEBER COUNTY FLAG LOT SUBDIVISION FROM AN EXISTING DEEDED PARCEL.

THE ORIGINAL DESCRIPTION CONTAINS ONE LARGE PARCEL WITH FIVE SEPARATE LESS AND EXCEPTING DESCRIPTIONS. THE RIGHT OF WAY OF 7500 WEST WAS DETERMINED FROM OTHER FILED SURVEYS ALONG THE ROAD FROM 1989 BY CLS AND 2011 BY REVEE AND ASSOCIATES, THE 1/16 SECTION LINE, WHICH REFERENCES ALONG A FENCE LINE, REFERRED TO IN THE ORIGINAL DESCRIPTION WAS DETERMINED TO BE 6.68' TO THE WEST OF THE ORIGINAL DESCRIPTION ON THE SOUTH SIDE OF THE REMAINDER PARCEL AND 3.57' TO THE WEST ON THE NORTH SIDE. THIS WAS VERIFIED ON THE GROUND BY TWO FOUND REBARS IN THE FENCE LINE WHICH WERE HELD AS THE CORNERS TO THE REMAINDER PARCEL.

BASEIS OF BEARING IS AS SHOWN BETWEEN THE NORTHEAST CORNER AND THE EAST 1/4 CORNER REFERENCE MONUMENT AND IS STATE PLANE GRID BEARING AS PUBLISHED BY WEBER COUNTY SURVEYOR.

PERC TABLE

PERC TEST HOLE NO.	DEPTH, IN.	SOILS EVALUATION #13889, WEBER-MORGAN HEALTH DEPARTMENT
NO. 1	79"	0-12" LOAM, MASSIVE STRUCTURE, (ORGANICS)
		12-34" SANDY CLAY LOAM, MASSIVE STRUCTURE
		34-67" SILTY CLAY LOAM, MASSIVE STRUCTURE
		67-84" LOAMY SAND, MASSIVE STRUCTURE
		84-95" SILTY LOAM, MASSIVE STRUCTURE
		95-99" LOAMY SAND, MASSIVE STRUCTURE
		99-79" SILTY LOAM, MASSIVE STRUCTURE

AGRICULTURAL NOTE

AGRICULTURE IS THE PREFERRED USE IN THE AGRICULTURE ZONES. AGRICULTURE OPERATIONS AS SPECIFIED IN THE ZONING ORDINANCE FOR A PARTICULAR ZONE ARE PERMITTED AT ANY TIME INCLUDING THE OPERATION OF FARM MACHINERY AND ALLOWED AGRICULTURE USE SHALL BE SUBJECT TO RESTRICTION ON THE BASIS THAT IT INTERFERES WITH ACTIVITIES OF FUTURE RESIDENTS OF THIS SUBDIVISION.

~~WEBER-MORGAN HEALTH DEPARTMENT
 I HEREBY CERTIFY THAT THE SOILS, PERCOLATION RATES, AND SITE CONDITIONS FOR THIS SUBDIVISION HAVE BEEN INVESTIGATED BY THIS OFFICE AND ARE APPROVED FOR ON-SITE WASTEWATER DISPOSAL SYSTEMS.
 SIGNED THIS _____ DAY OF _____ 20__
 DIRECTOR, WEBER-MORGAN HEALTH DEPARTMENT.~~

~~WEBER COUNTY PLANNING COMMISSION APPROVAL
 THIS IS TO CERTIFY THAT THIS SUBDIVISION PLAT WAS DULY APPROVED BY THE WEBER COUNTY PLANNING COMMISSION ON THE _____ DAY OF _____ 20__
 SIGNATURE _____~~

~~WEBER COUNTY ENGINEER
 I HEREBY CERTIFY THAT THE REQUIRED PUBLIC IMPROVEMENT STANDARDS AND DRAWINGS FOR THIS SUBDIVISION CONFORM WITH COUNTY STANDARDS AND THE ANNUAL FINANCIAL GUARANTEE IS SUFFICIENT FOR THE INSTALLATION OF THESE IMPROVEMENTS.
 SIGNED THIS _____ DAY OF _____ 20__
 SIGNATURE _____~~

WEBER COUNTY SURVEYOR
 I HEREBY CERTIFY THAT THE WEBER COUNTY SURVEYOR'S OFFICE HAS REVIEWED THIS PLAT FOR MATHEMATICAL CORRECTNESS, SECTION CORNER DATA, AND FOR HARMONY WITH OTHER SURVEYS ON RECORD IN COUNTY OFFICES. THE APPROVAL OF THIS PLAT BY THE WEBER COUNTY SURVEYOR DOES NOT RELIEVE THE LICENSED LAND SURVEYOR WHO EXECUTED THIS PLAT FROM THE RESPONSIBILITIES AND LIABILITIES ASSOCIATED THEREWITH.
 SIGNED THIS _____ DAY OF _____ 20__
 SIGNATURE _____

~~WEBER COUNTY ATTORNEY
 I HAVE EXAMINED THE FINANCIAL GUARANTEE AND OTHER DOCUMENTS ASSOCIATED WITH THIS SUBDIVISION PLAT AND IN MY OPINION THEY CONFORM WITH THE COUNTY ORDINANCE APPLICABLE THEREIN AND NOW IN FORCE AND AFFECT.
 SIGNED THIS _____ DAY OF _____ 20__
 SIGNATURE _____~~

~~WEBER COUNTY COMMISSION ACCEPTANCE
 THIS IS TO CERTIFY THAT THIS SUBDIVISION PLAT, THE DEDICATION OF STREETS AND OTHER PUBLIC WORKS AND FINANCIAL GUARANTEE OF PUBLIC IMPROVEMENTS ASSOCIATED WITH THIS SUBDIVISION, THEREIN ARE HEREBY APPROVED AND ACCEPTED BY THE COMMISSIONERS OF WEBER COUNTY, UTAH THIS _____ DAY OF _____ 20__.
 TITLE CHAIRMAN, WEBER COUNTY COMMISSION
 ATTEST: _____~~

 LANDMARK SURVEYING, INC. A COMPLETE LAND SURVEYING SERVICE 4646 S. 3500 W. BA-3, WEST HAVEN, UTAH 84401 PHONE 801-731-4075 FAX 801-731-8906	WEBER COUNTY RECORDER ENTRY # _____ FEE _____ FILED FOR RECORD & RECORDED THIS _____ DAY OF _____ 20__ AT _____ IN BOOK _____ OF _____ PAGE _____ WEBER COUNTY RECORDER BY _____ DEPUTY
	CLIENT: KEVIN MURRAY LOCATION: SE 1/4 SEC 22 T.6N., R.3W., S.L.B.&M. SURVEYED: APRIL 2013 REVISIONS: _____ DRAWN BY: TDK CHECKED BY: DKB DATE: 01-30-14 FILE: 3329