

SILVER BELL ESTATES NO. 2 FIRST AMENDMENT


PART OF THE SOUTHEAST QUARTER OF SECTION 32,
TOWNSHIP 7 NORTH, RANGE 1 EAST
SALT LAKE BASE AND MERIDIAN
WEBER COUNTY, UTAH
DEC. 2013

NORTHEAST CORNER OF SECTION 32,
T7N, R1E, SLB&M,
WEBER COUNTY 3" BRASS CAP
DATED 1987
GOOD CONDITION

Surveyor's Certificate

I TED E. MASON, A REGISTERED LAND SURVEYOR IN THE STATE OF UTAH, IN ACCORDANCE WITH TITLE 58, CHAPTER 22, PROFESSIONAL ENGINEERS AND LAND SURVEYORS ACT; AND THAT I HAVE COMPLETED A SURVEY OF THE PROPERTY DESCRIBED ON THIS PLAT IN ACCORDANCE WITH SECTION 17-23-17, AND HAVE VERIFIED ALL MEASUREMENTS AND HAVE PLACED MONUMENTS AS REPRESENTED ON THIS PLAT; AND THAT THIS PLAT OF SILVER BELL ESTATES PHASE NO. 2, FIRST AMENDMENT, IN WEBER COUNTY, UTAH HAS BEEN CORRECTLY DRAWN TO THE DESIGNATED SCALE, AND IS A TRUE AND CORRECT REPRESENTATION OF THE FOLLOWING DESCRIPTION OF LANDS INCLUDED IN SAID SUBDIVISION, BASED ON DATA COMPILED FROM RECORDS IN THE WEBER COUNTY RECORDER'S OFFICE, AND OF A SURVEY MADE ON THE GROUND AND MEETS THE WEBER COUNTY ZONING REQUIREMENTS.

SIGNED THIS 7th DAY OF FEB 2014

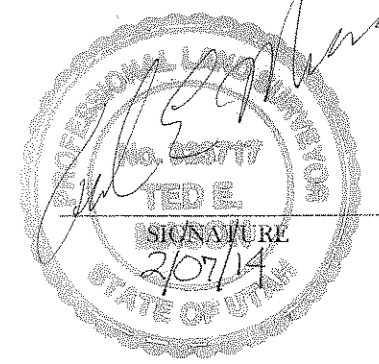

323717
LICENSE NUMBER

Boundary Description

PART OF THE SOUTHEAST AND NORTHEAST QUARTERS OF SECTION 32, T. 7 N., R. 1 E., S.L.B.&M., US SURVEY BEGINNING AT THE NORTHEAST CORNER OF LOT 63, SILVER BELL ESTATES NO. 2, SAID POINT ALSO BEING NORTH 00°03'22" EAST 2173.65 FEET ALONG SECTION LINE, AND WEST 727.81 FEET FROM THE SOUTHEAST CORNER OF SECTION 32, TOWNSHIP 7 NORTH, RANGE 1 EAST, SALT LAKE BASE AND MERIDIAN AND RUNNING THENCE THE FOLLOWING COURSES:

SOUTH 06° 16' 37" WEST	202.27 FEET	ALONG THE EAST LOT LINE OF LOT 63 EXTENDED;
SOUTH 28° 16' 37" WEST	52.57 FEET	ALONG THE WEST LINE OF LOT 48, SILVER BELL ESTATES NO. 1
SOUTH 05° 43' 29" WEST	60.77 FEET	ALONG SAID WEST LINE OF LOT 48;
SOUTH 20° 16' 37" WEST	60.00 FEET;	ALONG WEST LINE OF LOT 48 AND 49;
NORTH 74° 00' 36" WEST	239.09 FEET,	TO A POINT ON A 607.21 FOOT RADIUS CURVE TO THE LEFT, HAVING A CENTRAL ANGLE OF 1° 42' 46"
NORTHERLY	49.94 FEET	ALONG THE ARC OF SAID CURVE, CHORD BEARS NORTH 13° 38' 00" EAST 49.93 FEET
NORTH 01° 27' 15" EAST	286.06 FEET	TO A POINT ON A 122.19 FOOT RADIUS CURVE TO THE RIGHT, HAVING A CENTRAL ANGLE OF 54° 00' 10"
NORTHEASTERLY	115.17 FEET	ALONG THE ARC OF SAID CURVE, (CHORD BEARS NORTH 38° 16' 37" EAST 110.95 FEET);
NORTH 65° 16' 37" EAST	17.37 FEET;	
SOUTH 24° 43' 23" EAST	98.05 FEET;	TO A POINT ON A 74.08 FOOT RADIUS CURVE TO THE LEFT, HAVING A CENTRAL ANGLE OF 90° 00' 00"
EASTERLY	116.36 FEET	ALONG THE ARC OF SAID CURVE, CHORD BEARS SOUTH 11° 69' 43" EAST 104.76 FEET

TO THE POINT OF BEGINNING

CONTAINS 2.10 ACRES

Basis of Bearing

THE BASIS OF BEARING FOR THIS PLAT IS THE SECTION LINE BETWEEN THE SOUTHEAST CORNER AND THE NORTHEAST CORNER OF SECTION 32, T. 7 N., R. 1 E., S.L.B.&M., US SURVEY SHOWN HERON AS N 00° 03' 22" E.

Owners Dedication

WE THE UNDERSIGNED OWNERS OF THE HEREIN DESCRIBED TRACT OF LAND, DO HEREBY SET APART AND SUBDIVIDE THE SAME INTO LOTS AND STREETS, AS SHOWN HEREON AND NAME SAID TRACT

SILVER BELL ESTATES PHASE NO. 2, FIRST AMENDMENT,

AND DO HEREBY DEDICATE TO PUBLIC ALL THOSE PARTS OR PORTIONS OF SAID TRACT OF LAND DESIGNATED HEREOF AS PUBLIC UTILITY, DRAINAGE EASEMENTS, THE SAME TO BE USED FOR THE INSTALLATION AND OPERATION OF PUBLIC UTILITY SERVICE LINE, AND STORM DRAINAGE FACILITIES, FOR THE PERPETUAL PRESERVATION OF WATER CHANNELS IN THEIR NATURAL STATE WHICH EVER IS APPLICABLE AS MAY BE AUTHORIZED BY THE GOVERNING AUTHORITY, WITH NO BUILDINGS OR STRUCTURES BEING ERRECTED WITHIN SUCH EASEMENTS.

SIGNED THIS _____ DAY OF _____ 2012.

PRINT NAME _____ SIGNATURE _____

PRINT NAME _____ SIGNATURE _____

Acknowledgment

STATE OF UTAH
COUNTY OF _____

ON THE _____ DAY OF _____ 2012, PERSONALLY APPEARED BEFORE ME, THE UNDERSIGNED, NOTARY PUBLIC, THE SIGNERS OF THE ABOVE OWNERS DEDICATION, _____ IN NUMBER WHO DULY ACKNOWLEDGED TO ME THAT THEY SIGNED IT FREELY AND VOLUNTARILY FOR THE PURPOSES THEREIN MENTIONED.

COMMISSION EXPIRES _____ NOTARY PUBLIC

Weber County Recorder

ENTRY NO. _____ FEE PAID _____

FILED FOR RECORD AND

RECORDED _____ AT _____

IN BOOK _____ OF OFFICIAL

RECORDS, PAGE _____ RECORDED

FOR _____

COUNTY RECORDER


BY: _____

DEPUTY





Owner/Developer
GARY H. BRADEN
5023 S 2500 W
ROY UT 84067

SOUTHEAST CORNER OF SECTION 32,
T7N, R1E, SLB&M,
BLM 2" BRASS CAP
DATED 1968
GOOD CONDITION

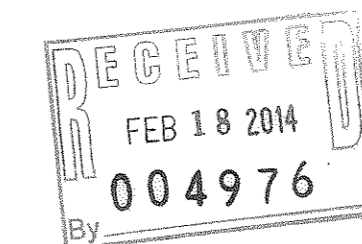

Weber-Morgan Health Department
I HEREBY CERTIFY THAT THE SOILS, PERCOLATION RATES, AND SITE CONDITIONS FOR THIS SUBDIVISION HAVE BEEN INVESTIGATED BY THIS OFFICE AND ARE APPROVED FOR ON-SITE WASTEWATER DISPOSAL SYSTEMS.
SIGNED THIS _____ DAY OF _____ 20____

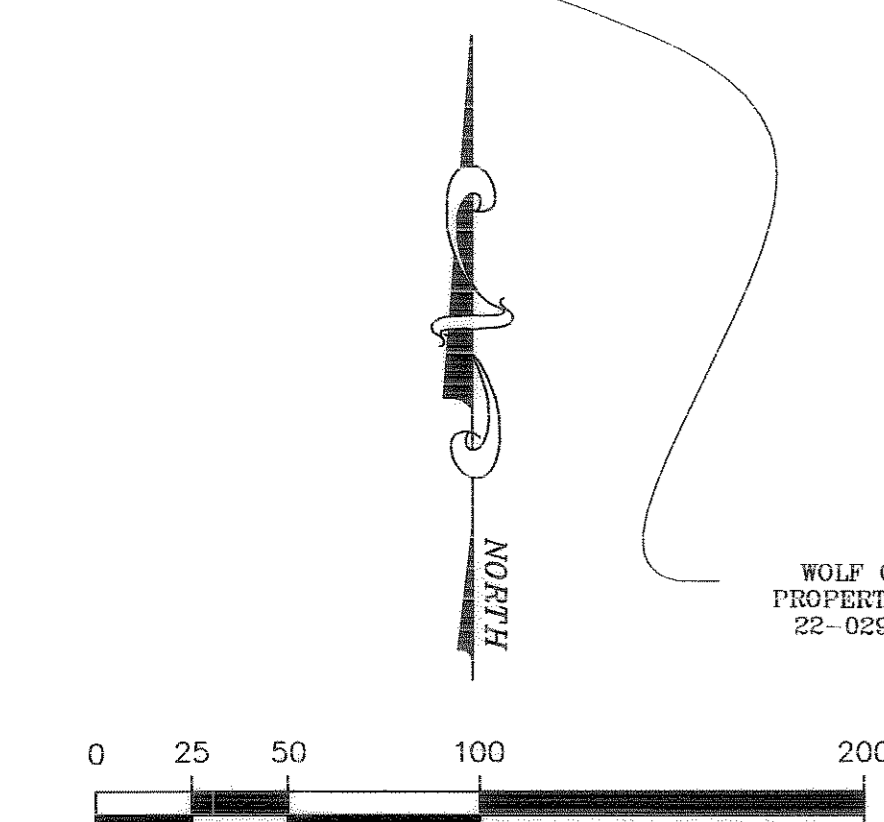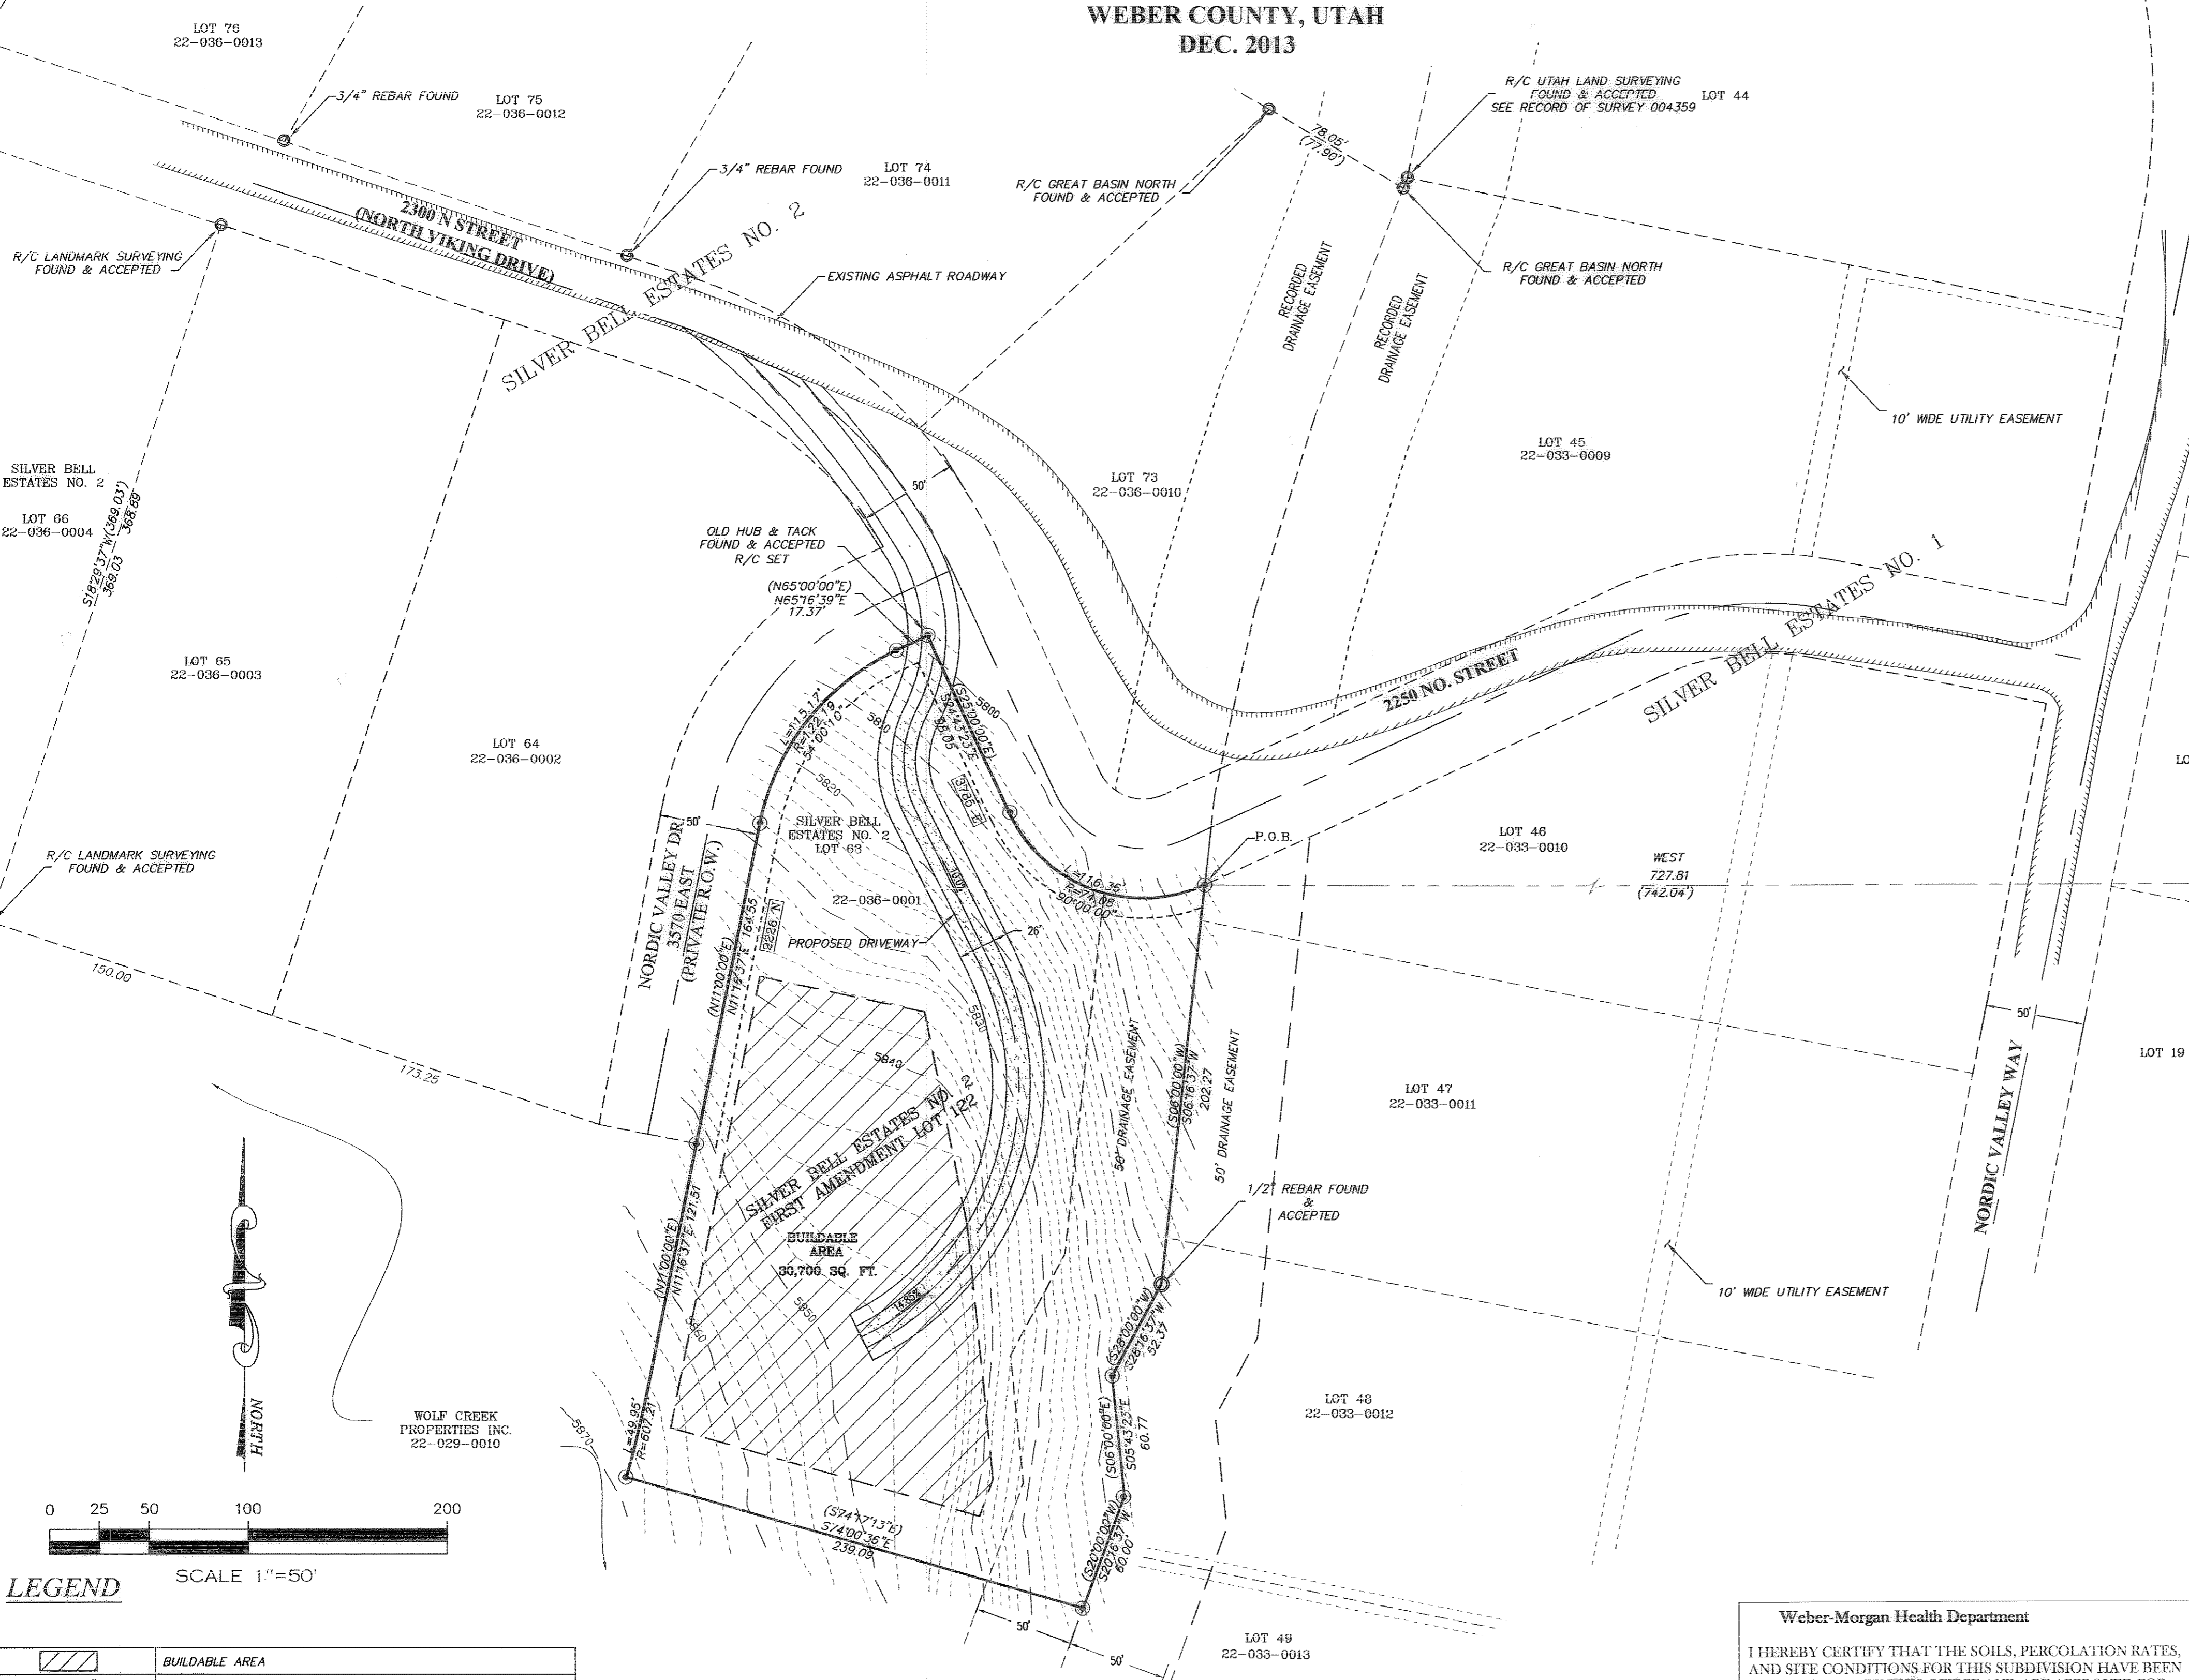

LEGEND SCALE 1"=50'

	BUILDABLE AREA
	EXISTING ROADWAY
	PROPERTY CORNER SET (REBAR & CAP, "TED MASON, 323717" 5/8" x 24" REBAR)
	RECORD MEASUREMENT FROM PLAT/DEED
	PROPERTY CORNER FOUND (AS NOTED)
	GOVERNMENT LOT CORNER

NARRATIVE
THE PURPOSE OF THIS SURVEY IS TO COMBINE LOT 63 OF SILVERBELL ESTATES NO.2 AND THE ADJOINING PARCEL TO THE SOUTH INTO A SINGLE LOT KNOWN AS SILVER BELL NO. 2, FIRST AMENDMENT. THE BASIS OF BEARING IS STATE PLANE BETWEEN THE NORTHEAST CORNER AND THE SOUTHEAST CORNER OF SECTION 32, TOWNSHIP 7 NORTH, RANGE 1 EAST, SALT LAKE BASE AND MERIDIAN, HELD AS S 00°03'22" W. THE EXISTING LOT CORNERS WERE RE-TRACED BASED UPON MONUMENTS AS NOTED. THE EXISTING ROADWAY IS DEFINED BY ACTUAL SURVEY.

Weber County Planning Commission Approval
THIS IS TO CERTIFY THAT THIS SUBDIVISION PLAT WAS DULY APPROVED BY THE WEBER COUNTY PLANNING COMMISSION
SIGNED THIS _____ DAY OF _____ 20____
CHAIRMAN, WEBER COUNTY PLANNING COMMISSION

Weber County Engineer
I HEREBY CERTIFY THAT THE REQUIRED PUBLIC IMPROVEMENT STANDARDS AND DRAWINGS FOR THIS SUBDIVISION CONFORM WITH THE COUNTY STANDARDS AND THE AMOUNT OF THE FINANCIAL GUARANTEE IS SUFFICIENT FOR THE INSTALLATION OF THESE IMPROVEMENTS.
SIGNED THIS _____ DAY OF _____ 20____

Weber County Commission Acceptance
THIS IS TO CERTIFY THAT THIS SUBDIVISION PLAT, THE DEDICATION OF STREETS AND OTHER PUBLIC WORKS AND FINANCIAL GUARANTEE OF PUBLIC IMPROVEMENTS ASSOCIATED WITH THIS SUBDIVISION, THEREON ARE HEREBY APPROVED AND ACCEPTED BY THE COMMISSIONERS OF WEBER COUNTY, UTAH.
SIGNED THIS _____ DAY OF _____ 20____
ATTEST: _____

Weber County Surveyor
I HEREBY CERTIFY THAT THE WEBER COUNTY SURVEYORS OFFICE HAS REVIEWED THIS PLAT FOR MATHEMATICAL CORRECTNESS, SECTION CORNER DATA, AND FOR HARMONY WITH LINES AND MONUMENTS ON RECORD IN COUNTY OFFICES. THE APPROVAL OF THIS PLAT BY THE WEBER COUNTY SURVEYOR DOES NOT RELIEVE THE LICENSED LAND SURVEYOR WHO EXECUTED THIS PLAT FROM THE RESPONSIBILITIES AND/OR LIABILITIES ASSOCIATED THEREWITH.
SIGNED THIS _____ DAY OF _____ 20____

Weber County Attorney
I HAVE EXAMINED THE FINANCIAL GUARANTEE AND OTHER DOCUMENTS ASSOCIATED WITH THIS SUBDIVISION PLAT, AND IN MY OPINION THEY CONFORM WITH THE COUNTY ORDINANCE APPLICABLE THERETO AND NOW IN FORCE AND AFFECT.
SIGNED THIS _____ DAY OF _____ 20____