


Total Area Contains:
161,374 sq. ft.
or 3.705 acres

Legend

○	Manhole	TA	Top of Asphalt
□ GM	Gas Meter	EA	Edge of Asphalt
□ FH	Fire Hydrant	SW	Top of Walk
⊗ WV	Water Valve	TP	Top of Concrete
---	Buried Phone Cable	Lip	Lip of Gutter
---	Sanitary Sewer Line	WP	Working Point
---	Culinary Water Line	FL	Flowline
---	Gas Line	TC	Top of Curb
---	Storm Drain Line	99a00	Spot Elevation
---	Irrigation Water Line	φ	Diameter
---	Buried Power Line	---	Flowline
---	Buried Cable Line	---	Centerline
+	Sign	---	Contour
• PP	Power Pole	○	Deciduous Tree
• SP	Signal Pole	○	Coniferous Tree
---	Fence	---	Asphalt
---	Overhead Power, Telephone & Cable TV Line	---	Concrete
CMP	Corrugated Metal Pipe	---	Existing Building
RCP	Reinforced Concrete Pipe	---	Inlet Box
□ ICB	Irrigation Control Box	---	Post
• BOL	Bollard	---	Catch Basin
□ TB	Telephone Box	---	Power Meter
□ EB	Electrical Box	---	Building Column
⊕ HB	Hose Bib		
⊕ ECAB	Electrical Cabinet		
⊕ LP	Light Pole		
○	Street Light		

Benchmark
 Brass Cap Monument at the Intersection of 20th Street and Grant Avenue
 Elevation = 4296.43 (assigned)
 Observed June 22, 2013

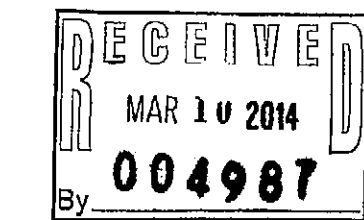

<p>Designed by: --- Drafted by: kh Client Name: PEG 13-60PH1-AS</p>	<p style="text-align: center;">GREAT BASIN ENGINEERING - SOUTH CONSULTING ENGINEERS and LAND SURVEYORS 2010 North Redwood Road, P.O. Box 16747 Salt Lake City, Utah 84116 Ogden (801)394-7288 Fax (801)391-8551 Salt Lake City (801)521-8639</p>
<p>ALTA / ACSM Land Title Survey Ogden River Project 20th Street and Grant Avenue Ogden, Weber County, Utah A Part of the NE 1/4 of Section 29, T6N, R1W, SL&M, U.S. Survey</p>	
<p>2 Jul, 2013 SHEET NO. 2 of 2</p>	