

# GIBSON DAIRY LC SUBDIVISION

## A PART OF THE SW 1/4 OF SEC. 21 T.6N., R.2W., S.L.B.&M.


### WEBER COUNTY, UTAH

#### RECORD OF SURVEY

**SURVEYOR'S CERTIFICATE**

I, DALLAS K. BUTTARS, HOLDING LICENSE NUMBER 167594 IN ACCORDANCE WITH TITLE 58, CHAPTER 22, PROFESSIONAL ENGINEERS AND LAND SURVEYORS LICENSING ACT, HAVE COMPLETED A SURVEY OF THE PROPERTY DESCRIBED ON THE PLAT IN ACCORDANCE WITH SECTION 17-23-17 AND HAVE VERIFIED ALL MEASUREMENTS AND PLACED MONUMENTS AS REPRESENTED ON THE PLAT.

I DO ALSO HEREBY CERTIFY THAT THIS PLAT OF GIBSON DAIRY LC SUBDIVISION IN WEBER COUNTY, UTAH, HAS BEEN CORRECTLY DRAWN TO SCALE AND IS A TRUE AND CORRECT REPRESENTATION OF THE FOLLOWING DESCRIPTION OF LANDS INCLUDED IN SAID SUBDIVISION, BASED ON DATA COMPILED FROM RECORDS IN THE WEBER COUNTY RECORDERS OFFICE, WEBER COUNTY SURVEYORS OFFICE AND OF A SURVEY MADE ON THE GROUND.

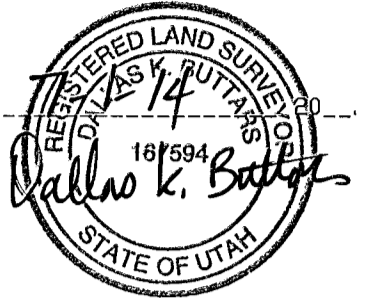

SIGNED THIS \_\_\_\_\_ DAY OF \_\_\_\_\_, 20\_\_\_\_

**OWNER'S DEDICATION**

WE, THE UNDERSIGNED OWNERS OF THE HEREIN DESCRIBED TRACT OF LAND, DO HEREBY SEPARATE AND SUBDIVIDE THE SAME INTO LOTS AND STREETS AS SHOWN HEREON AND NAME SAID TRACT GIBSON DAIRY LC SUBDIVISION AND ALSO GRANT AND DEDICATE A PERPETUAL RIGHT AND EASEMENT OVER, UPON AND UNDER THE LANDS DESIGNATED HEREIN AS PUBLIC UTILITY, STORM WATER RETENTION PONDS DRAINAGE EASEMENTS, THE SAME TO BE USED FOR THE INSTALLATION, MAINTENANCE AND OPERATION OF PUBLIC UTILITY SERVICE LINES, STORM DRAINAGE FACILITIES OR FOR THE PERPETUAL PRESERVATION OF WATER CHANNELS IN THEIR NATURAL STATE WHICHEVER IS APPLICABLE AS MAY BE AUTHORIZED BY THE GOVERNING AUTHORITY, WITH AND BUILDINGS OR STRUCTURES BEING ERRECTED WITHIN SUCH EASEMENTS.

SIGNED THIS \_\_\_\_\_ DAY OF \_\_\_\_\_, 20\_\_\_\_

Mary K. Fowers - Trustee

**ACKNOWLEDGMENT**

STATE OF UTAH, )  
COUNTY OF WEBER, )  
ON THIS \_\_\_\_\_ DAY OF \_\_\_\_\_, 20\_\_\_\_, PERSONALLY APPEARED BEFORE ME, THE UNDERSIGNED NOTARY PUBLIC, THE SIGNERS OF THE ABOVE OWNERS DEDICATION, IN NUMBER, WHO DULY ACKNOWLEDGED TO ME THAT THEY SIGNED IT FREELY AND VOLUNTARILY AND FOR THE PURPOSES THEREIN MENTIONED.



COMMISSION EXPIRES \_\_\_\_\_ NOTARY PUBLIC \_\_\_\_\_

**BOUNDARY DESCRIPTION**

Part of the Southwest Quarter of Section 21, Township 6 North, Range 2 West, Salt Lake Base & Meridian, U.S. Survey:

Beginning at the intersection of the North right of way of 1800 South Street and the East right of way of 4300 West Street, sold point being North 0°30'47" East 40.00 feet along the Section Line and South 89°07'58" East 33.00 feet from the Southwest Corner of said Section 21, and running thence North 0°30'47" East 207.50 feet along said East right of way of 4300 West Street to the South boundary line of the L&R Home & Farm Subdivision as found in the Weber County Recorder's Office, thence along said South boundary line South 89°07'58" East 164.89 feet, thence South 0°30'47" West 207.50 feet to the said North right of way of 1800 South Street, thence along said right of way North 89°07'58" West 164.89 feet to the point of beginning.

Contains 0.785 Acres

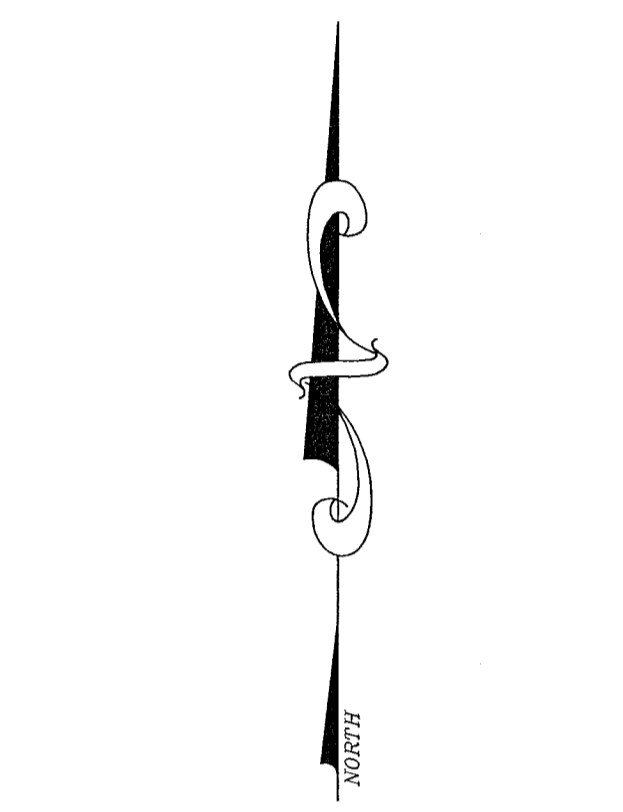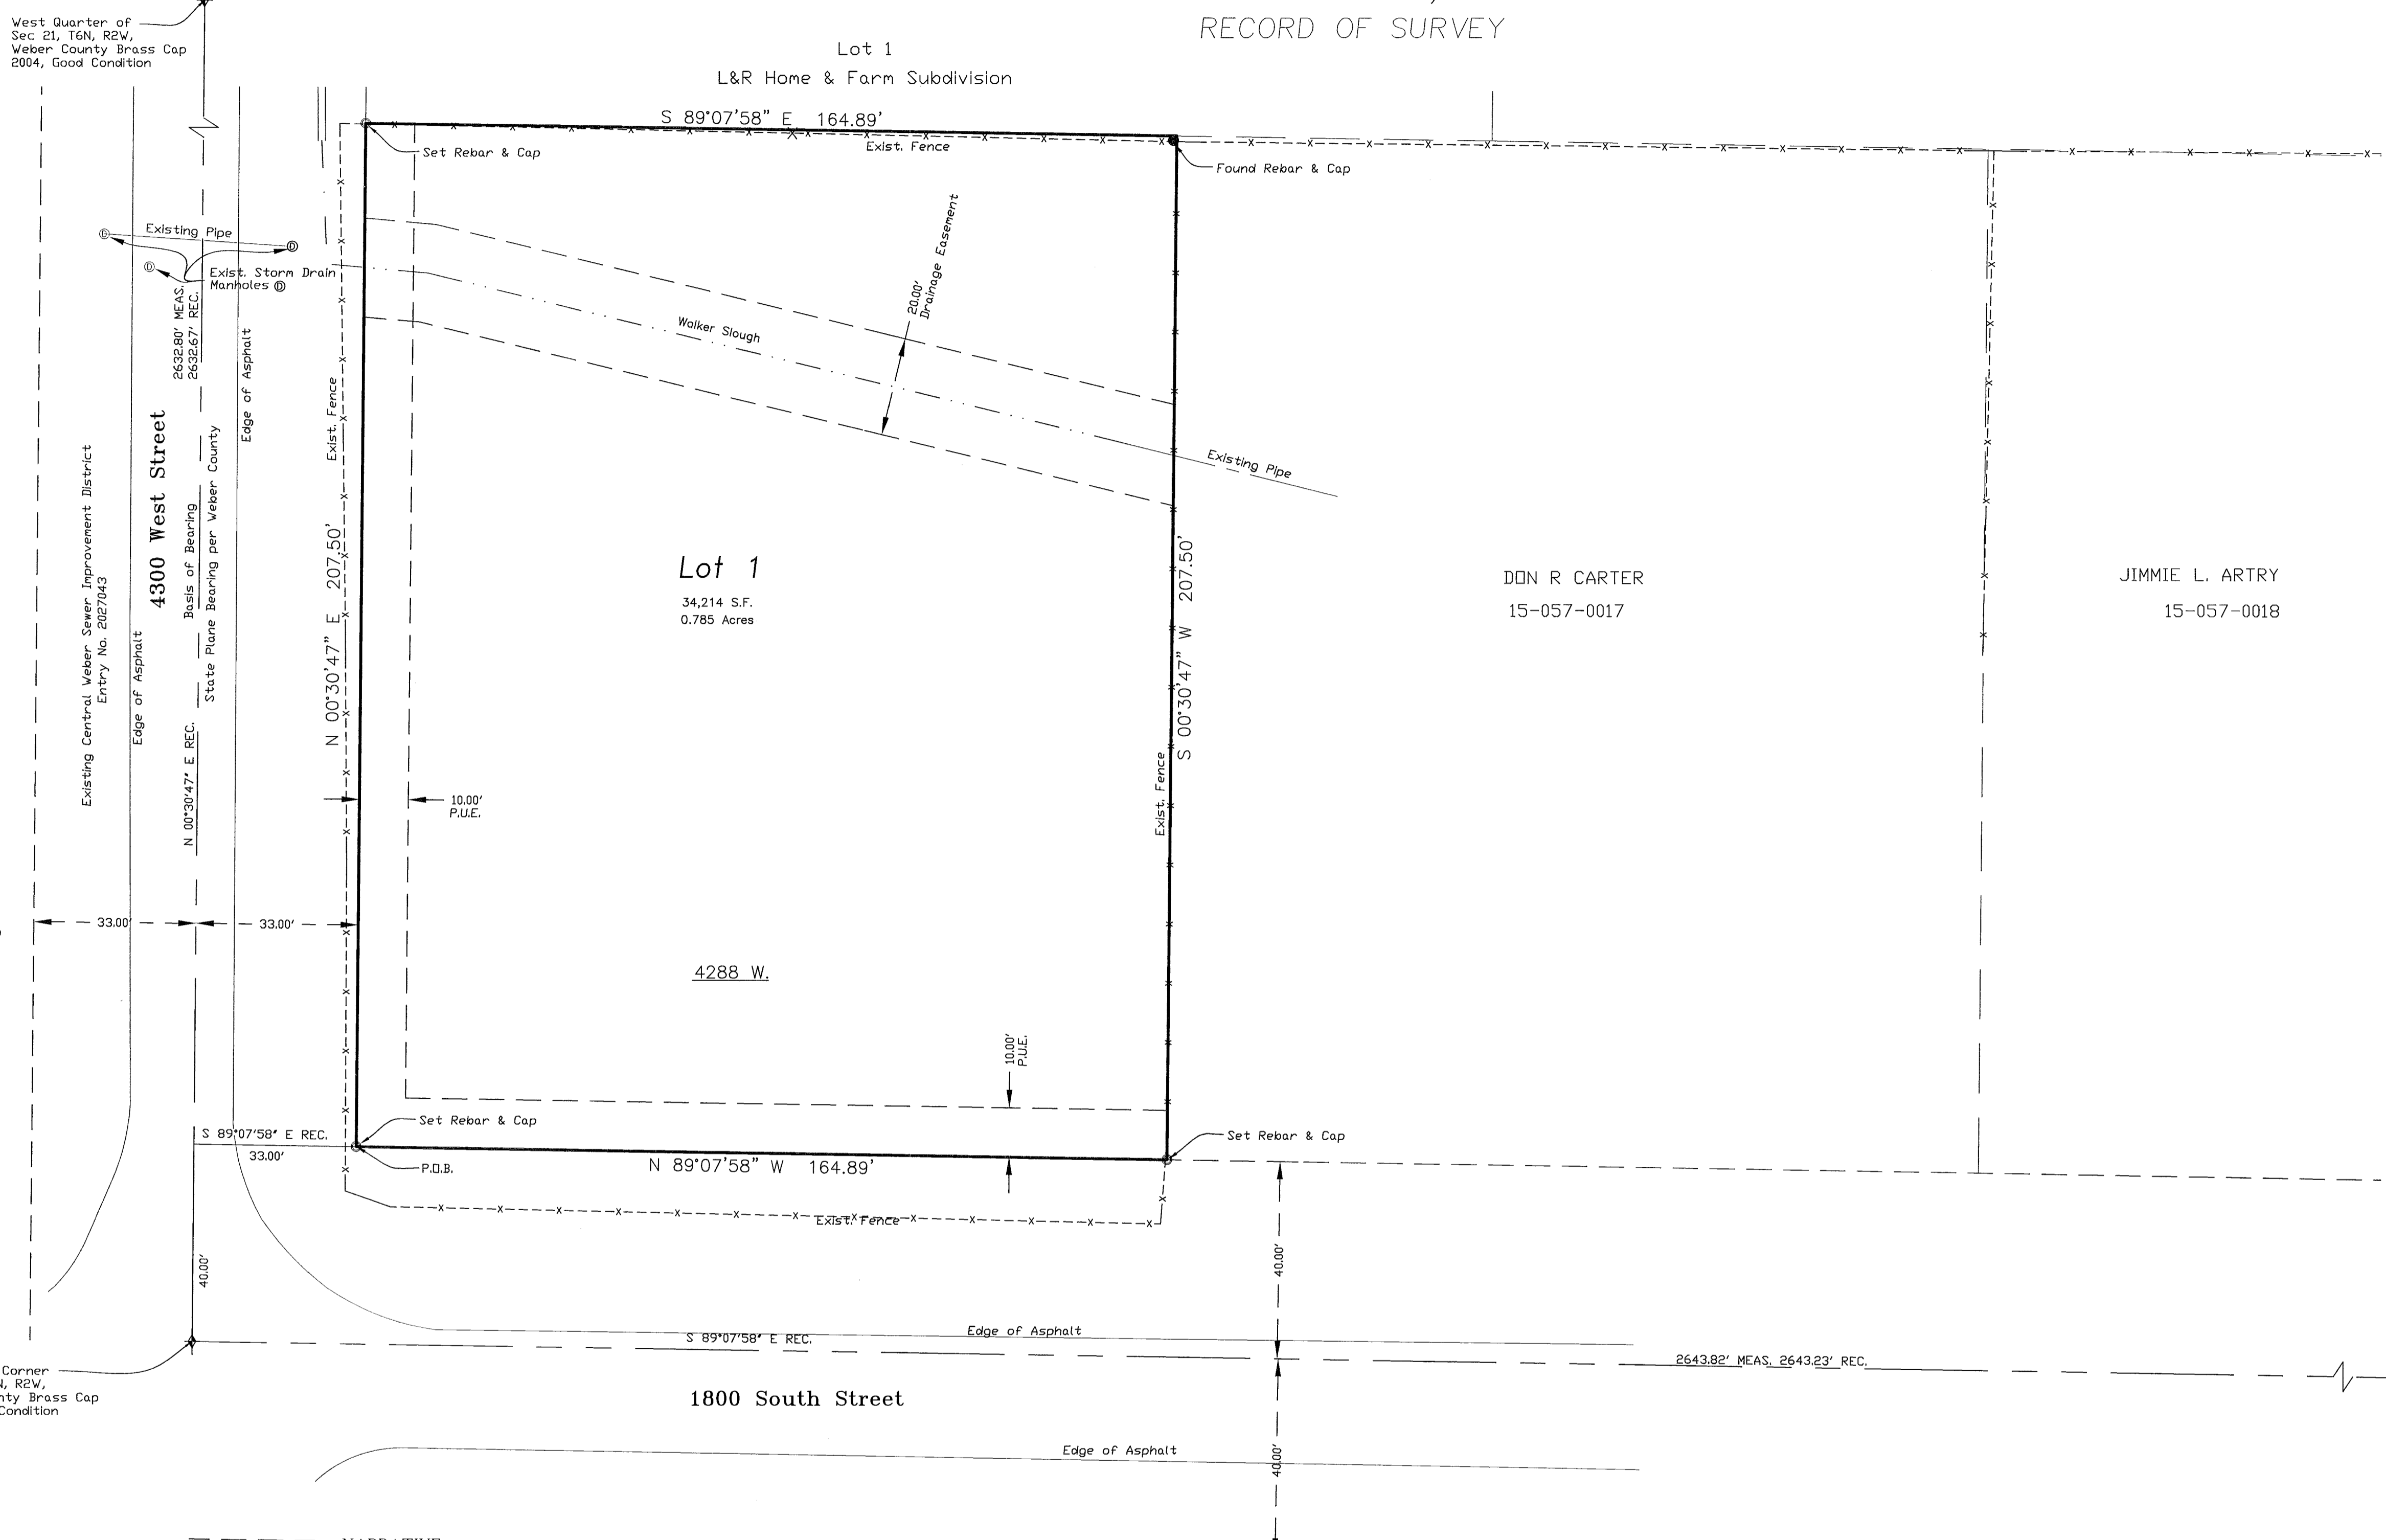

**GRAPHIC SCALE**  
( IN FEET )  
1 inch = 20 ft.

--- EXISTING FENCE

○ SET 5/8" x 24" REBAR WITH CAP STAMPED 167594  
● FOUND REBAR & CAP

**NARRATIVE**

The purpose of this survey was to create an approved Weber County 1 lot subdivision. The County is aware that this parcel does not meet the minimum area requirements and have instructed the property owner to proceed with the subdivision application.

Basis of Bearing is as shown between the Southwest Corner and the West 1/4 corner monuments and is State Plane Grid Bearing as published by Weber County Surveyors Office.

**AGRICULTURAL NOTE**


AGRICULTURE IS THE PREFERRED USE IN THE AGRICULTURE ZONES. AGRICULTURE OPERATIONS AS SPECIFIED IN THE ZONING ORDINANCE FOR A PARTICULAR ZONE ARE PERMITTED AT ANY TIME INCLUDING THE OPERATION OF FARM MACHINERY AND NO ALLOWED AGRICULTURE USE SHALL BE SUBJECT TO RESTRICTION ON THE BASIS THAT IT INTERFERES WITH ACTIVITIES OF FUTURE RESIDENTS OF THIS SUBDIVISION.

**NOTE:**

Due to the Topography and the location of this subdivision all owners will accept responsibility for any Storm Water runoff from the road adjacent to this property until curb and gutter is installed.

DEVELOPER:  
Mary Fowers  
Gibson Dairy  
4390 W. 1400 S.  
Ogden  
UTAH, 84401

**RECORD OF SURVEY**

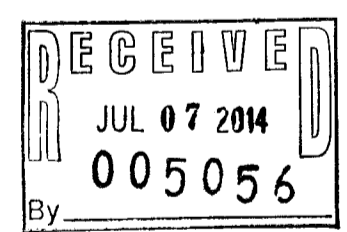

**WEBER COUNTY PLANNING COMMISSION APPROVAL**

THIS IS TO CERTIFY THAT THIS SUBDIVISION PLAT WAS DULY APPROVED BY THE WEBER COUNTY PLANNING COMMISSION ON THE \_\_\_\_\_ DAY OF \_\_\_\_\_, 20\_\_\_\_.

\_\_\_\_\_  
SIGNATURE

**WEBER COUNTY ENGINEER**

I HEREBY CERTIFY THAT THE REQUIRED PUBLIC IMPROVEMENT STANDARDS AND DRAWINGS FOR THIS SUBDIVISION CONFORM WITH COUNTY STANDARDS AND THE AMOUNT OF THE FINANCIAL GUARANTEE IS SUFFICIENT FOR THE INSTALLATION OF THESE IMPROVEMENTS.

SIGNED THIS \_\_\_\_\_ DAY OF \_\_\_\_\_, 20\_\_\_\_.

\_\_\_\_\_  
SIGNATURE

**WEBER COUNTY SURVEYOR**

I HEREBY CERTIFY THAT THE WEBER COUNTY SURVEYOR'S OFFICE HAS REVIEWED THIS PLAT FOR MATHEMATICAL CORRECTNESS, SECTION CORNER DATA, AND FOR HARMONY WITH LINES AND MONUMENTS ON RECORD IN COUNTY OFFICES. THE APPROVAL OF THIS PLAT BY THE WEBER COUNTY SURVEYOR DOES NOT RELIEVE THE LICENSED LAND SURVEYOR WHO EXECUTED THIS PLAT FROM THE RESPONSIBILITIES AND/OR LIABILITIES ASSOCIATED THEREWITH.

SIGNED THIS \_\_\_\_\_ DAY OF \_\_\_\_\_, 20\_\_\_\_.

\_\_\_\_\_  
SIGNATURE

**WEBER COUNTY ATTORNEY**

I HAVE EXAMINED THE FINANCIAL GUARANTEE AND OTHER DOCUMENTS ASSOCIATED WITH THIS SUBDIVISION PLAT, AND IN MY OPINION THEY CONFORM WITH THE COUNTY ORDINANCE APPLICABLE THERETO AND NOW IN FORCE AND AFFECT.

SIGNED THIS \_\_\_\_\_ DAY OF \_\_\_\_\_, 20\_\_\_\_.

\_\_\_\_\_  
SIGNATURE

**WEBER COUNTY COMMISSION ACCEPTANCE**

THIS IS TO CERTIFY THAT THIS SUBDIVISION PLAT, THE DEDICATION OF STREETS AND OTHER PUBLIC WAYS AND FINANCIAL GUARANTEE OF PUBLIC IMPROVEMENTS ASSOCIATED WITH THIS SUBDIVISION, THEREON ARE HEREBY APPROVED AND ACCEPTED BY THE COMMISSIONERS OF WEBER COUNTY, UTAH THIS \_\_\_\_\_ DAY OF \_\_\_\_\_, 20\_\_\_\_.

TITLE: CHAIRMAN, WEBER COUNTY COMMISSION  
ATTEST: \_\_\_\_\_

<b>LANDMARK SURVEYING, INC.</b> A COMPLETE LAND SURVEYING SERVICE 4646 S. 3500 W. WA-3, WEST HAVEN, UTAH 84401 PHONE 801-731-4075 FAX 801-731-8506		<b>WEBER COUNTY RECORDER</b>	
CLIENT: GIBSON DAIRY		ENTRY # _____ EE	
LOCATION: PART OF SEC. 21, T6N., R2W., S.L.B.&M. WEST WEBER, WEBER COUNTY, UTAH		FILED FOR RECORD & RECORDED	
SURVEYED: MARCH 2014		THIS _____ DAY OF _____, 20____	
REVISIONS:		AT _____ IN BOOK _____ OF _____	
DRAWN BY: TJK		PAGE _____	
CHECKED BY: DKB		WEBER COUNTY RECORDER	
DATE: 03-14-14		BY _____	
FILE: 3410		DEPUTY	