


RECORD OF SURVEY
5153 SOUTH 6300 WEST, HOOPER, UTAH
 LOCATED IN THE NORTHWEST QUARTER OF SECTION 13, TOWNSHIP 5 NORTH, RANGE 3 WEST,
 SALT LAKE BASE AND MERIDIAN, WEBER COUNTY UTAH,

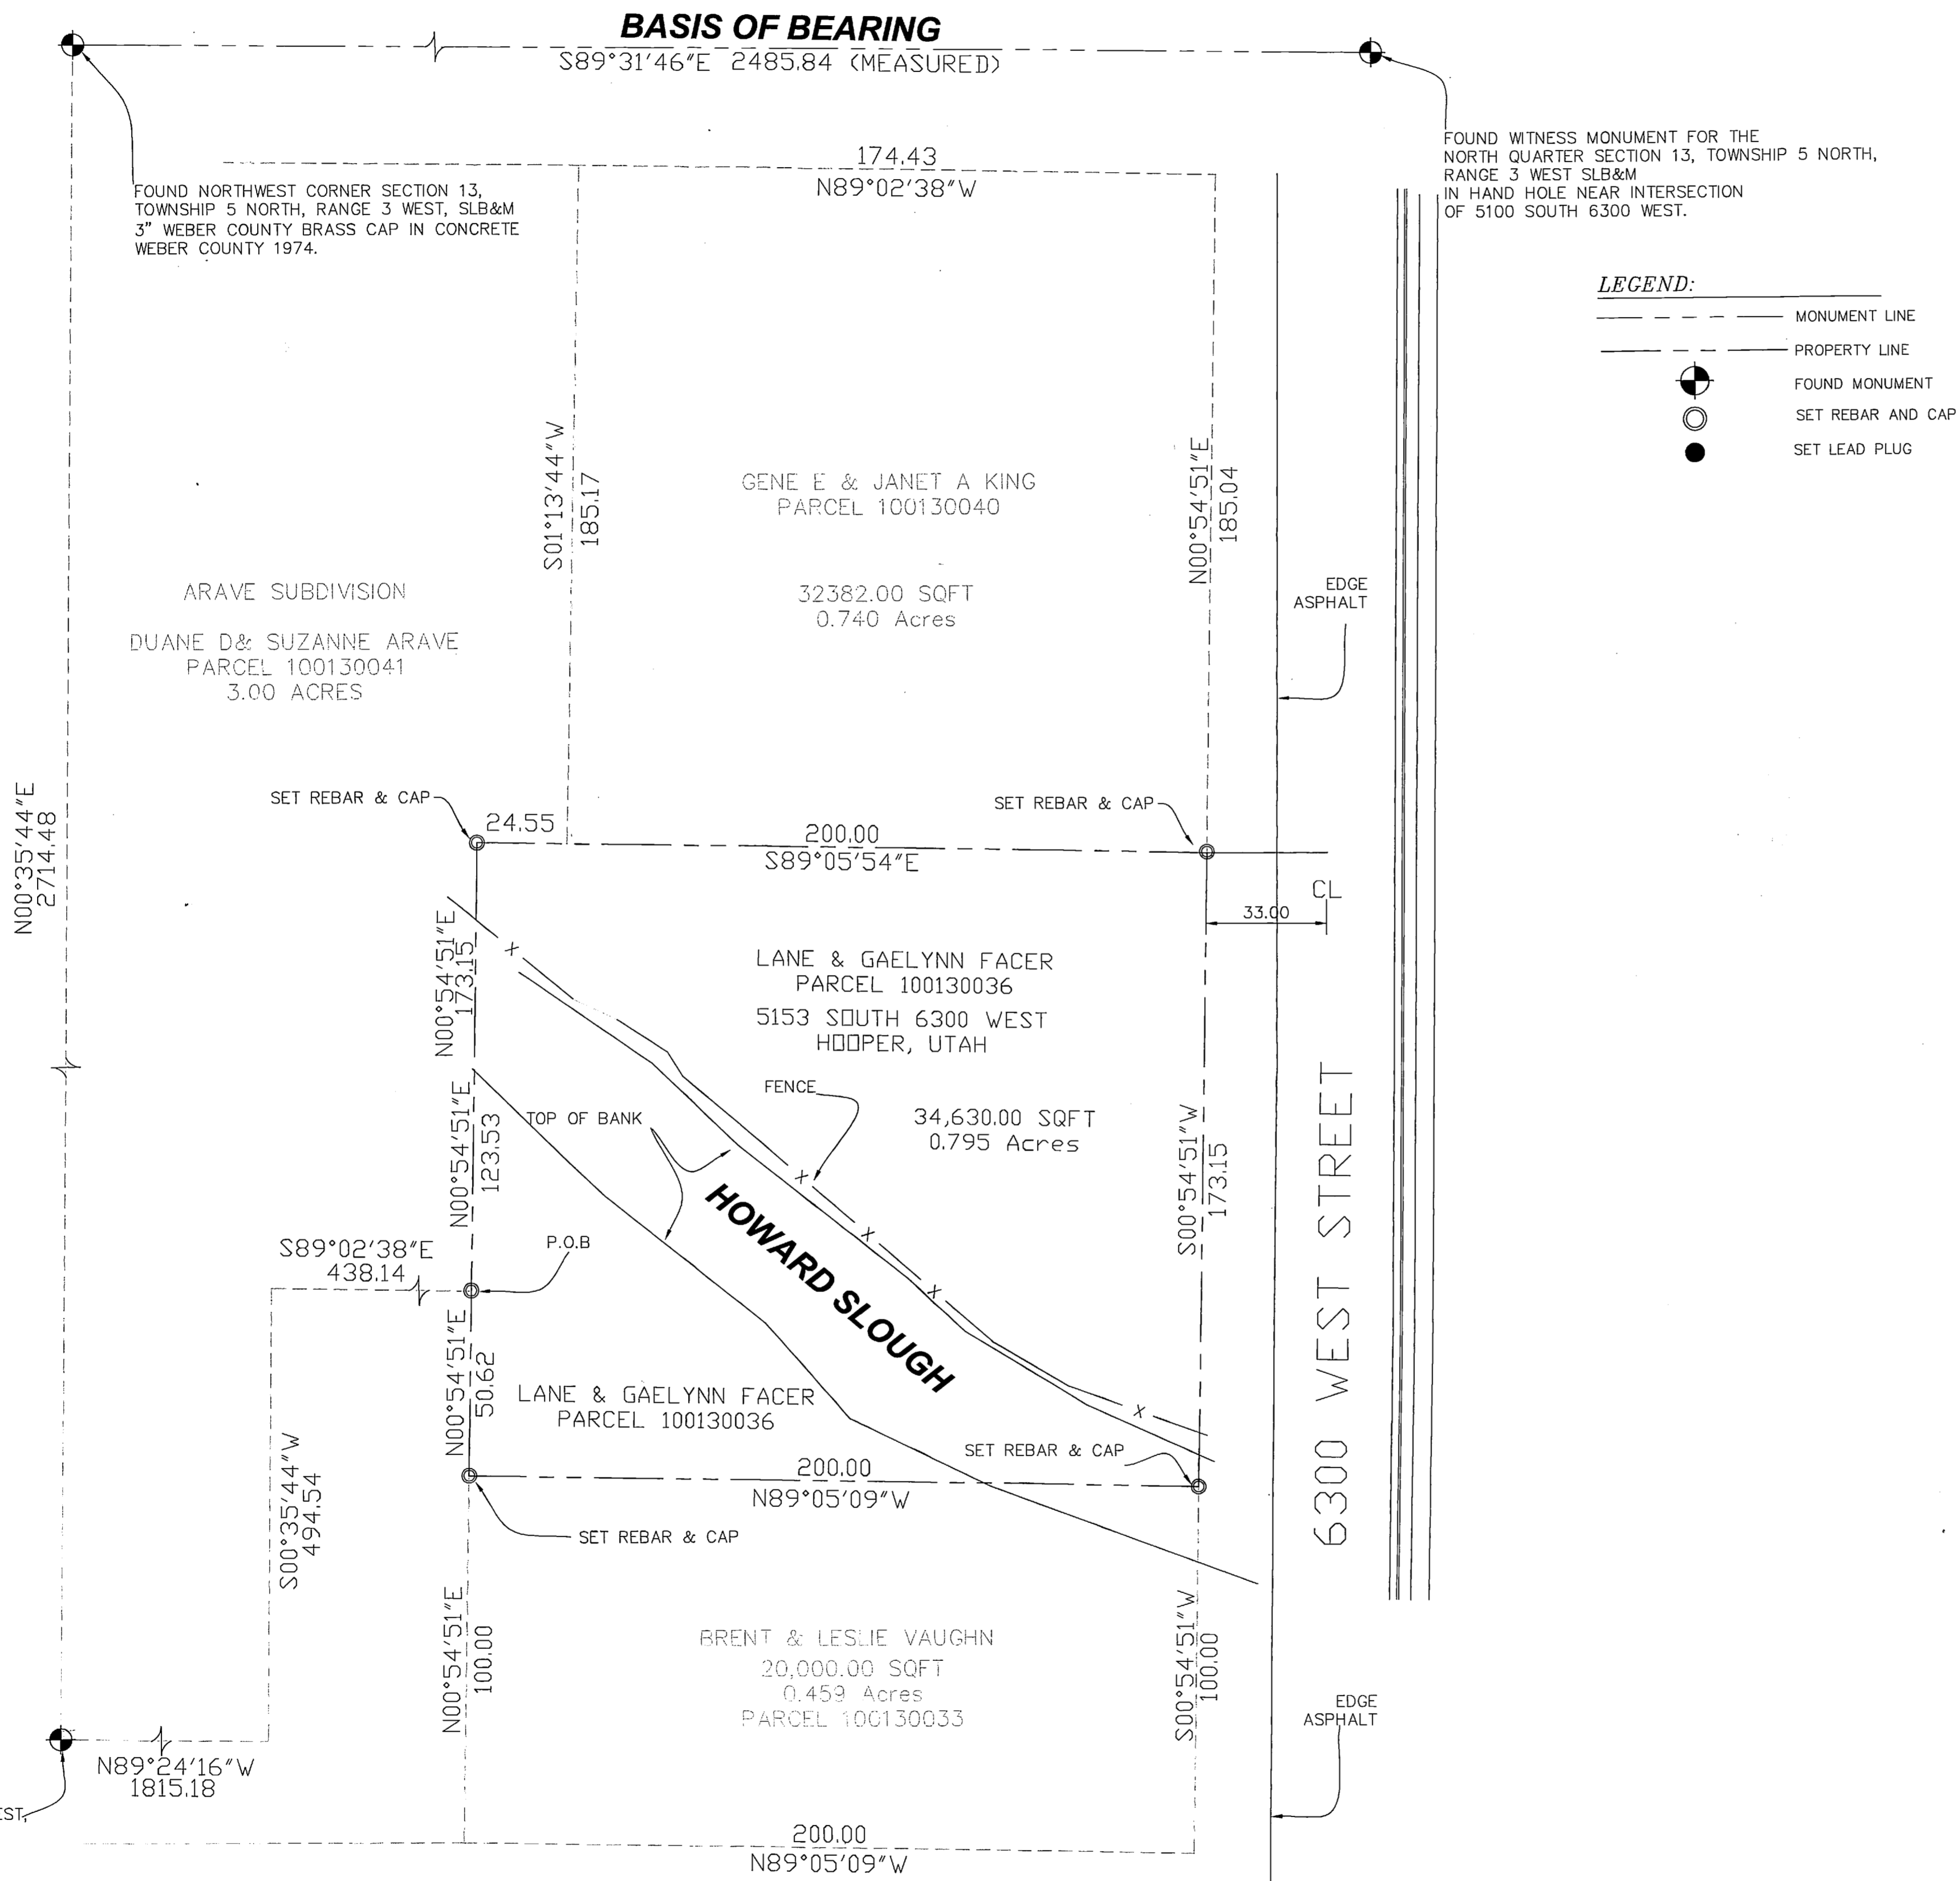

LAYTON SURVEYS

Professional Land Surveying

(801) 698-5997 www.gpsdatacapture@aol.com

1812 West 2575 South
 Syracuse, UT 84075

Record of Survey for Lane Facer
 5153 South 6300 West, Hooper, Utah
 Salt Lake Base and Meridian, Weber County, Utah

Surveyed By: Kevin Long
 Job No.: 005-13
 Scale: 1"=30'
 Date: September 2013

