


MAIN POINT SOUTH SUBDIVISION PLAT 3
PHASES 1 & 2

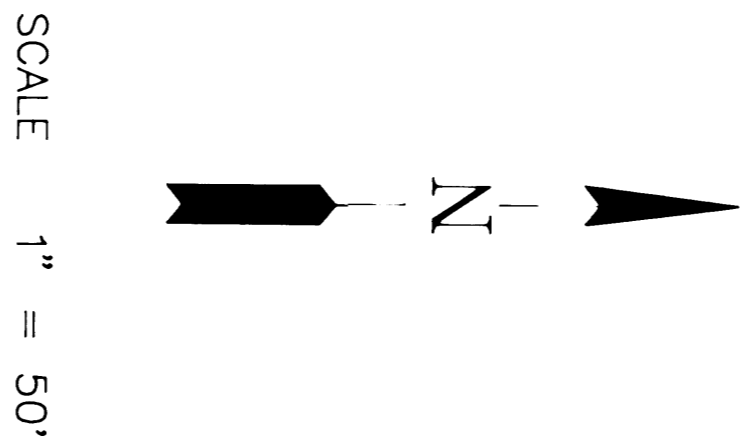

SURVEYOR'S CERTIFICATE:

I, O. NEIL SMITH, A REGISTERED SURVEYOR AS PRESCRIBED BY THE LAWS OF THE STATE OF UTAH AND HOLDING LICENSE NO. 2337 DO HEREBY CERTIFY THAT I HAVE MADE A SURVEY OF THE FOLLOWING DESCRIBED PROPERTY AND THAT THE PLAT HEREON IS A TRUE REPRESENTATION OF THE PROPERTY SURVEYED.

DATE: MARCH 28, 1991

O. NEIL SMITH

AS SURVEYED DESCRIPTION:

PART OF THE NORTHWEST QUARTER OF SECTION 22, T. 5 N., R. 1 W., S. 1 B. & M.

BEGINNING AT THE NORTHEAST CORNER OF MAIN POINT SOUTH SUBDIVISION NO. 3 - PHASE 2, WHICH IS 520.04' SOUTH AND 701.38' EAST FROM THE NORTHWEST CORNER OF SAID QUARTER SECTION; RUNNING THENCE NORTH 89° 30' 32" WEST ALONG AN OLD EXISTING FENCE TO A POINT 10' FEET EAST OF SAID EAST LINE TO THE SOUTH LINE OF THE ROAD (CRESTWOOD DRIVE); THENCE ALONG THE ARC OF A 130.00' FOOT RADIUS CURVE TO THE LEFT FOR A DISTANCE OF 97.65' TO THE POINT OF BEGINNING.

BEARING IS THE WEST LINE OF SECTION 22, T. 5 N., R. 1 W., S. 1 B. & M. AS S 00° 48' 45" W. AS S 00° 48' 45" W.

RECORD DESCRIPTION (SERIAL NO. 07-085-0009):

THENCE ALONG THE ARC OF A 130.00' FOOT RADIUS CURVE TO THE LEFT FOR A DISTANCE OF 97.65' TO THE POINT OF BEGINNING.

NARRATIVE:



RECEIVED
 MAY 15 1991
 Weber County Surveyor

ONESCO ENGINEERING, INC.
 105 SKYLINE DRIVE
 BRIGHAM CITY, UTAH 84302

CLIENT: HINCKLEY / CREST REALTY (WALT MCBURNE)

SURVEY LOCATION: HIGHWAY 30 & 89 - CRESTWOOD DRIVE
 SOUTH OGDEN CITY, UTAH

NORTHWEST QUARTER SECTION 22,
 T. 5 N., R. 1 W., S. 1 B. & M.