


**CERTIFICATE**

I, VON R. HILL, A PROFESSIONAL LAND SURVEYOR ACCORDING TO THE LAWS OF THE STATE OF UTAH, DO CERTIFY THAT I HAVE SURVEYED THE PARCEL OF GROUND SHOWN HEREON ACCORDING TO UTAH STATE CODE 17-23-17.

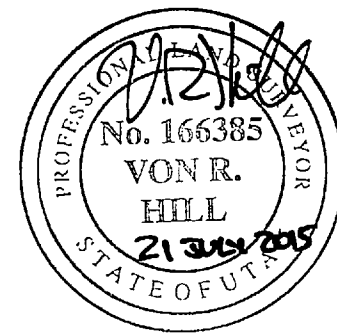

**DESCRIPTION**

THE WESTERLY LINE OF TAX PARCEL# 210210073, LOCATED IN THE NORTHEAST QUARTER OF SECTION 16, TOWNSHIP 6 NORTH, RANGE 2 EAST, SALT LAKE BASE AND MERIDIAN, WEBER COUNTY, UTAH.

**NARRATIVE**

THE PURPOSE OF THE SURVEY WAS TO MARK THE WEST LINE OF TAX PARCEL# 210210073 AND POINTS ALONG SAID LINE. THE BASIS OF BEARING WAS ESTABLISHED BETWEEN THE MONUMENTS ALONG THE SECTION LINE, AS SHOWN.

A 1991 SURVEY BY BUTTARS SURVEYING, SURVEY# 000576, AND A 1998 SURVEY BY LANDMARK SURVEYING, SURVEY# 001987, WERE REFERENCED TO RETRACE THIS LINE. BOTH SURVEYS DESCRIBE THIS SAME LINE, BUT WE USED BEARINGS AND DISTANCES OF THE LANDMARK SURVEY.

FOUND DISTURBED REBAR & CAP  
N07° 34'W 3.7' OF CORNER;  
FOUND LANDMARK REBAR & CAP  
S11° 34'W 1.9' OF CORNER;  
SET H&A REBAR AND CAP AT CORNER

(S89° 22'E-DEED)  
S89° 05' 17"E  
226.00'

NE CORNER, SECTION 16,  
T.6N., R.2E., S.L.B.&M.  
FOUND 3" WEBER COUNTY SURVEYOR  
BRASS DISC WITH "X"

SET H&A REBAR AND CAP ON LINE,  
117.0' SOUTHERLY OF NE CORNER

SET H&A REBAR AND CAP ON LINE,  
200.0' SOUTHERLY OF NE CORNER

SET H&A REBAR AND CAP ON LINE,  
380.2' SOUTHERLY OF NE CORNER

TAX PARCEL#  
210220052

TAX PARCEL#  
210210073

SET H&A REBAR AND CAP ON LINE,  
515.2' SOUTHERLY OF NE CORNER

(NORTH 1076.30-DEED)  
1080.03'

N00° 14' 10"W

0.7'

2.4'

2.0'

1.9'

1.1'


0.7'

SET H&A REBAR AND CAP  
AT CORNER, TYPICAL

BASIS OF BEARING  
S00° 14' 13"E 2647.66' (2647.79'-RECORD)

EAST 1/4 COR., SECTION 16,  
T.6N., R.2E., S.L.B.&M.  
FOUND 3" WEBER COUNTY SURVEYOR  
BRASS DISC WITH PUNCH MARK,

- LEGEND**
- PROPERTY LINE —————
  - ADJACENT PROPERTY - - - - -
  - TIE TO MONUMENT - - - - -
  - SECTION LINE - - - - -
  - FENCE LINE - - - - -
  - RECORD CALLS ( )
  - SET 5/8" REBAR WITH H&A CAP,  
LS# 166385, AT CORNER  
(UNLESS OTHERWISE NOTED) ●
  - FOUND PROPERTY MARKER  
(AS NOTED) ○

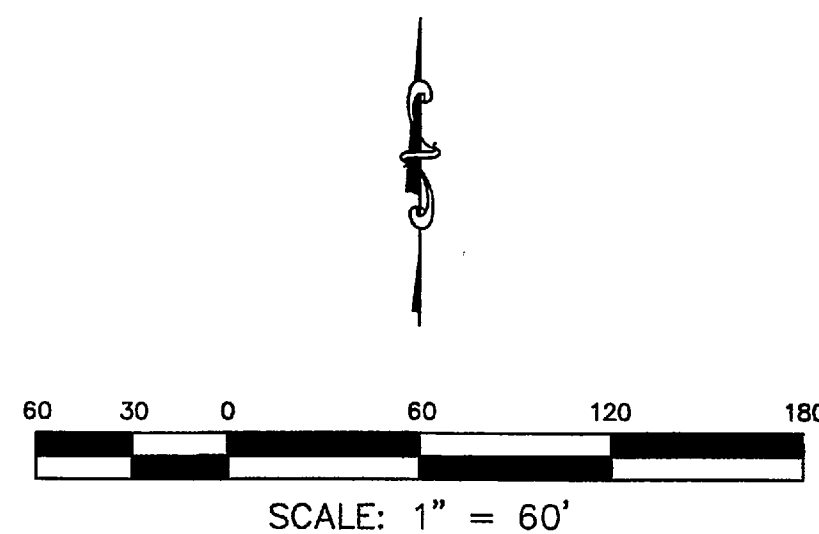

**HILL & ARGYLE, Inc.**  
Engineering and Surveying  
181 North 200 West, Suite #4, Bountiful, Utah 84010  
(801) 298-2236 Phone, (801) 298-5985 Fax

SURVEY REQUESTED BY  
**KENT WINEGAR**

THE EAST LINE OF A PARCEL  
LOCATED IN THE NE 1/4 OF SECTION 16, T.6N., R.2E., S.L.B.&M.  
HUNTSVILLE CITY, WEBER COUNTY, UTAH

DRAWN BY	JRC	DATE	04/29/15
APPROVED	VRH	DATE	XX/XX/XX
REV.	BY	DATE	

SHEET 1 OF 1

SHEET NAME  
BOUNDARY

DRAWING NAME  
BOUNDARY

PROJECT NO.  
15-184

