
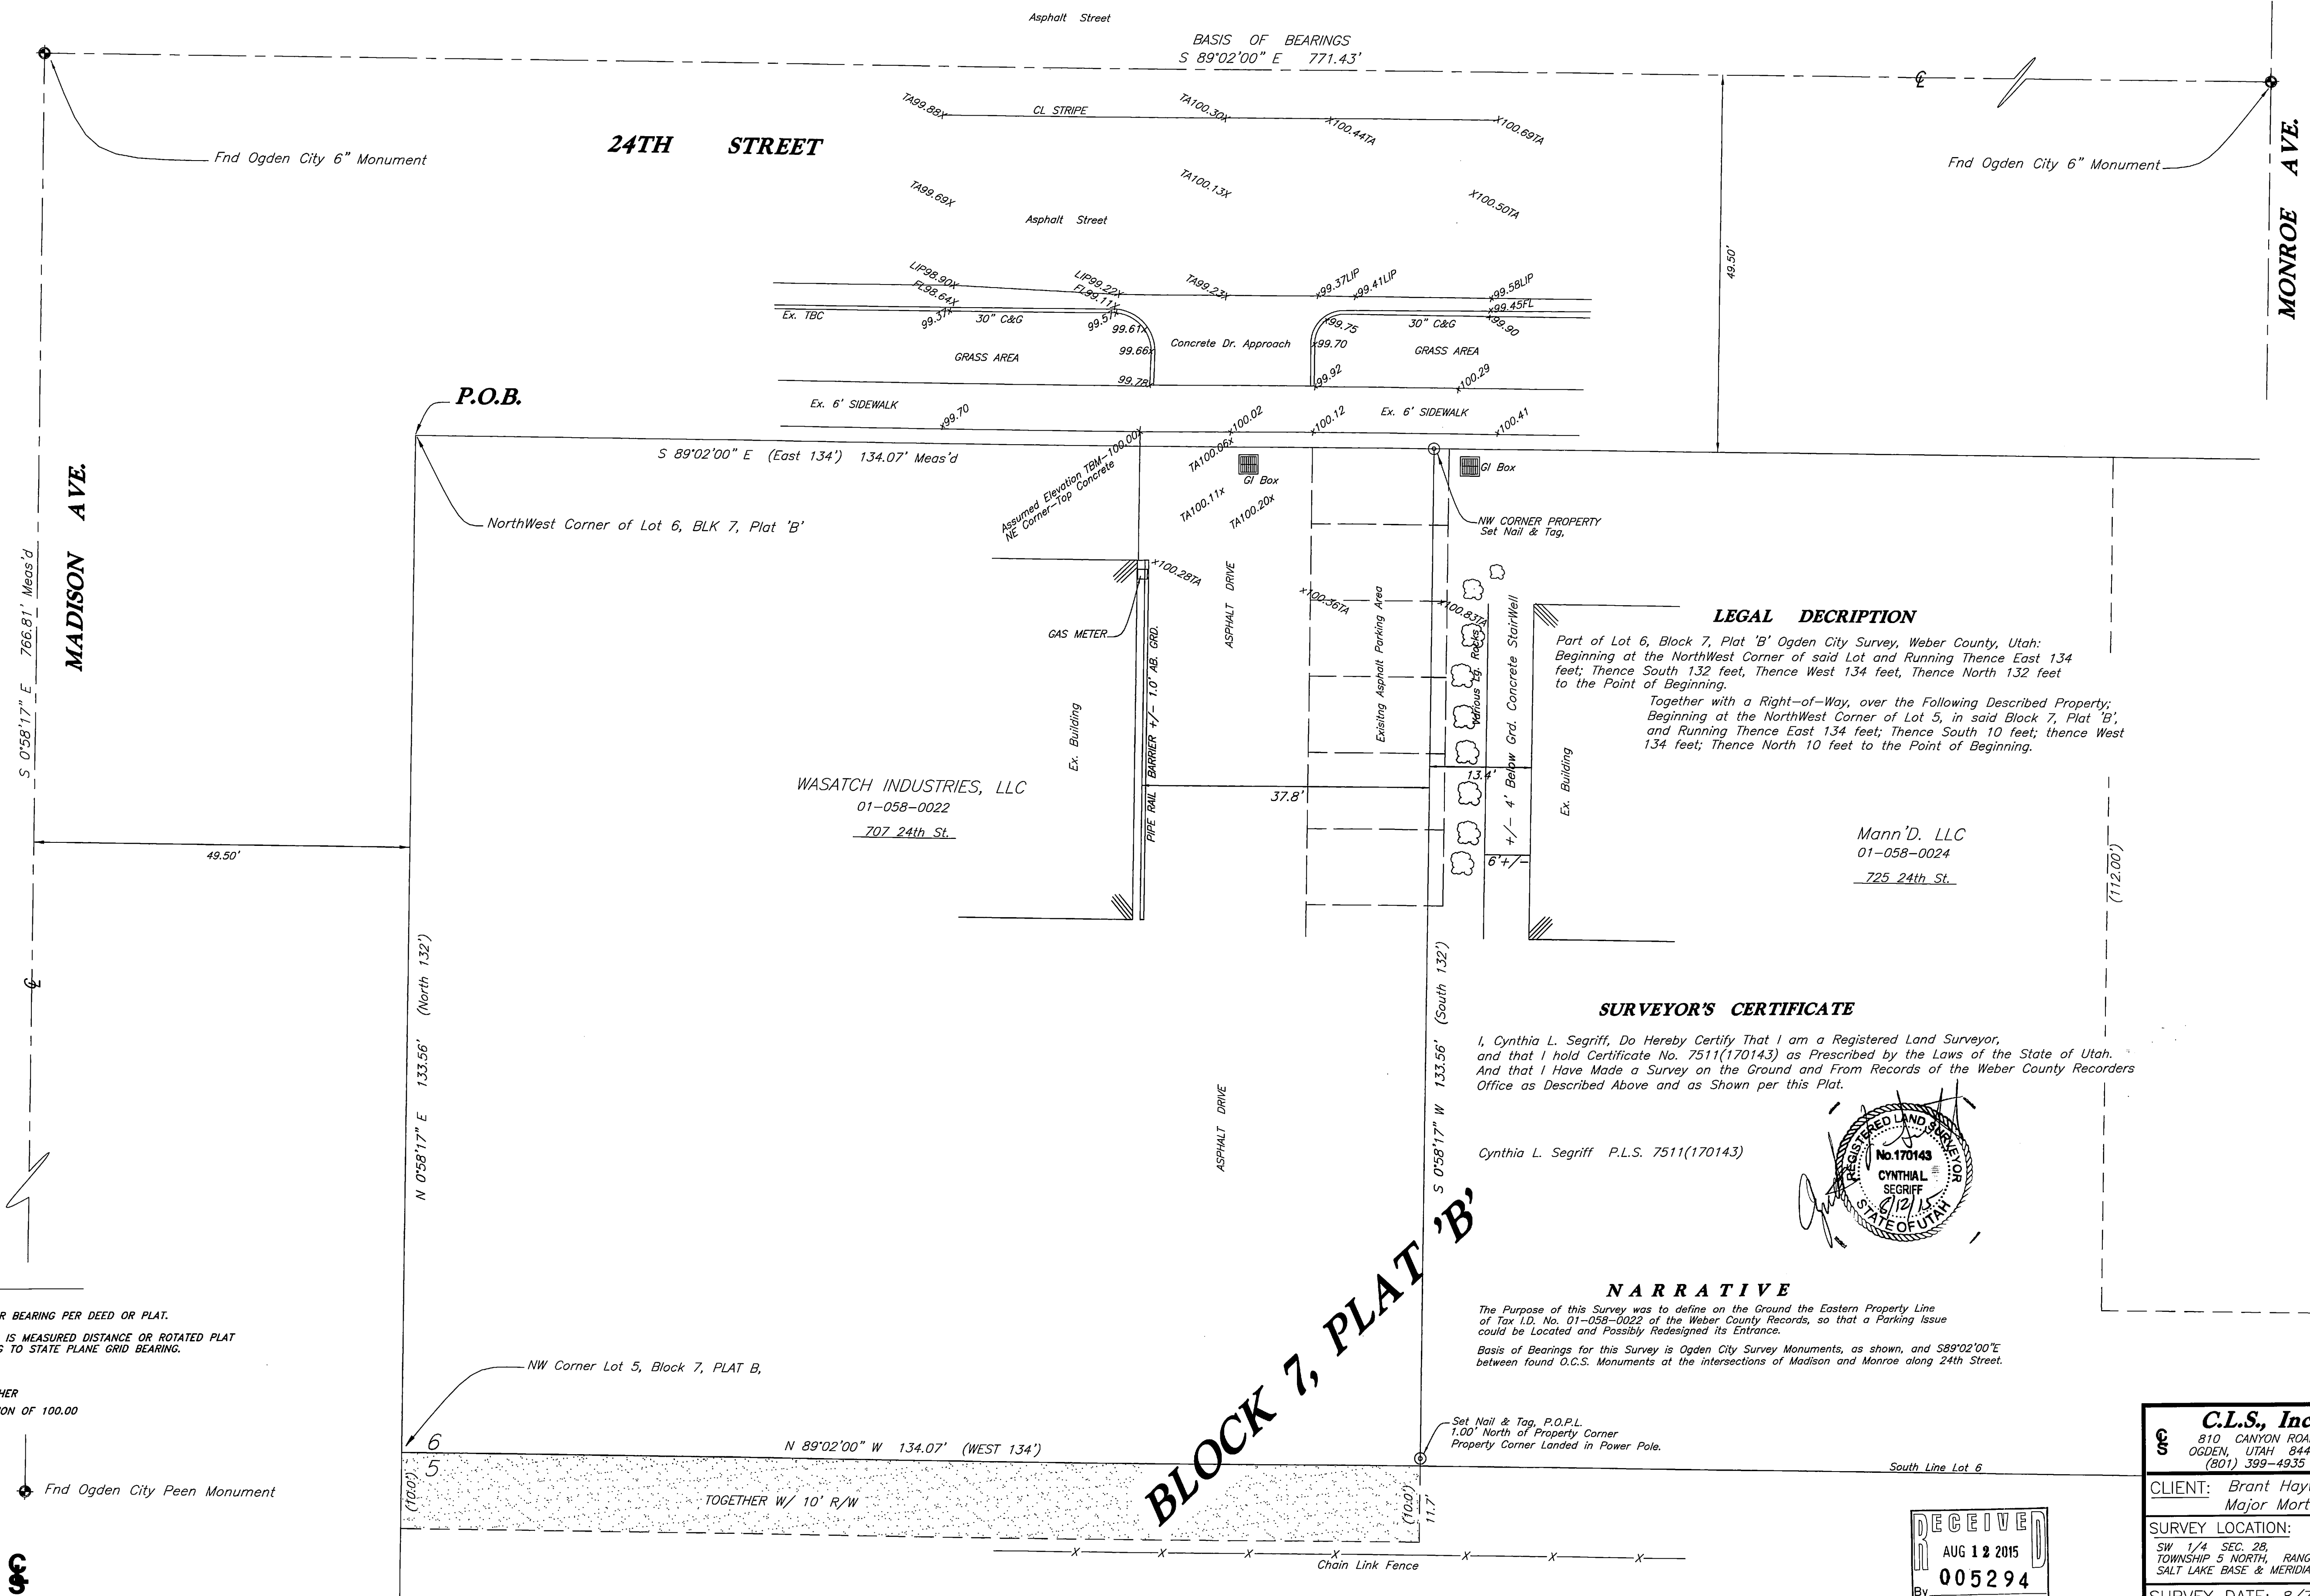


CERTIFICATION OF SURVEY

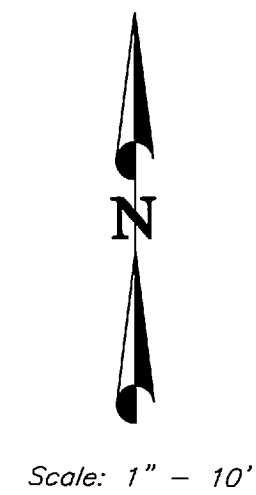

PREPARED BY:
C. L. S. Inc.
810 CANYON ROAD
OGDEN, UTAH 84404
Ph. (801) 399-4935 cls@clsurveying.net

RECEIVED
AUG 12 2015
005294

C.L.S., Inc.	
810 CANYON ROAD OGDEN, UTAH 84404 (801) 399-4935	
CLIENT:	Brant Hayward Major Mortgage
SURVEY LOCATION:	SW 1/4 SEC. 28, TOWNSHIP 5 NORTH, RANGE 2 WEST, SALT LAKE BASE & MERIDIAN
SURVEY DATE:	8/7/15
JOB No.	PS15-11