LEGEND

ENSIGN ENG. LAND SURV.

SECTION CORNER

EXIST REBAR AND CAP

MONUMENT

CONCRETE

---- ADJACENT RIGHT OF WAY

ADJACENT PROPERTY LINE

RIGHT OF WAY

____ CENTERLINE


---- DEED LINE


----X ----- FENCE

- - - TANGENT LINE

PROPERTY LINE

BUILDING PRIMARY

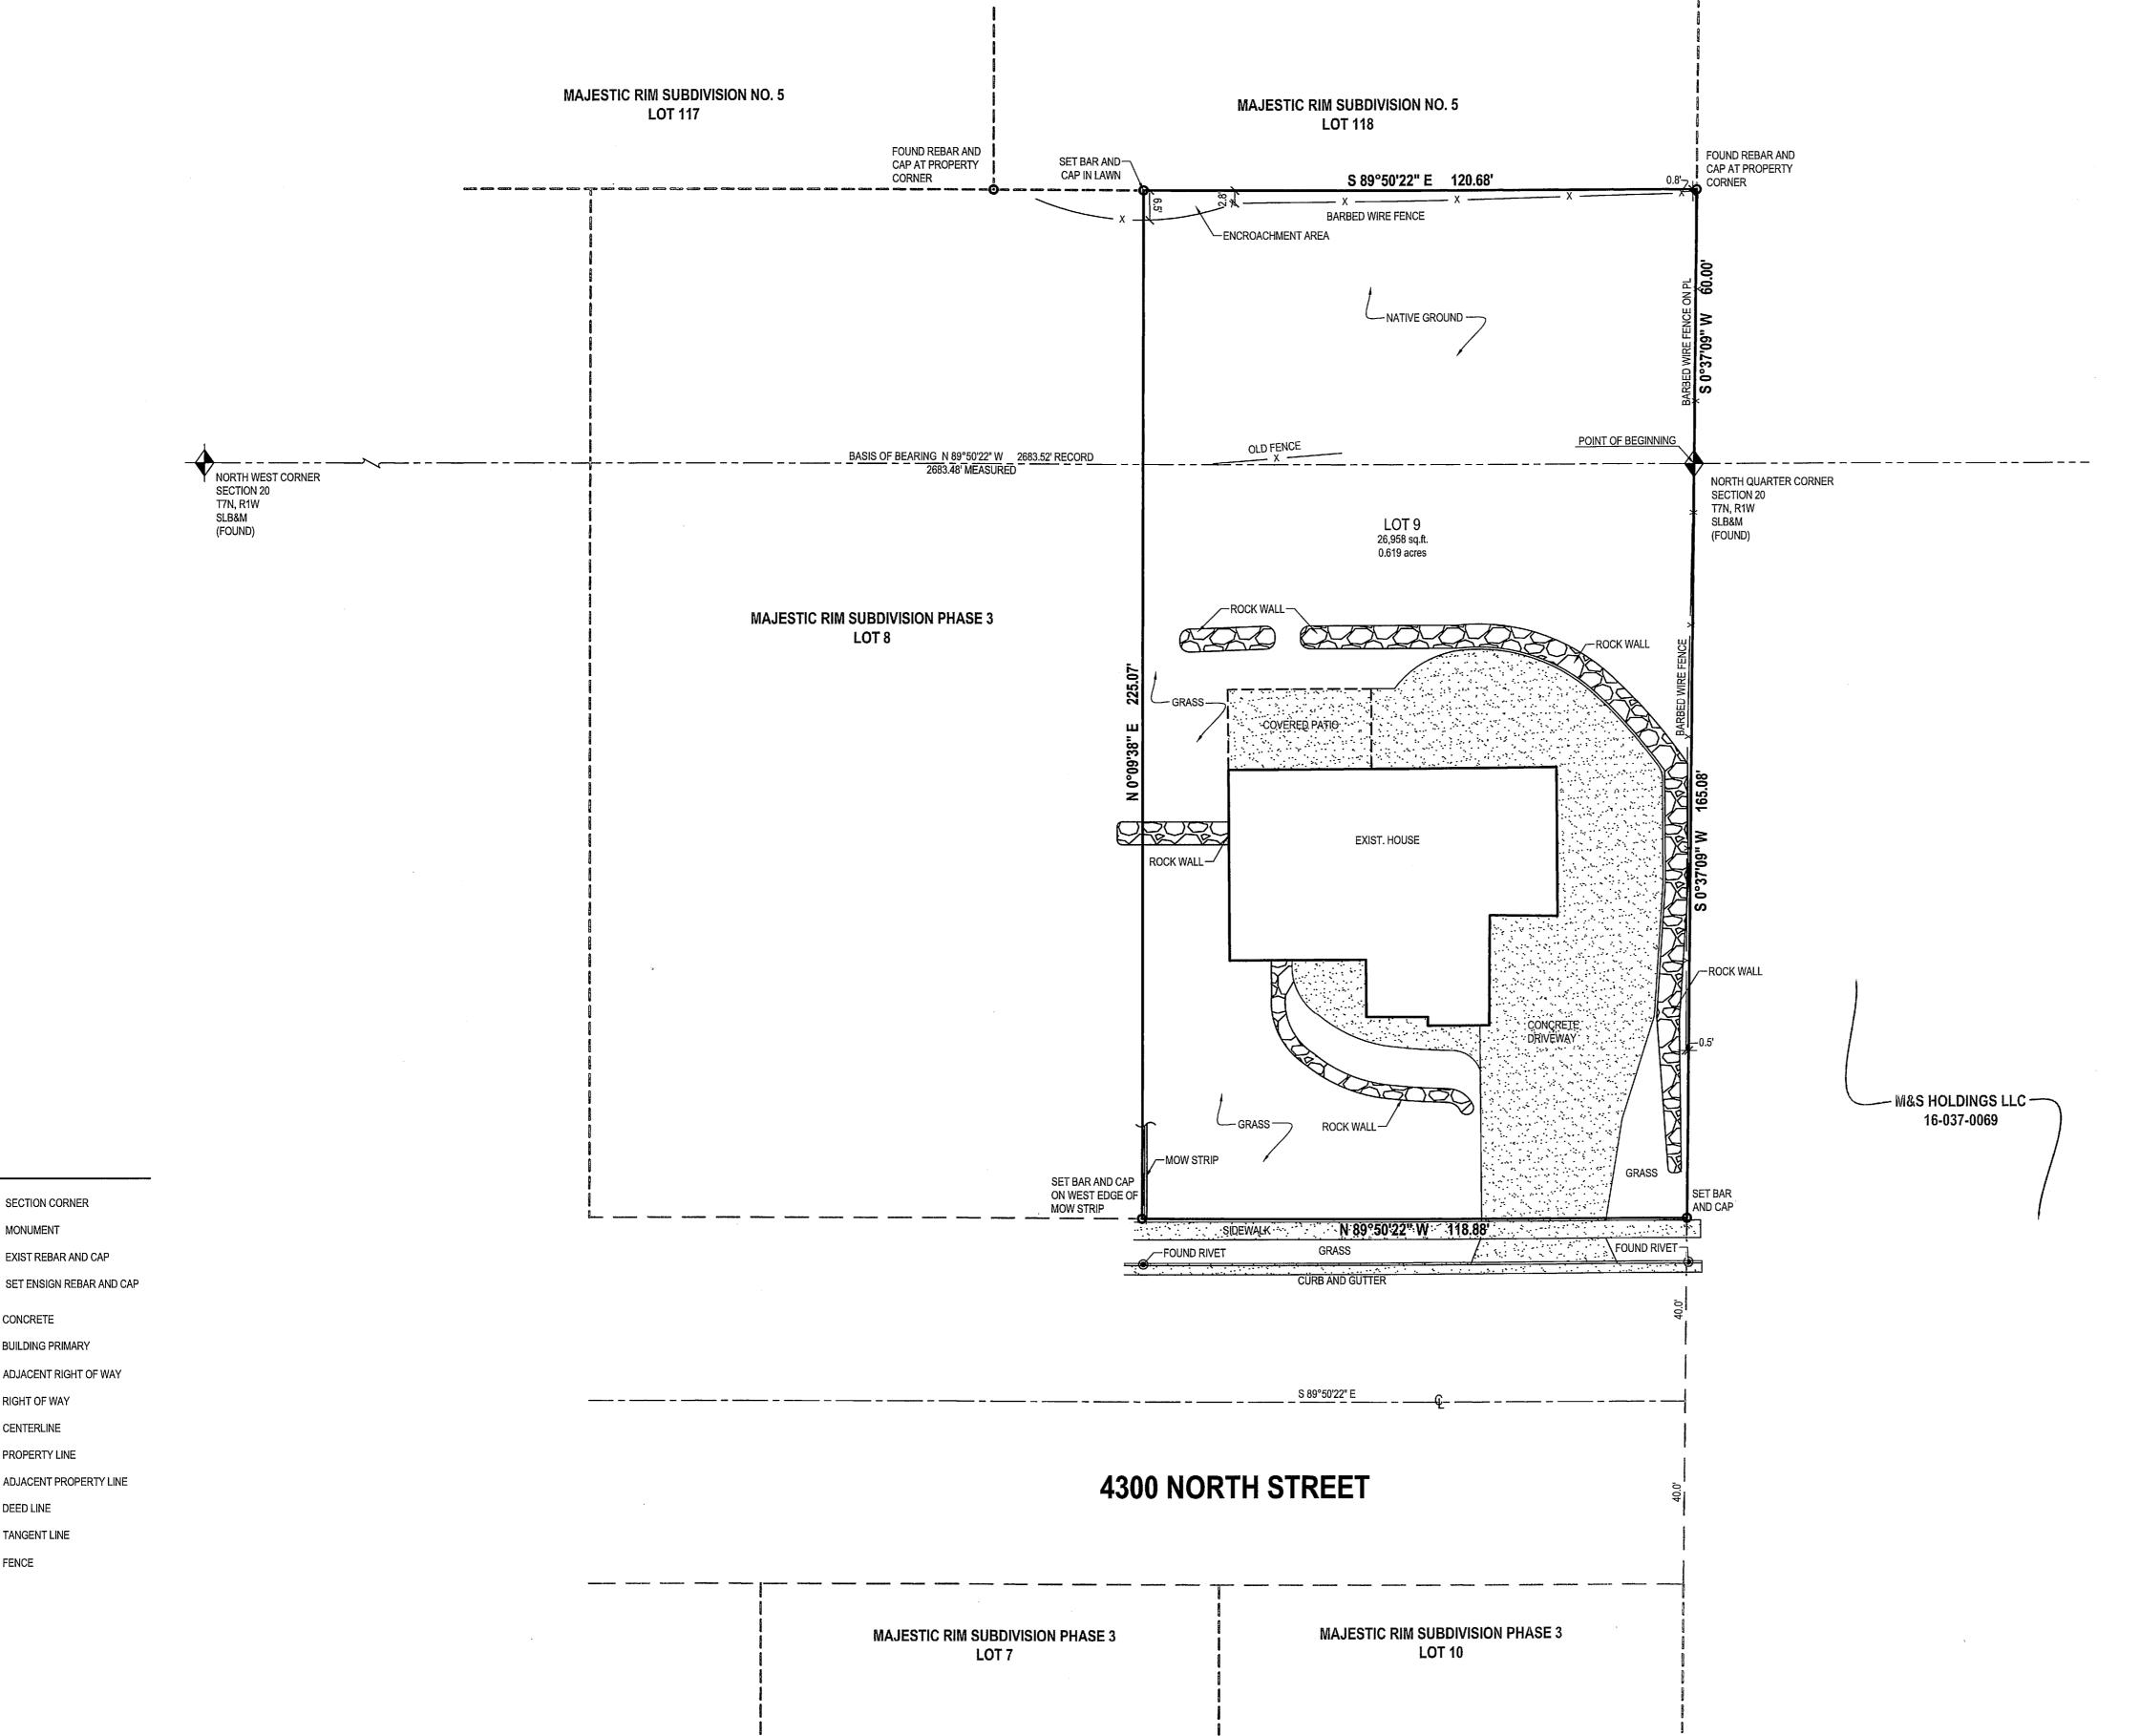

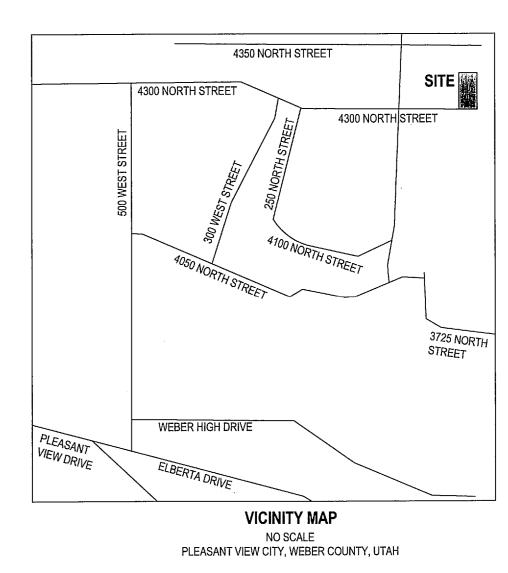

SURVEYOR'S CERTIFICATE

I, Keith R. Russell, do hereby represent that I am a Professional Land Surveyor and that I hold Certificate no. 164386 as prescribed by the laws of the State of Utah and I have made a survey of the following described property. The purpose of this survey is to define the boundary of the property based upon the recorded subdivision plat, set the corners to define the property on the ground and prepare this map of survey.

The Basis of Bearing is as noted from found Weber County Section Corners, (North Quarter of Section 20 to Northwest Corner of Section 20, Township 7 North, Range 1 West, Salt Lake Base and

Deed Description

All of Lot 9, Majestic Rim Subdivision Phase 3 according to the official plat recorded in the office of the Weber County Recorder.

Date: August 17, 2015

License no. 164386



HORIZONTAL GRAPHIC SCALE

(IN FEET) HORZ: 1 inch = 20 ft.

DEC 1 1 2015



LAYTON 1485 W. Hill Field Rd., Ste. 204

Layton, UT 84041 Phone: 801.547.1100 **SALT LAKE CITY**

Phone: 801.255.0529 **TOOELE** Phone: 435.843.3590

CEDAR CITY Phone: 435.865.1453

RICHFIELD Phone: 435.896.2983

WWW.ENSIGNENG.COM

FOR: TRENT SANDERS 3908 MITCHELL COVE ROUND ROCK, TEXAS 78681


CONTACT: TRENT SANDERS PHONE: 512-586-7072

0

SUBDIVISON LOT

MAJESTIC RIM

ET 4300 NORTH ANT VIEW, UTAH 102 WE PLEASA

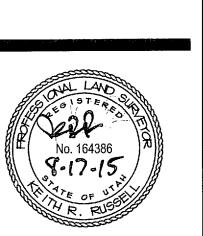

BOUNDARY SURVEY

DRAWN BY A.SHELBY PROJECT MANAGER K.RUSSELL

1 of 1