


PLAN HOLD CORPORATION - IRVINE, CALIFORNIA
REGISTERED BY NUMBER 02548
REGISTERED BY NUMBER 02548
REGISTERED BY NUMBER 02548

5900 WEST STREET

BASIS OF BEARINGS N 0° 42' 55" E 2640.14'


WEST 1/4 CORNER SECTION 6,
WEBER COUNTY SURVEYORS
BRASS CAP NO. 131637.

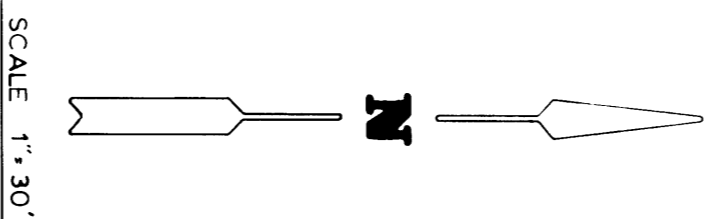

1400

NORTH


ST

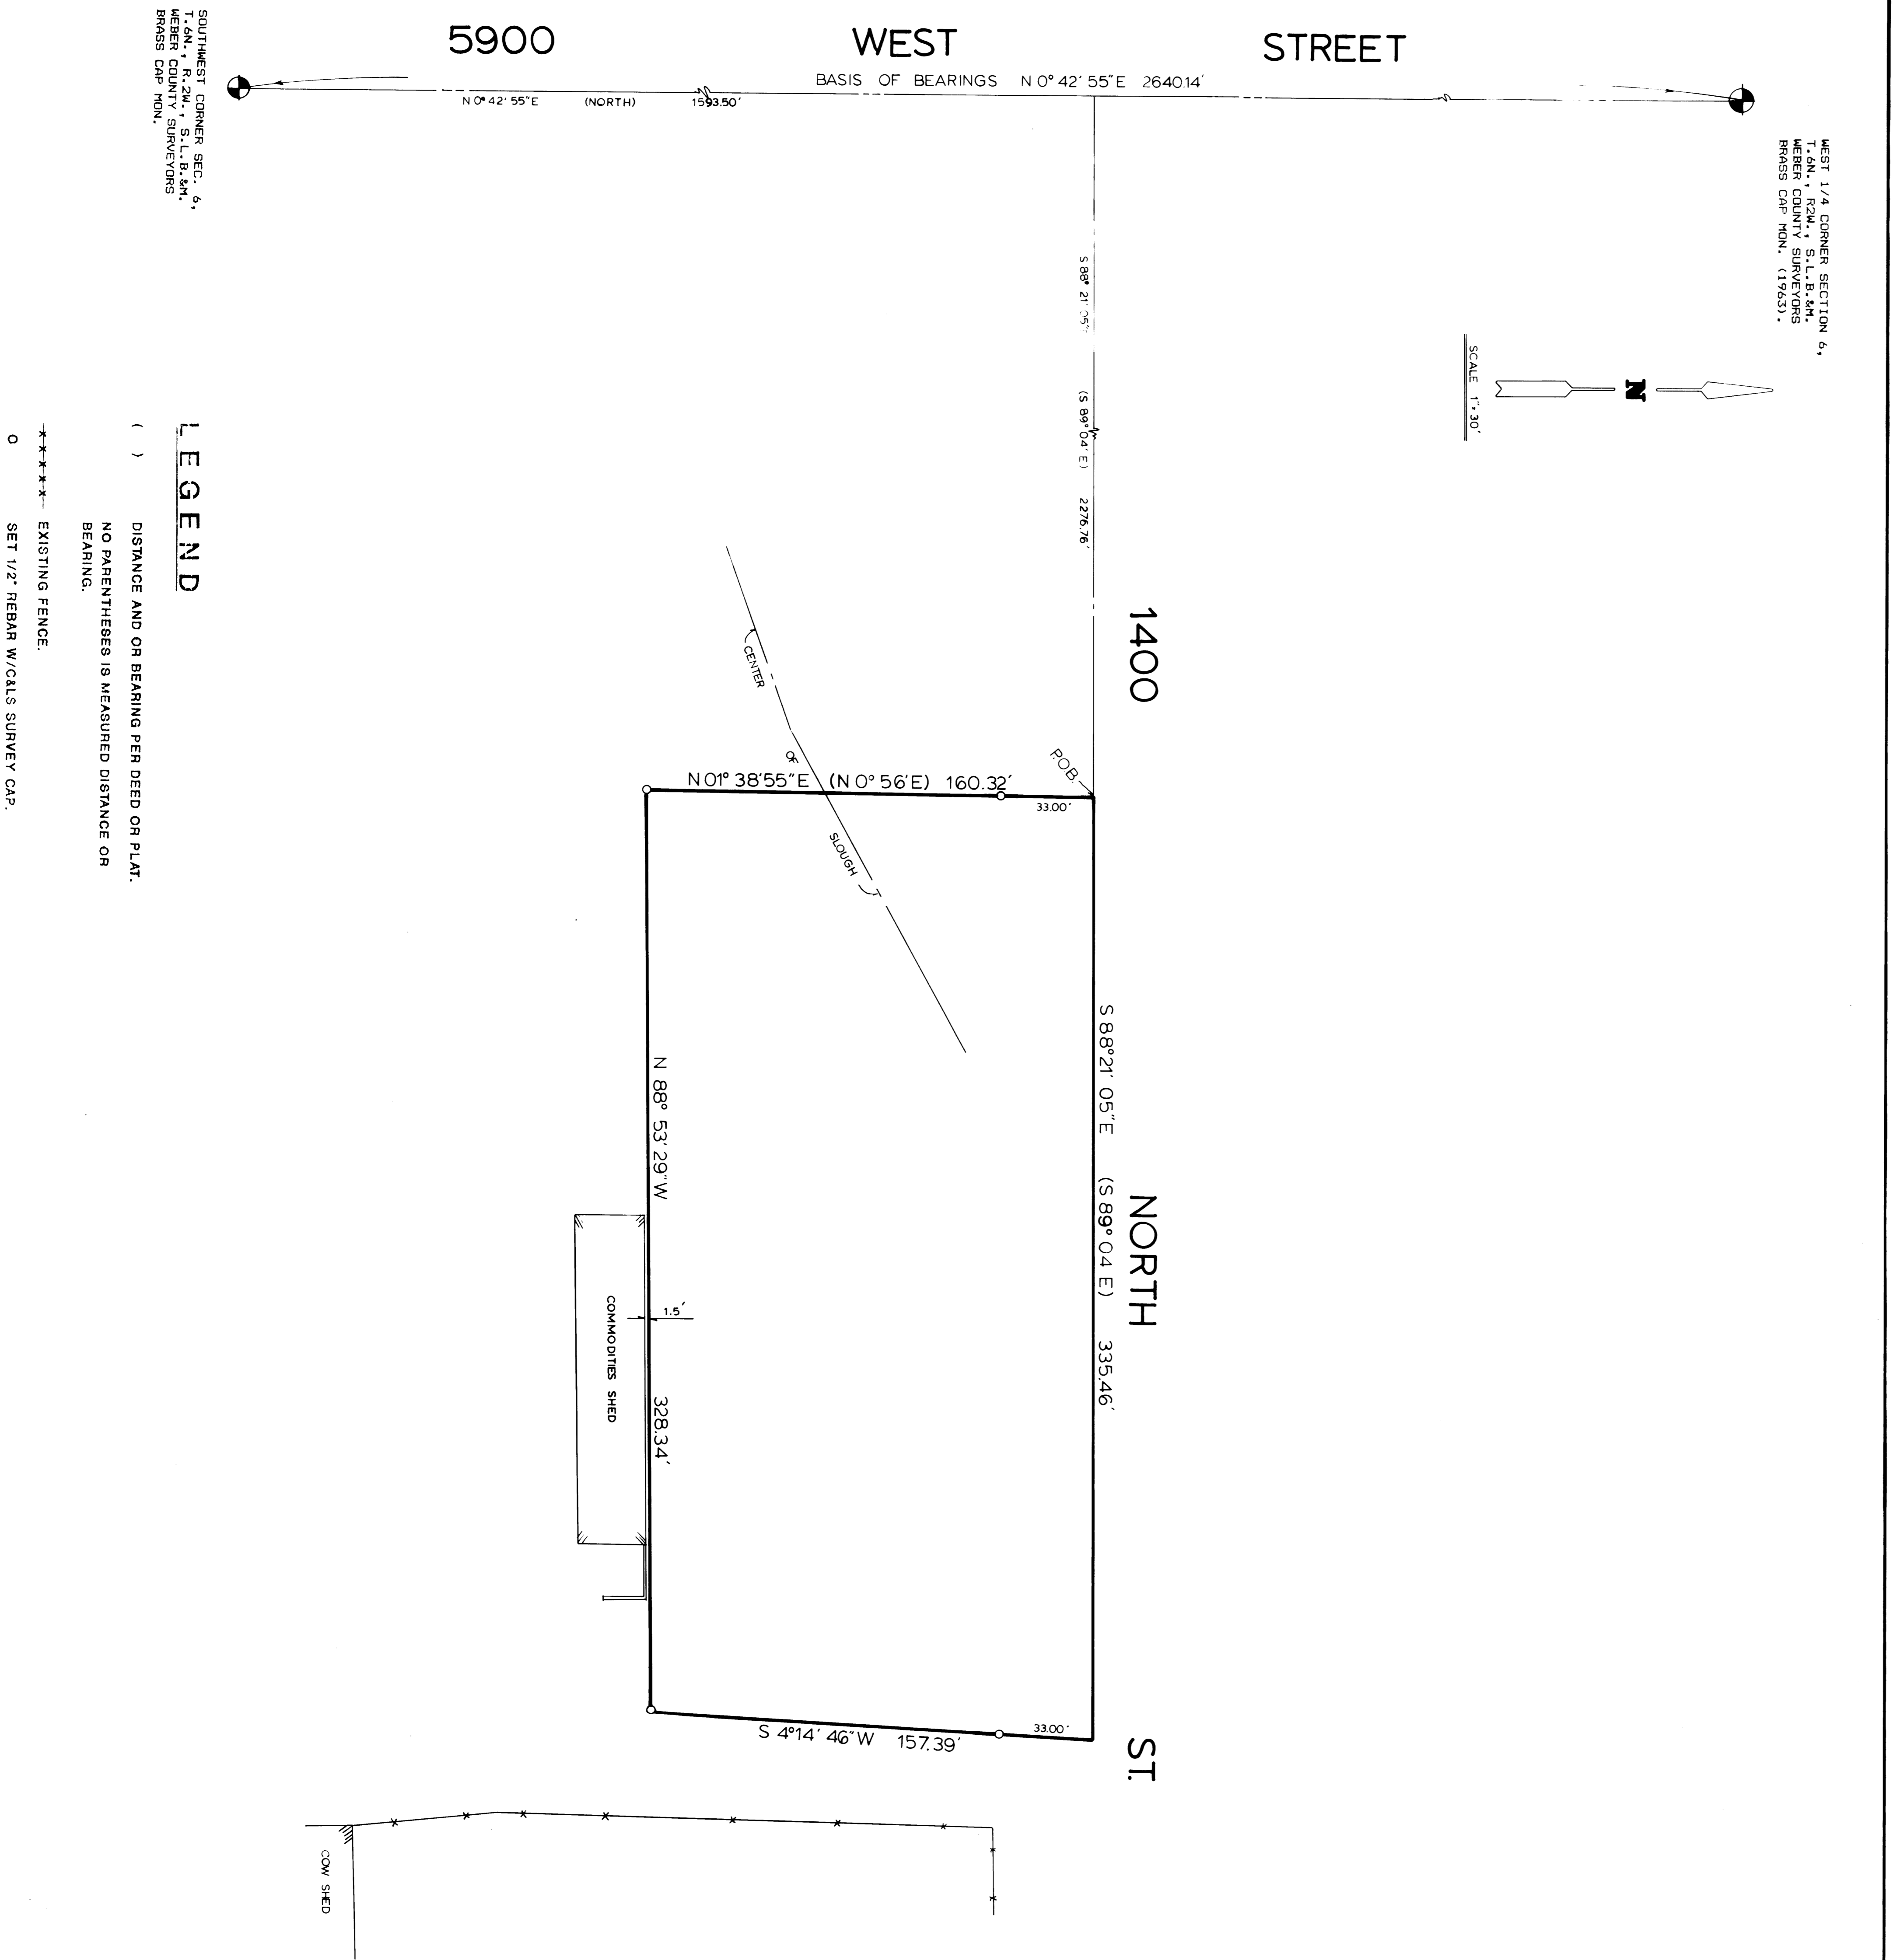

LEGEND
() DISTANCE AND OR BEARING PER DEED OR PLAT.
NO PARENTHESES IS MEASURED DISTANCE OR BEARING.
***** EXISTING FENCE.
0 SET 1/2" REBAR W/CALLS SURVEY CAP.

SURVEYOR'S CERTIFICATE


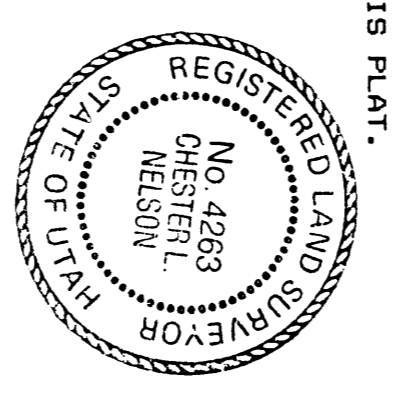

CHESTER L. NELSON
DATE 1-10-91

NARRATIVE


LEGAL DESCRIPTION



537
RECEIVED
MAY 24 1991

Webber County Surveyors

CONSTRUCTION & LAND SURVEYORS INC. 2751 WASHINGTON BLVD. OGDEN UTAH 84401 (801) 398-4838	CLIENT: BLAINE WADE
SURVEY LOCATION: SOUTHWEST QUARTER SECTION 6, TOWNSHIP 6 NORTH, RANGE 2 WEST, SALT LAKE BASIN & MENDIAN.	
SURVEY DATE: 1-10-91	