

NARRATIVE:
 Boundary Consultants was retained by Mike Carroll to survey the subject parcel and monument the corners thereof.
 This survey was carried out using a Trimble S6 Total Station and a Trimble 5800 GPS System, with ground distances being determined by GEOD Model CONUS 128 @ height 4441.065 feet and no calibration. Basis of Bearing for this survey is Geodetic North as determined by GPS.
 The historic monumentation along 2600 North Street is missing, at some time in the past 26 years 2600 North has been reconstructed and the monumentation was not perpetuated. We have depicted the location of said center line using Record of Survey #0345 placed over the retraced boundary of the subject parcel. With the historic center line monumentation missing at the street intersections around the block, we located the extant street improvements and then set a preliminary center line using the split of those improvements. Preliminary Block lines were set from those center lines then compared to occupation lines around the block. We determined that this method has yielded a reliable location for the street center lines and block lines and have held to our measured locations as the correct lines. Two monuments were found at street intersections of 2550 North Street and the intersections of 675 East and 525 East Streets, we have held these monuments as the true center line of said 2550 North Street.


DESCRIPTION:
WARRANTY DEED: ENTRY #2760225:
 Part of Lot 8, Block 2, Plat "A", North Ogden Survey, Weber County, Utah: Beginning at the Northeast corner of said Lot running thence South 00°15'00" West 120.62 feet, thence North 86°29'00" West 100.41 feet, thence North 00°15'00" East 114.62 feet, thence EAST 100 feet to beginning.
AS SURVEYED DESCRIPTION:
 Part of Lot 8, Block 2, Plat "A", North Ogden Survey, Weber County, Utah: Beginning at the Northeast corner of said Lot running thence South 00°15'00" West 120.62 feet (S00°50'04"W 120.62 feet, measured); thence North 86°29'00" West 100.41 feet (N85°56'57"W 100.76 feet, measured); thence North 00°15'00" East 114.62 feet (N00°59'09"E 114.62 feet, measured); thence EAST 100 feet (N89°21'50"E 100.30 feet, measured) to beginning.

RECEIVED
 MAY 24 2016
 BY: 5465

SCALE OF FEET
 0 30 60

LEGEND

- ROAD CENTER LINE & FOUND P.I. MONUMENT
- BOUNDARY LINE
- RIGHT OF WAY LINES
- RECORD OF SURVEY
- ADJOINING PARCELS DEED LINES
- ROOT LOT LINES
- DIMENSION LINES
- CEDAR FENCE INSTALLED IN CONCRETE CURB
- ASBUILT CURB AND GUTTER

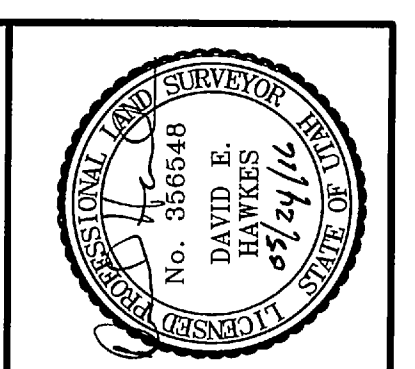

DATE: 05-24-16
 SCALE: 1" = 30'
 SHEET: 1615001

RECORD OF SURVEY OF
TAX PARCEL 18-003-0009
JODI WILLIAMS - MIKE CARROLL
 LYING AND SITUATE IN THE NORTHWEST QUARTER OF SECTION 33,
 TOWNSHIP 7 NORTH, RANGE 1 WEST, SALT LAKE BASE AND MERIDIAN

Boundary Consultants
 Professional Land Surveyors
 1295 North 1700 West, Farr West, Utah
 801-792-1569 801-690-7158 FAX

DESIGNED	DEH	DEH	DEH
DRAWN	DEH	DEH	DEH
CHECKED	DEH	DEH	DEH
SHEET	1		
OF	1		